



03.0002/CAC

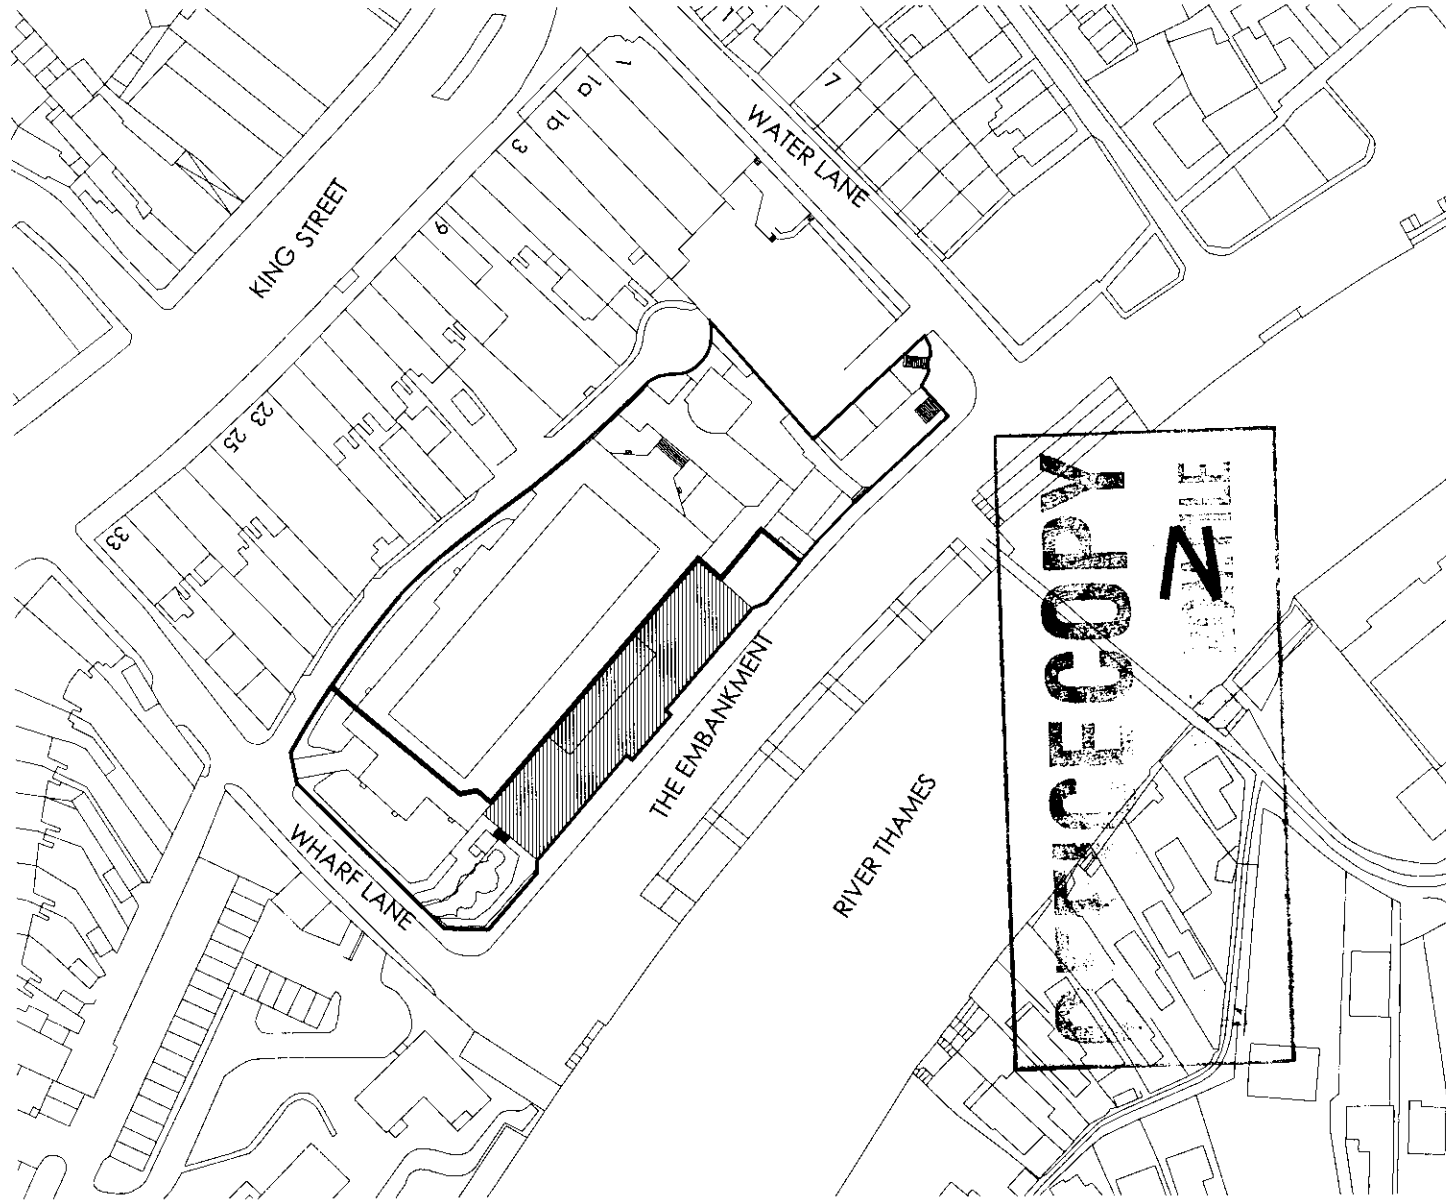

LOCATION PLAN SCALE 1:1250

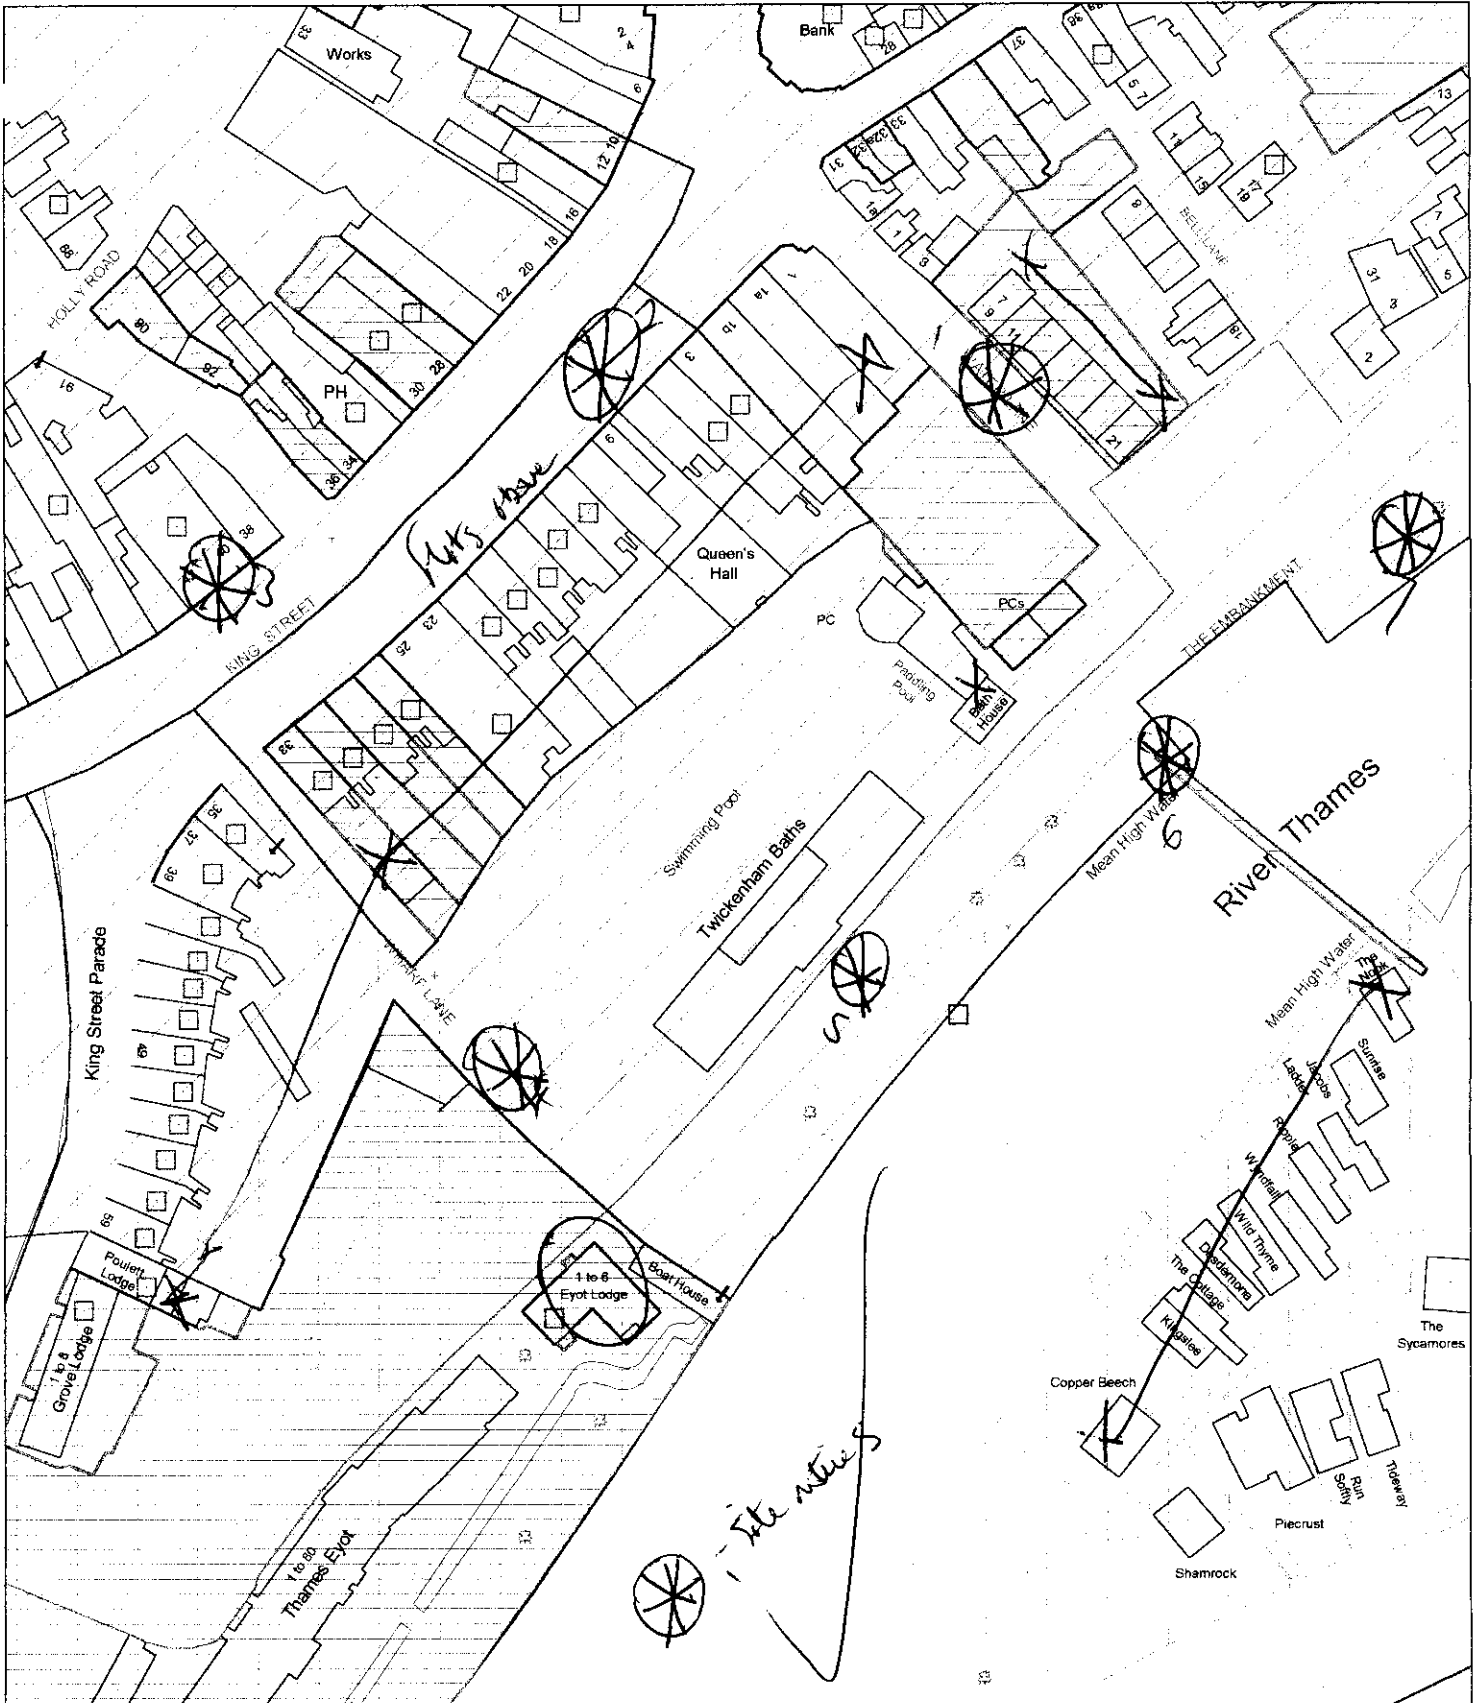

R LONDON BOROUGH OF
RICHMOND UPON THAMES
 Environment & Sustainability Directorate

**Ordnance Survey
 Map Extract**

Reproduced from the
 Ordnance Survey
 1:1250 mapping with
 the permission of Her
 Majesty's Stationery
 Office (c) Crown
 Copyright. Unauthorised
 reproduction infringes
 Crown Copyright & may
 lead to prosecution or
 civil proceedings.
 LA086533.

CIVIC CENTRE 44 YORK STREET
 TWICKENHAM TW1 3BZ
 TEL:020 8891 1411 FAX:020 8891 7702
 www.richmond.gov.uk

Co-ordinates at centre of map:
 Easting: 516279 Northing: 173151

Scale 1: 1250	Date 10/04/03	Section	Drawn
------------------	------------------	---------	-------

Head of



Produced using Datamap, the directorate's
 Geographic Information System (GIS).

Handwritten note: + the above is on 01/25/04 P.T.O. for other addresses to

Send letter to

~~Coordinator of Wickham Society Group,~~

TW1 3EA

- ① ~~KARMAN, Mr. J. Betteridge, 14 Aquarius, East Pie Island, W~~
- ② ~~TRTGS, Mr. M. Stearns, 20, South Road, Wickham, TW2 5UU~~

① Mr. J. Betteridge

Coordinator of the Wickham Society Group, representing Wickham
Amenity Societies.



~~John O'Connell
GOC - B.S. King.~~

~~representing the Amenity Societies,~~