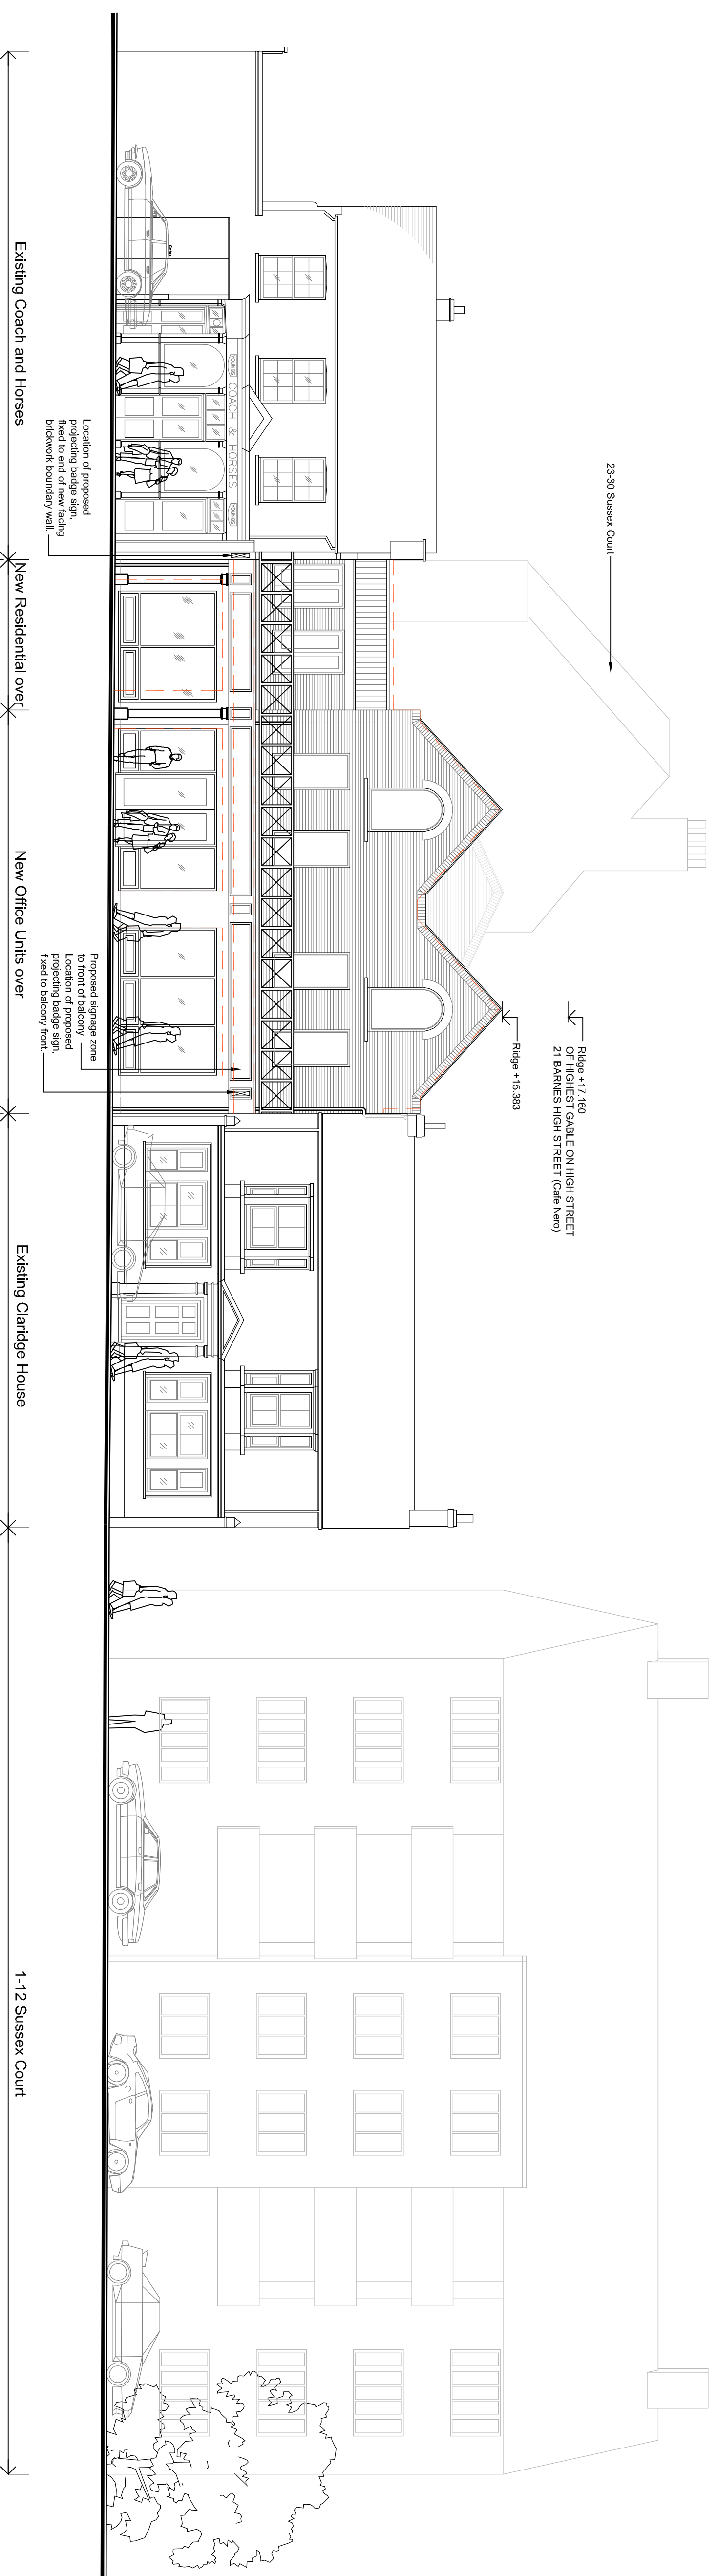
**NOTES.**

1. THIS DRAWING IS BASED UPON EVOLUTION ARCHITECTURE LLP PLANNING DRG. No 14-168-111. Rev:02 AND DRG. No. 14-168-112 Rev:01.

--- Mark ups of existing approval

**Front Elevation to Barnes High Street**

Rev	Date	Revisions	By	Ch'd
Drawing Status				
FOR PLANNING				
Project Title				
Aquila 28-29 Barnes High Street Richmond Upon Thames				
Drawing title				
Planning - Consent Comparison				
Front Elevation				
Sheet	Scale	Date	Drawn	Ch'd
A1	1:100	01.07.15	GG	IM
Project no				
3000				
Drawing no				
A05711				
Rev				
-				