



All discrepancies to be reported to tsp.
Do not scale this drawing. All dimensions to be checked on site.

NOTES.


1. THIS DRAWING IS BASED UPON EVOLUTION ARCHITECTURE LLP PLANNING DRG. No 14-168-114.

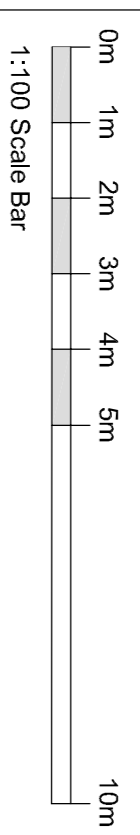

--- Mark ups of existing approval

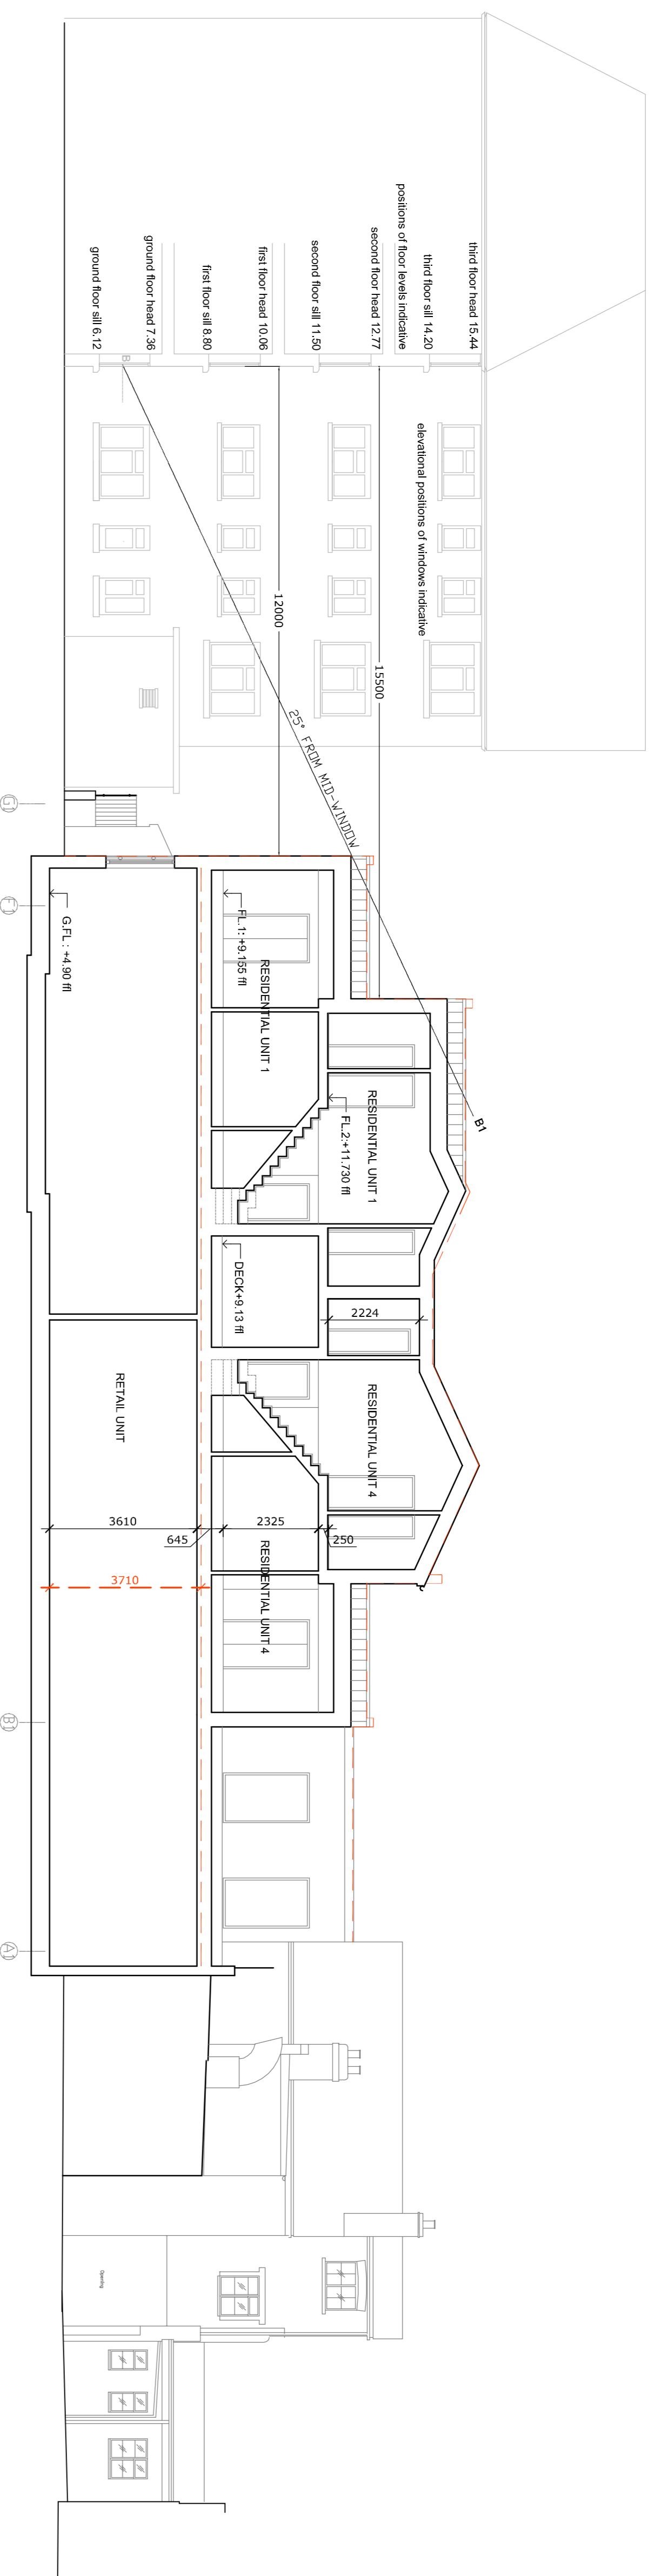

Section A-A (Showing Relationship with 1-12 Sussex Court)

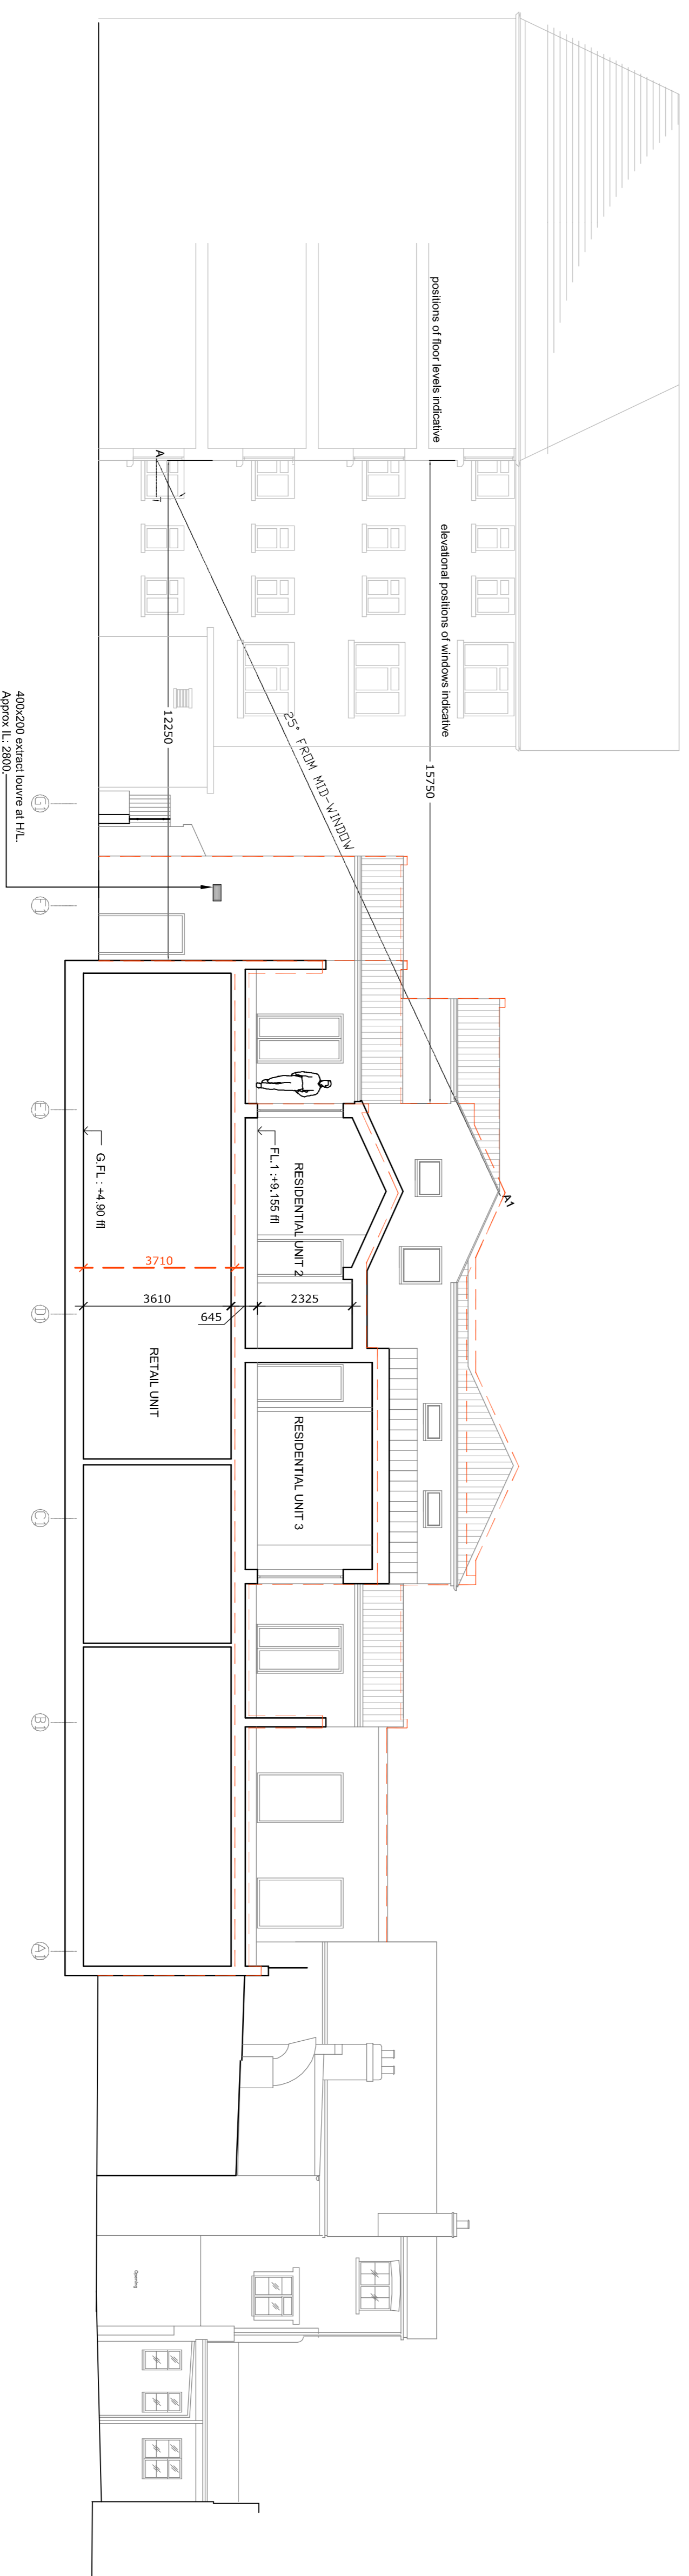

Section B-B (Showing Relationship with 13-16 Sussex Court)

Rev	Date	Revisions	By	Ch'd
-----	------	-----------	----	------

Drawing Status
FOR PLANNING

Project Title
Aquila 28-29 Barnes High Street
Richmond Upon Thames

Drawing title
Planning - Consent Comparison
Sections A-A & B-B

Sheet	Scale	Date	Drawn	Ch'd
A1	1:100	17.08.15	GG	IM

Project no	3000	Rev	-
Drawing no	A05811		

tsp ARCHITECTURE
+ DESIGN

TSP 90-98 Goswell Road London EC1V 7RD
+44 (0)20 7490 8899 www.tsp.com