




GROUND FLOOR PLAN

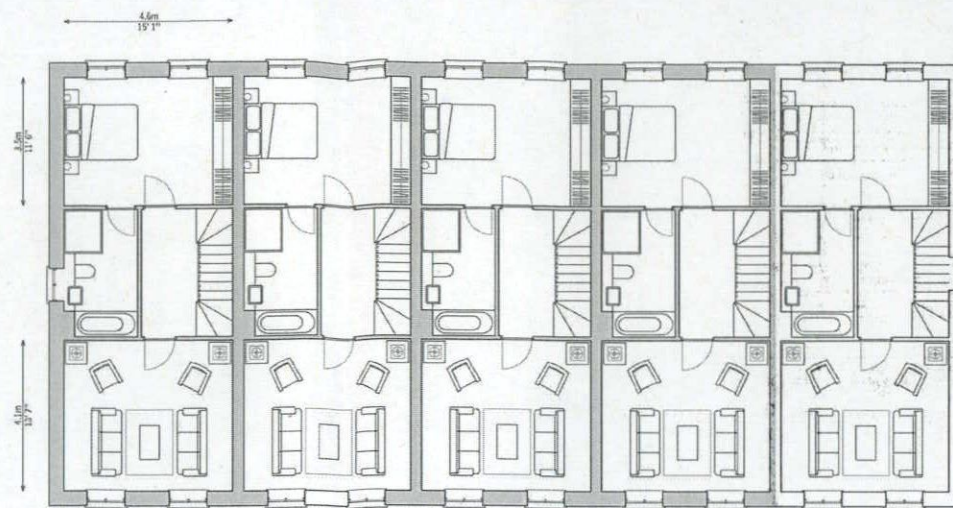


FIRST FLOOR PLAN

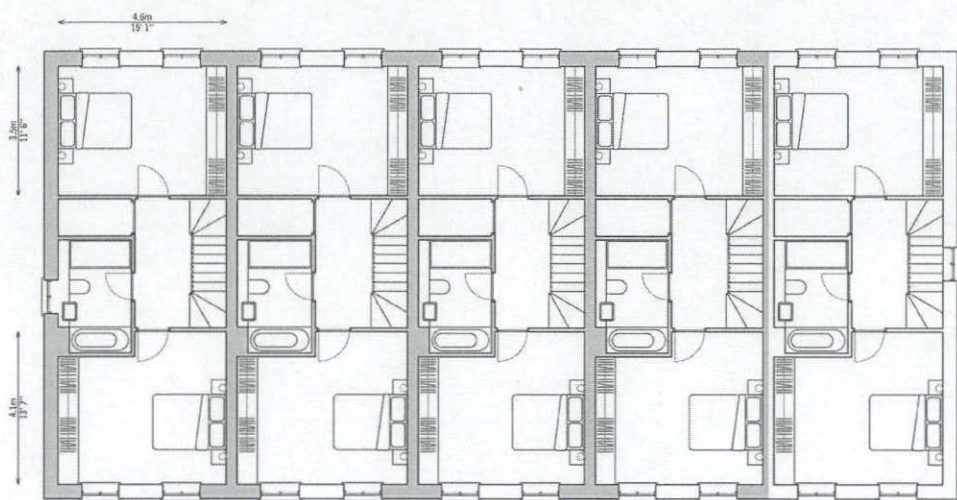

SECOND FLOOR PLAN

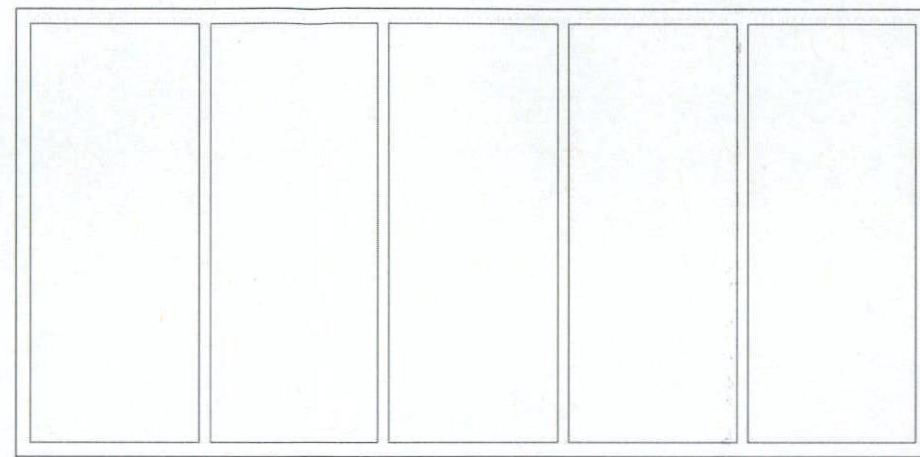


ROOF PLAN

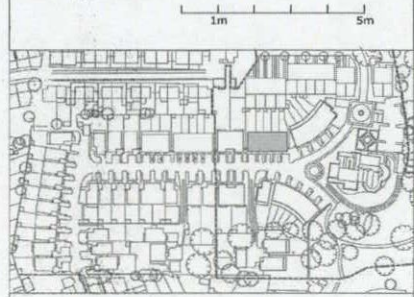


Brookes Architects mark up of agreed planning drawing submission to reflect materials to satisfy planning condition NS04



STREET ELEVATION

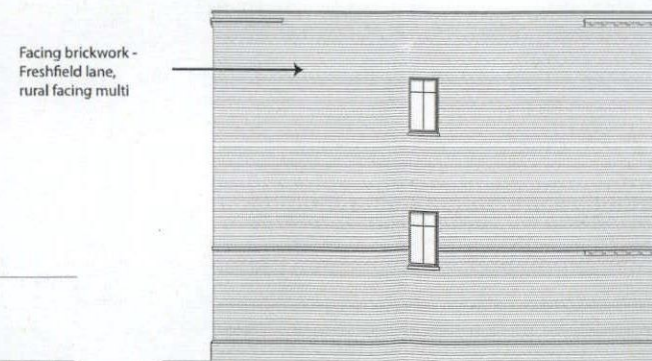


SIDE ELEVATION

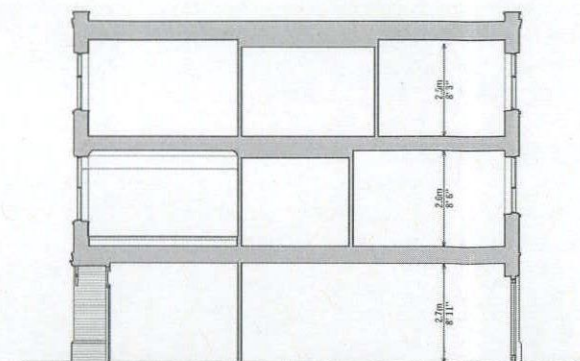

SECTION



REAR ELEVATION

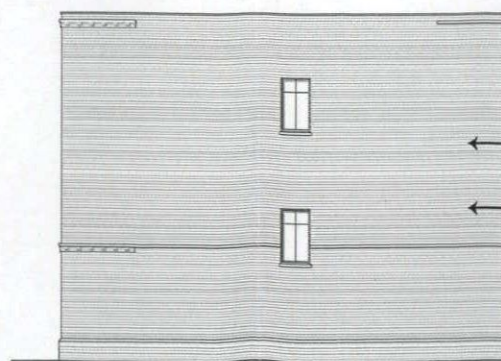

SIDE ELEVATION

LATCHMERS HOUSE	1:100 @A1 1:200 @A2 JAN 2016
PLANS, SECTIONS AND ELEVATIONS	drawing no. rev.
<b>HOUSE TYPE D1</b>	<b>BKH04-P-205 02</b>