




GROUND FLOOR PLAN

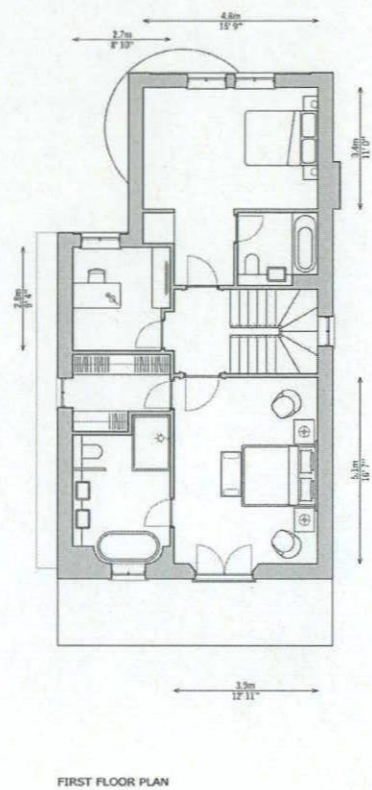


FIRST FLOOR PLAN

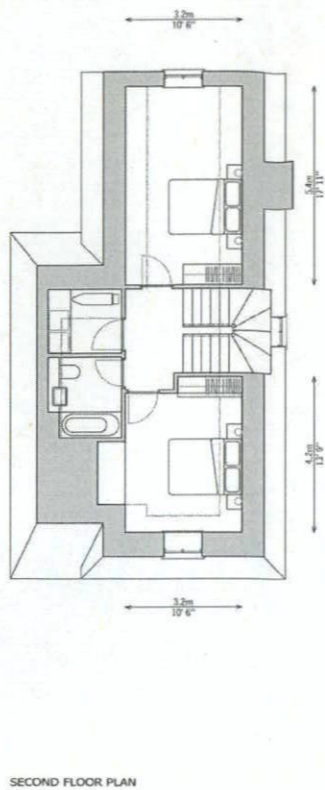

SECOND FLOOR PLAN

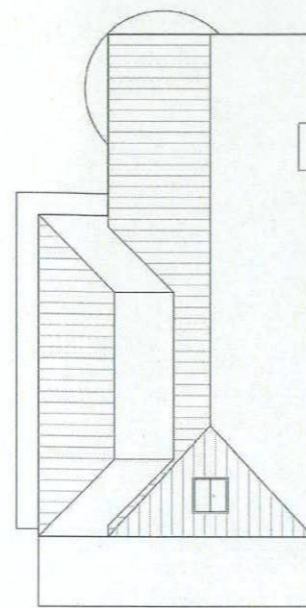

ROOF PLAN

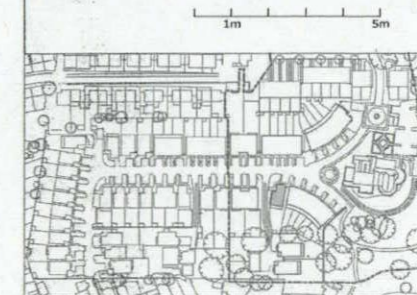

Brookes Architects mark up of agreed planning drawing submission to reflect materials to satisfy planning condition NS04

*No need. Write it in notes*




STREET ELEVATION




REAR ELEVATION




SIDE ELEVATION

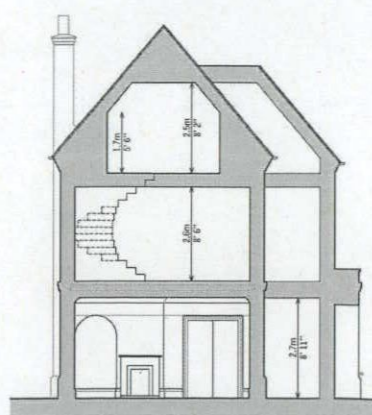

SECTION

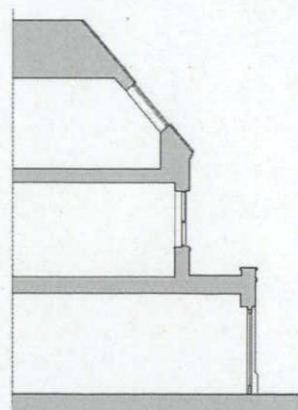

Facing brickwork - Freshfield lane, rural facing multi

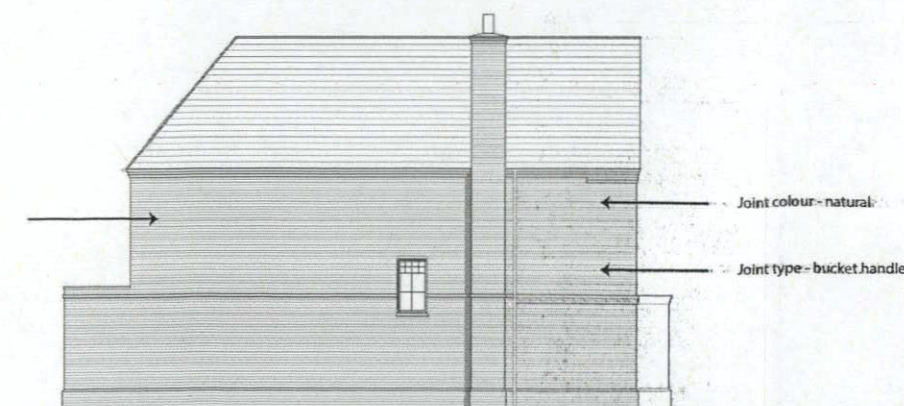

SIDE ELEVATION

LATCHMERE HOUSE	1:100 @A1 1:200 @A3
PLANS, SECTIONS AND ELEVATIONS	JAN 2016
HOUSE TYPE E1	drawing no. BKH04-P-206 02