




SECOND FLOOR PLAN

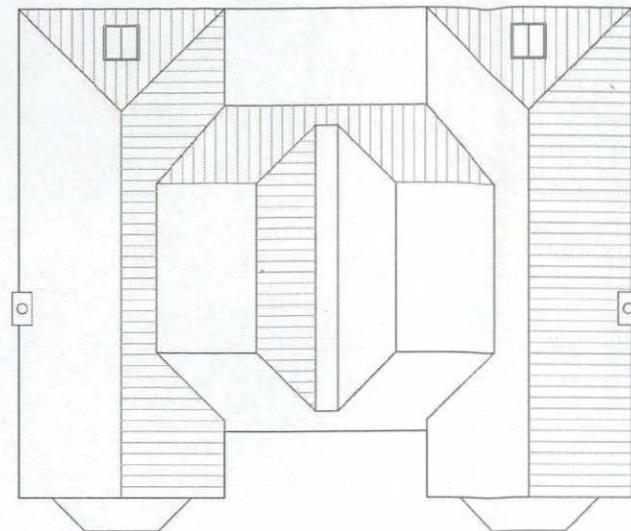


ROOF PLAN

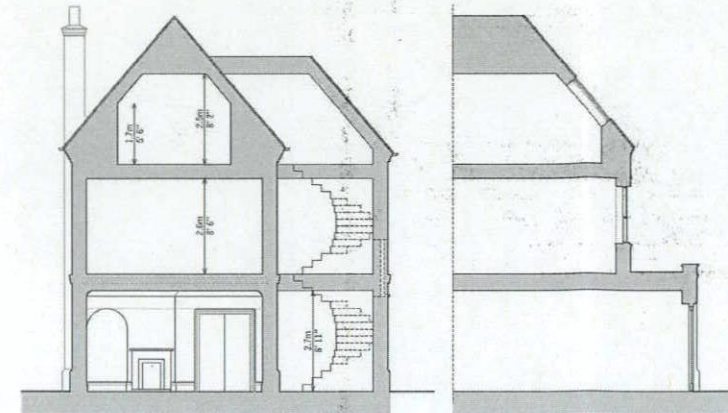


SECTION

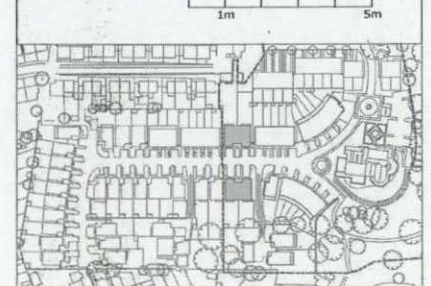


Brookes Architects mark up of agreed planning drawing submission to reflect materials to satisfy planning condition NS04

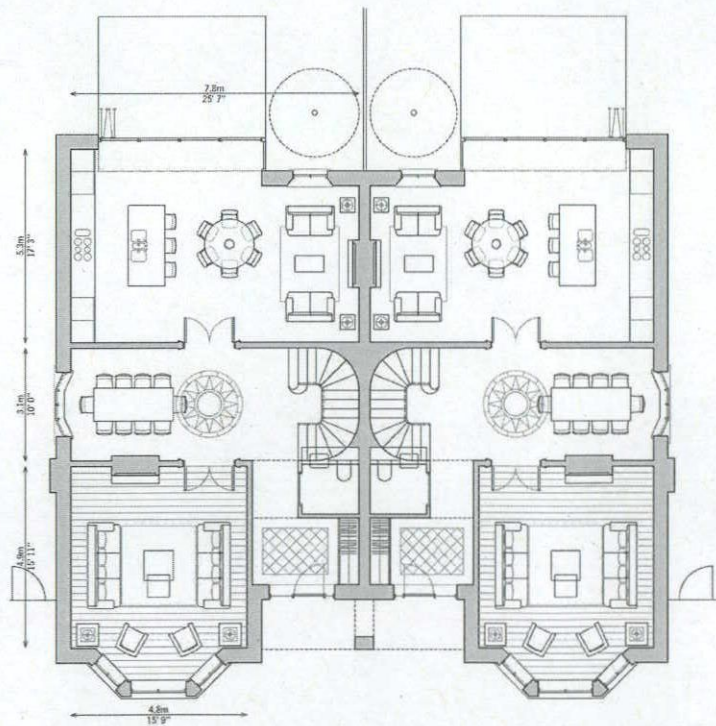

GROUND FLOOR PLAN

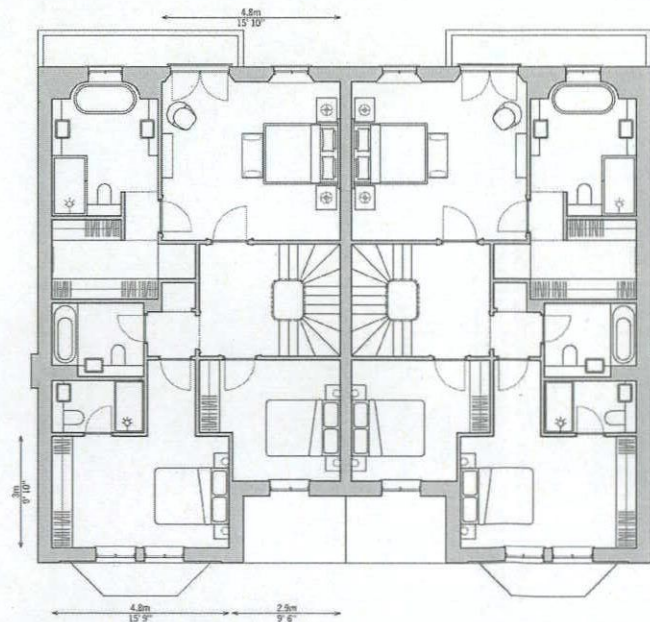

FIRST FLOOR PLAN

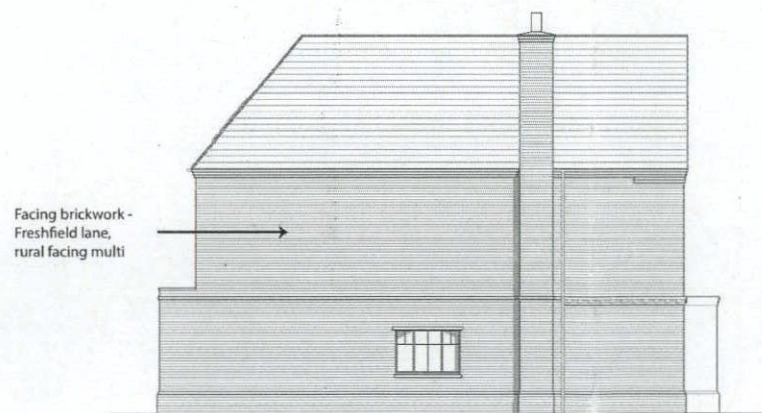

Facing brickwork - Freshfield lane, rural facing multi

SIDE ELEVATION



Windows - White finished timber


Joint colour - natural
Joint type - bucket handle
Window cils - Cast stone - portland

STREET ELEVATION



Soffits and Fascia - White finished timber

REAR ELEVATION

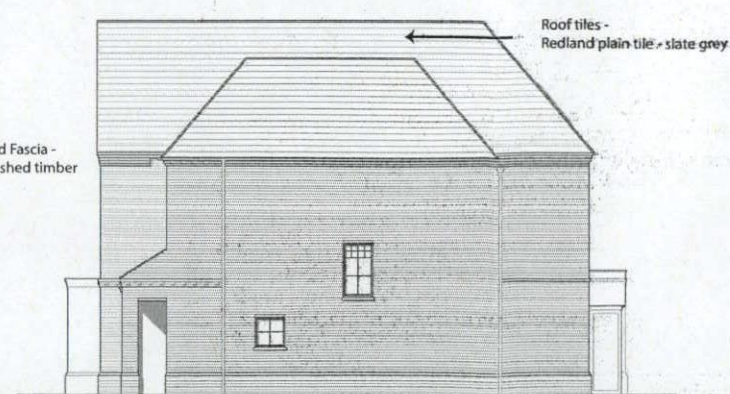

Roof tiles - Redland plain tile, slate grey

SIDE ELEVATION

LATCHMERE HOUSE	1:100 @A1 1:200 @A3
PLANS, SECTIONS AND ELEVATIONS	JAN 2016
HOUSE TYPE E2	drawing no. rev.
	BKH04-P-207 02