



Amended Roof Planning Drawing


Facade Material Change

- 1 Proposed Change: Green roof position moved to main roof level.
Reasons: Green roofs combined on top floor for improved maintenance access.
- 2 Proposed Change: Guardrail and man-safe design incorporated.
Reasons: Guard rail and man-safe system required to satisfy current Health and Safety statutory regulations.



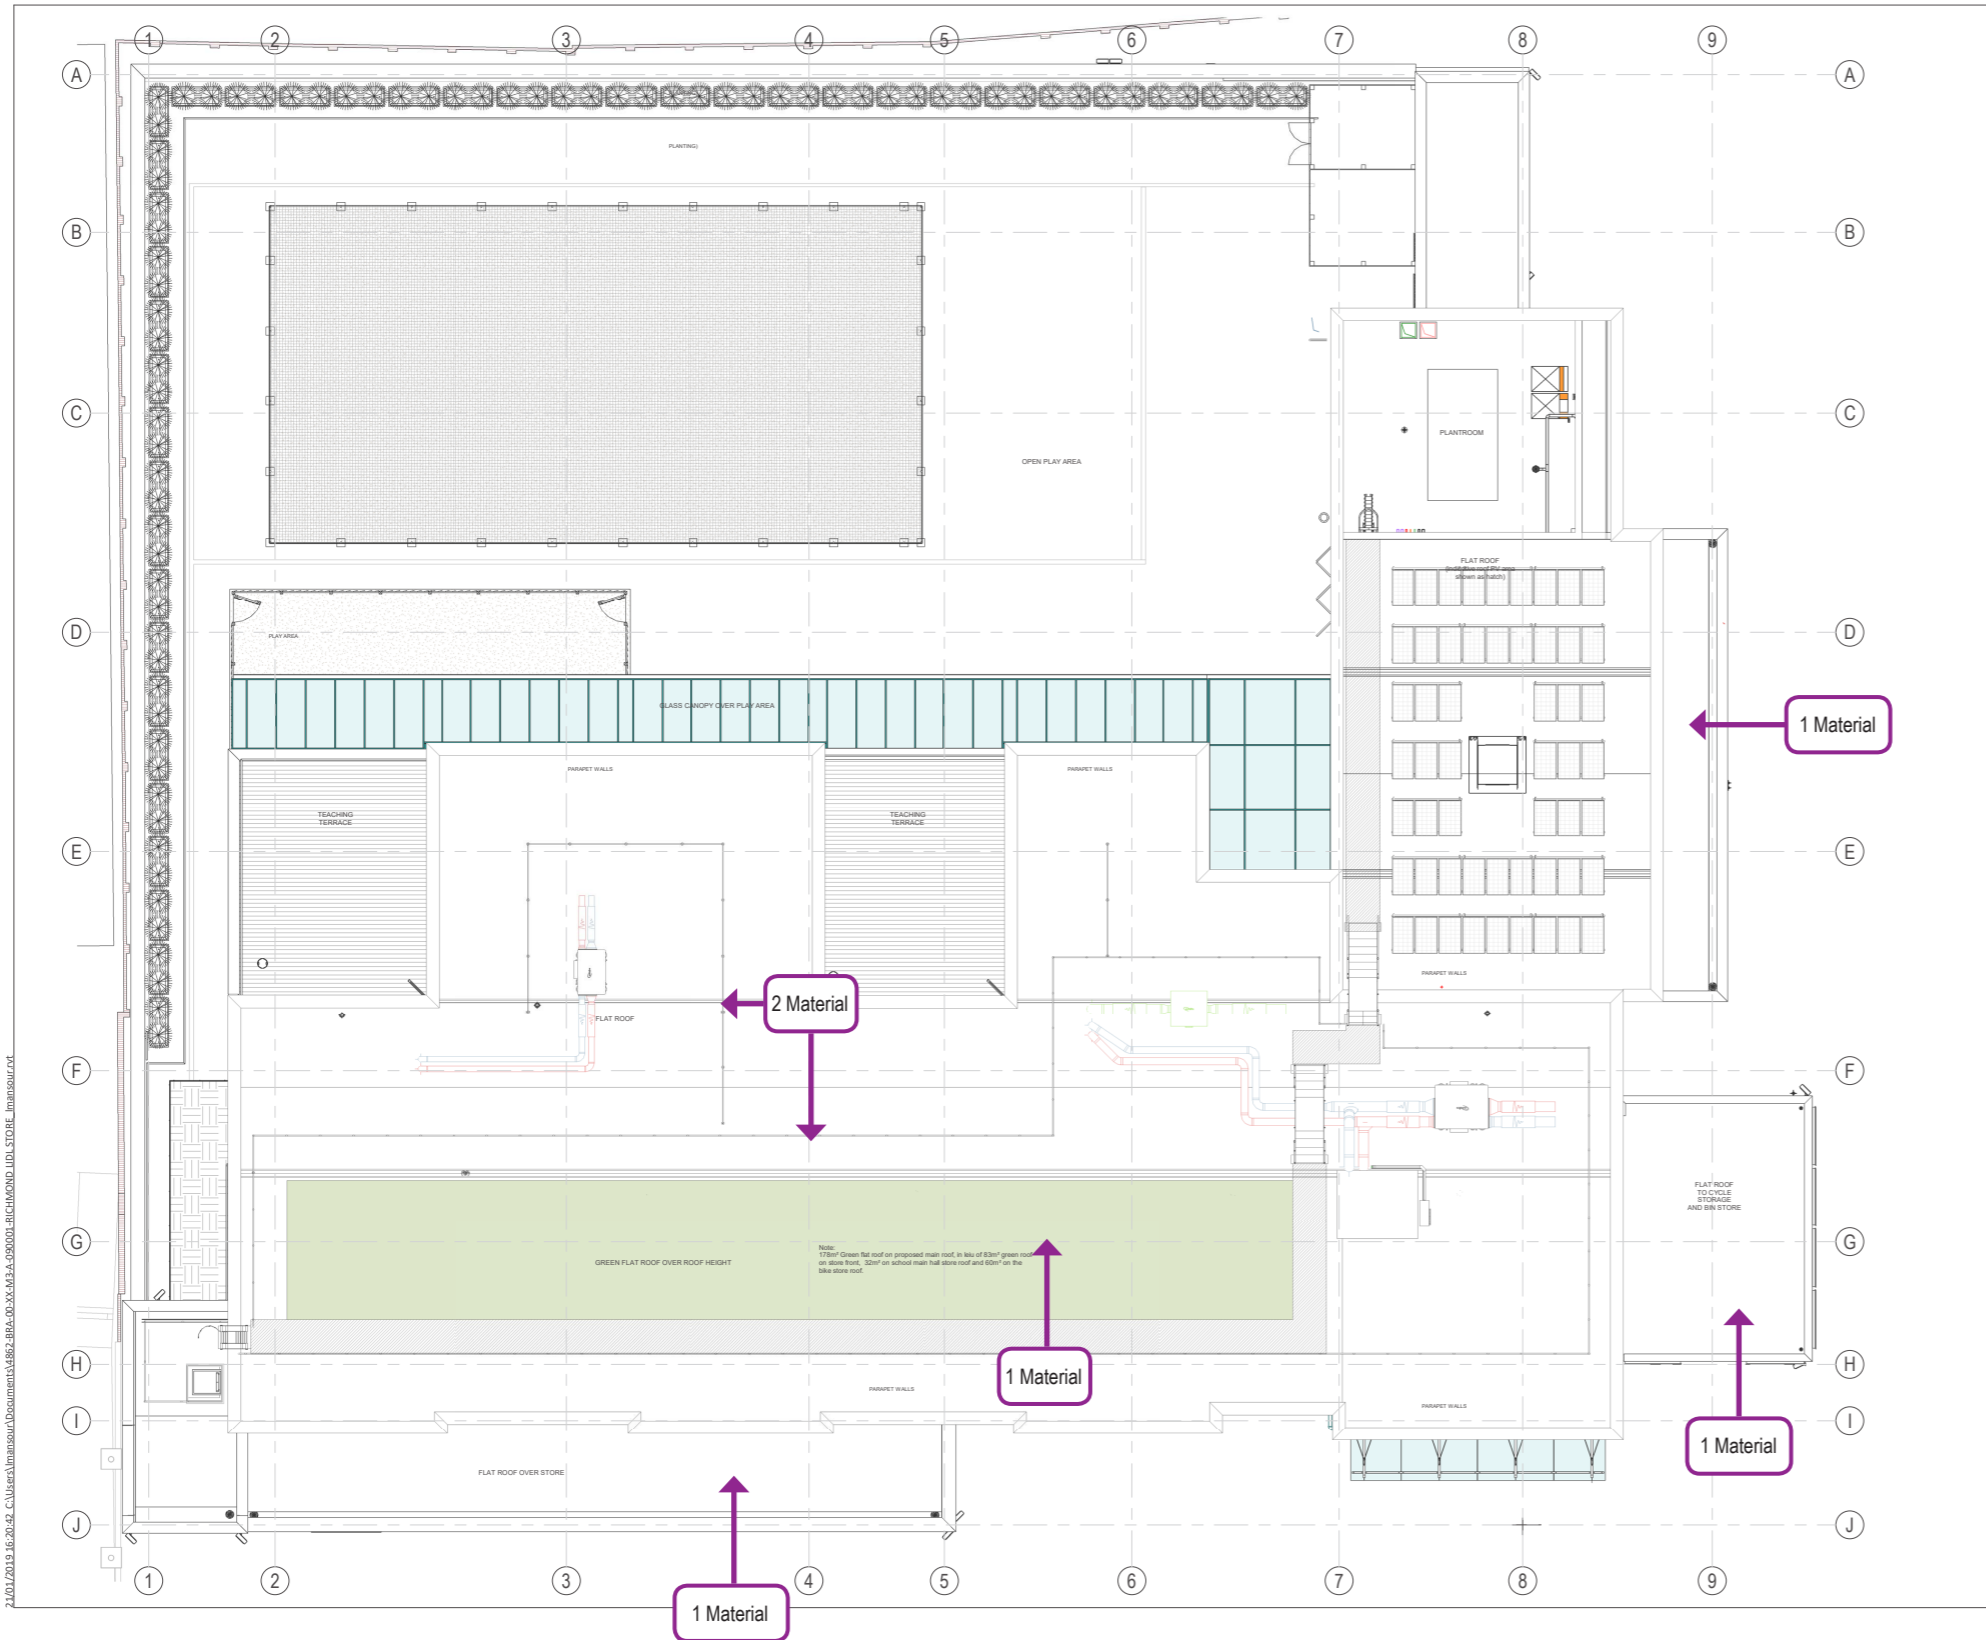



Client's Logo:



Contractor's Logo:

REV	DATE	DESCRIPTION	BY
8	21.12.18	Updated for construction with latest package information	JC
7	03.10.18	GA plan general update	TN
6	24.08.18	Planning Issue	JC
5	24.08.18	Green roofs consulted on main roof	TNS
4	19.06.18	GA Plans, Elevations and Sections issued with DWG	JC
3	04.06.18	Design Development	GCP

IN CASE OF DOUBT OR DISCREPANCIES PLEASE REFER TO ARCHITECT FOR INSTRUCTIONS. DRAWING AND SUITABILITY NUMBERS IN ACCORDANCE WITH BS1192:2007. THIS DRAWING SHOULD NOT BE SCALED. THIS DRAWING IS COPYRIGHT.

SUITABILITY NUMBER KEY:		DOCUMENTATION - SIGN-OFF	
WP	Work in Progress*	A	Fit for construction
SHARED		B	Fit for construction, with comments
S1	Fit for information**	C	Comprehensive reviews needed
S2	Fit for information	ARCHIVE	
S3	Fit for internal review and comment	AB	As Built
S4	Fit for construction approval	FC	Final Construction

DOCUMENTATION: * For internal pre-issue usage only. ** For reader/fit usage only.

boyesrees architects

4th Floor, Greyfriars House
Greyfriars Road, Cardiff CF10 3AL
Tel: 029 2055 8900 Fax: 029 2039 9592
www.boyesrees.co.uk
Registered office. As above Reg No. 295
1683 (England & Wales)

PROJECT TITLE:
Proposed LIDL store on Richmond Road
Twickenham

DRAWING TITLE: GA Roof Plan		DRAWN BY: ADT		SCALE: As indicated @ A1	
JOB NO: 4862		DATE: 11/17/15		REVISION: 8	
SUITABILITY: S3	PROJECT ORIGIN: BRA	VOLUME: 00	LEVEL: 03	TYPE: DR	DISC: A
				NUMBER: 0103	

Z:\01\2019\16_20162_C:\Users\kmanow\Documents\4862_BRA_00_00_0001-816162001-LIDL STORE - main roof.dwg