ORIGINAL PLANNING ELEVATION



STOCK BRICK

OBSCURE GLASS BALUSTRADE


PLANTING



West Elevation (Side Elevation)

Scale: 1:250

REVISED PLANNING ELEVATION

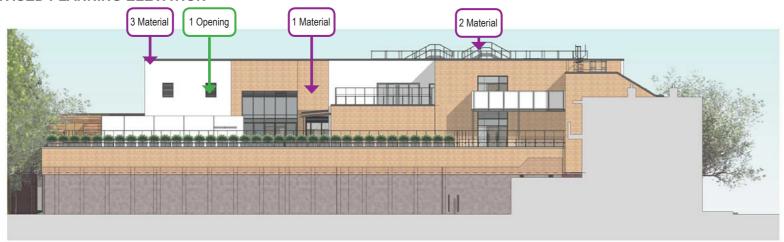

West Elevation (Side Elevation)
Scale: 1:250

_								
		_						
1	24.08.18	Plan	ning Issu	ie.				JC
REV	DATE	1 101			CRIPTIO	N		BY
DRAWI THIS D	E OF DOUBT OR DE NG AND SUITABILE RAWING SHOULD I RAWING IS COPYR	TY NUN NOT BE	IBERS IN ACC	REFER TORDANG	TO ARCHITE CE WITH BS 2	T FOR INST 192:2007.	RUCTIONS.	
SI S	BILITY NUMBER KE - Work in Progress D - Fit for co-ordinati - Fit for information - Fit for insternal res - Fit for construction - Fit for construction - Fit for tender - Fit for tender - Fit for manufactu	on** niew and n appro	real	A B C ARCH AF	- Fit for con - Fit for con - Comprehe IIVE B - As Built C - Final Con	struction, w naive revisio struction issue usage	ith comments	
				eyfria	rs Road, C	friars Ho ardiff CF	10 3AL	
	yesree archite	es cts	Tel:	eyfria 029 20 w	rs Road, 0 055 8900 ww.boyer	Fax: 029 2 srees.co.u	10 3AL 1039 9592 ik	
PRO. Pro Tw	DYESTEC archite ECT TITLE : DOSED L LICKENHAR WING TITLE	m	Reg Store	op 20 w istered i	rs Road, C 055 8900 i www.boyer office. As ab (England)	Fax: 029 2 srees.co.u over Reg No & Wales)	10 3AL 1039 9592 ik 295 1683 Road	
PROD Pro Tw	archite posed L ickenhar wing title nning 04	m	Reg Store	ozg zo w www.isstered.com F	rs Road, C 055 8900 i www.boyer office. As ab (England)	Fax: 029 2 srees.co.u over Reg No & Wales)	10 3AL 1039 9592 ik 2 295 1683 Road	
PROD Pro Tw	archite posed L ickenhar wing title nning 04	m W	store	on F	rs Road, C 1055 8900 www.boyer office. As ab (England)	Fax: 029 2 Strees.co.u over Reg No. 8. Wales)	10 3AL 2039 9592 ik 295 1683 Road	
PRO. Pro Tw	archite BECT TITLE: Sposed Li ickenhar WING TITLE MINING TITLE WING TITL	m W	store est Ele	on f	rs Road, C 1055 8900 www.boyer office. As ab (England)	Fax: 029 3 Frac: 029 6 Frac: 0	10 3AL 2039 9592 ik 295 1683 Road	

West Elevation Planning Drawings

Curtain Walls, Windows and Door Openings

Proposed Change: Window / louvre design rationalised and aligned.

Reasons: Opening rationalized to suit revised elevation and CDM requirement.

Facade Material Change

Proposed Change: Cladding changed to brick.

Reasons: Render replaced to create differentiation with plant room.

Proposed Change: Guardrail and man-safe design incorporated.

> Reasons: Guard rail and man-safe system required to satisfy current Health and Safety statutory regulations.

Proposed Change: Roof and parapet levels rationalized.

Reasons: Roof levels simplified to allow easier roof access. Parapet levels adjusted to suit.