Sanjay Sharma London Square **One York Road** Uxbridge **UB8 1RN**



LONDON | WC2E 9AB

25th October 2019

Dear Sanjay,

RE: GREGGS BAKERY, TWICKENHAM – DAYLIGHT AND SUNLIGHT

Point 2 have been instructed by London Square to review the latest scheme produced by Assel Architecture for Greggs Bakery site, Gould Road, Twickenham (the 'Site').

The purpose of this review is to understand whether the massing has changed since the previous scheme produced and if these changes are likely to materially alter the results and conclusions outlined within the daylight, sunlight and overshadowing report produced by Point 2 in February 2019 (doc ref: 190218 – Greggs Bakery – Daylight, Sunlight and Overshadowing Planning Report).

The two schemes considered within this letter are as follows:

- > The Previous Scheme Issued to Point 2 on the 21st January 2019 and forms the basis of the February daylight and sunlight report. This scheme has been illustrated in drawings 1886_10-12 located in Appendix 1. (The 'Previous Scheme')
- > The Proposed Scheme Issued to Point 2 on the 10th October 2019 which has been illustrated in drawings 1886 16-18 located in Appendix 1 (the 'Proposed Scheme')

Please note that this is a desktop review and no further technical analysis has been undertaken.

In order to understand where the massing has changed between the two schemes, we have produced an overlay of the two, which have been included within Appendix 2. The Previous Scheme has been illustrated in 'brown' and the Proposed Scheme in 'green'.

As can be seen in the various images the Proposed Scheme doesn't materially differ from that of the Previous Scheme and in some instances the massing has been reduced, which can be seen in the massing directly to the rear of 63 and 65 Norcutt Road.

In consideration of this, it is our professional opinion that the results within the February daylight, sunlight and overshadowing report will not materially change should the Proposed Scheme be considered and therefore the conclusions within the report remain the same.

Yours Sincerely


Andrew Gilmour Senior Surveyor For and on behalf of Point 2 Surveyors

RIGHTS TO LIGHT | DAYLIGHT & SUNLIGHT | DAYLIGHT DESIGN | PARTY WALL & NEIGHBOURLY MATTERS | MEASURED SURVEYING | BIM LONDON OFFICE: 17 SLINGSBY PLACE, LONDON, WC2E 9AB | 0207 836 5828 point2.co.uk OXFORD OFFICE: 7 OASIS PARK, EYNSHAM, OXFORD, OX29 4TP | 01865 881 882

Appendix 1: Site Plan & 3D Drawings

Previous Scheme

Surce: Point2Surveyos	<image/>	Project: Greggs, Twicken	House, 65-71 63 61 53 55 53 51 48 47 45 43 41 39 7 33 41 39 7 35 33 41 39 7 35 33 41 39 7 35 51 45 45 43 41 39 7 35 51 45 45 45 45 45 45 45 45 45 45 45 45 45		Ti
Scan Data (received 28/08/18) Greggs Twickenham_UpdateAug2018_Recap.rcp	Proposed Scheme				
Site Photos (received 17/08/18) Surrounding Elevs/IMG_1144-1912.jpg					
Proposed Scheme (received 04/02/19)					
Á2871 Greggs - North.dwg A2871 Greggs - South.dwg					L
	Scheme Confirmed: - Date : -	Drawn By: JG/BZW	Scale: 1:1000 @ A3	Date: FEB 19	D

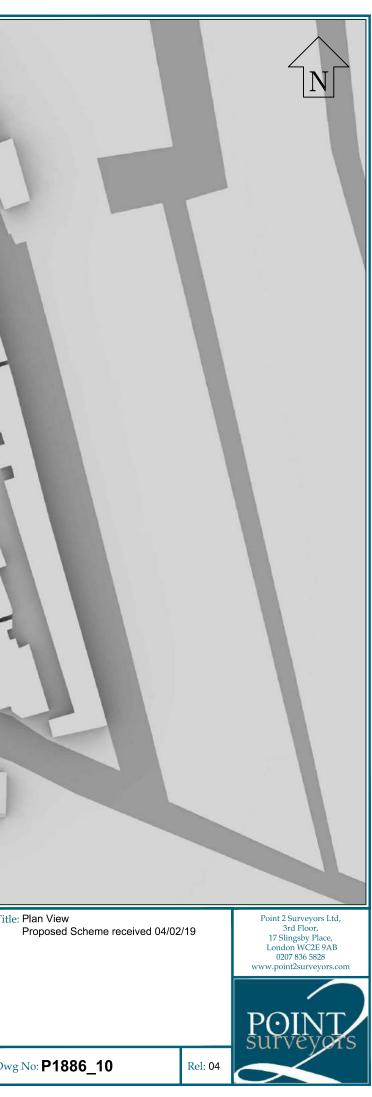

CONDEORD CONDENS				940	9765 Lealb	
					17100	
			ORAME ROAD		EDWIN ROAD	
Sources: Point2Surveyors Scan Data (received 28/08/18) Greggs Twickenham_UpdateAug2018_Recap.rcp	Key: Existing Buildings Proposed Scheme All the Heights in mm AOD		Project: Greggs, Twicken	ham		Tit
Site Photos (received 17/08/18) Surrounding Elevs/IMG_1144-1912.jpg Proposed Scheme (received 04/02/19) A2871 Greggs - North.dwg A2871 Greggs - South.dwg						
	Scheme Confirmed: -	Date : -	Drawn By: JG/BZW	Scale: NTS @ A3	Date: FEB 19	Dv




	19555 EDWIN POAD	
19500	19335 EDWIN ROL 19335 EDWIN ROL 19100 19100 19100	
	101001	
NOROT ROSO	10100 10100 10100	
		19950 11995
Sources: Point2Surveyors Scan Data (received 28/08/18) Greggs Twickenham_UpdateAug2018_Recap.rcp	Key: Existing Buildings Proposed Scheme All the Heights in mm AOD	Project: Greggs, Twickenham
Site Photos (received 17/08/18) Surrounding Elevs/IMG_1144-1912.jpg		
Proposed Scheme (received 04/02/19) A2871 Greggs - North.dwg A2871 Greggs - South.dwg		

Scheme Confirmed: -

Date : -

Drawn By: JG/BZW Scale: NTS @ A3

Date: FEB 19

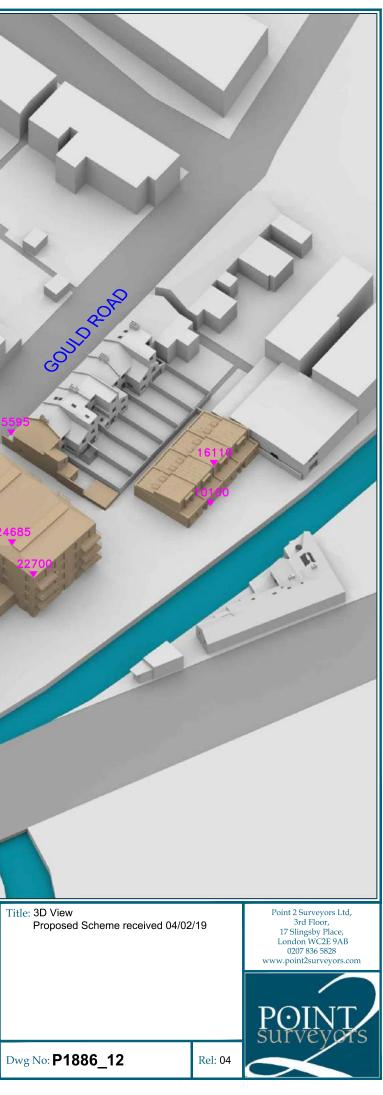


Proposed Scheme

	S Arreway Cottages	Lock House, T5 Agan House, T3 4 4 5 4 5 4 5 4 5 5 5 5 5 5 5 5 5 5 5 5 5	35 33 29 27 25 23 21 19 17 15 13 14 11 9 7 7 5 3.1 1
Sources: Point2Surveyors Scan Data (received 28/08/18) Greggs Twickenham_UpdateAug2018_Recap.rcp	Key: Existing Buildings Proposed Scheme	Project: Greggs, Twickenham	Title: Plan View Proposed Scheme received 10/10/1

Point2Surveyors Scan Data (received 28/08/18) Greggs Twickenham_UpdateAug2018_Recap.rcp	Key: Existing Buildings Proposed Scheme		Project: Greggs, Twickenham			Title: Plan View Proposed Scheme received 10/10/19
Site Photos (received 17/08/18) Surrounding Elevs/IMG_1144-1912.jpg						
Proposed Scheme (received 04/02/19) A2871 Greggs - North.dwg A2871 Greggs - South.dwg						
Proposed Scheme (received 10/10/19) A2871 3D Model.max P1886_17[AA Mark up].pdf (received 16/10/19)	Scheme Confirmed: -	Date: -	Drawn By: JG/BZW/FV	Scale: 1:1000 @ A3	Date: Oct 19	Dwg No: P1886/16

Point 2 Surveyors Limited, 17 Slingsby Place, London, WC2E 9AB | 0207 836 5828 | point2.co.uk



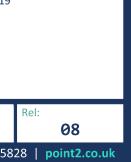




	29585 21	790		
a tation of the second s	28235	10200 19465 22025 10200		
16600 13445 V		19200 10200 19200	19465	NORCE,
CONSCRETE SOUTHER			1946	
				19200 19425 18845 10700
		CRAMERE		EDWIN ROAD

Sources: Point2Surveyors Scan Data (received 28/08/18) Greggs Twickenham_UpdateAug2018_Recap.rcp	Key: Existing Buildings Proposed Scheme		Project: Greggs, Twi	ckenham		Title: 3D View Proposed Scheme received	10/10/19
Site Photos (received 17/08/18) Surrounding Elevs/IMG_1144-1912.jpg							
Proposed Scheme (received 04/02/19) A2871 Greggs - North.dwg A2871 Greggs - South.dwg	All Heights in mm AOD						
Proposed Scheme (received 10/10/19) A2871 3D Model.max P1886_17[AA Mark up].pdf (received 16/10/19)	Scheme Confirmed: -	Date: -	Drawn By: JG/BZW/FV	Scale: NTS @ A3	Date: Oct 19	Dwg No: P1886/17	



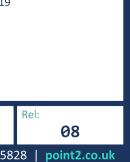




EDWINROAD CRANE ROAD 19400 • 19900 13935 11600 NORCUTT ROAD 19200 ▼ 62 29585 00 21790 19210 13250

Sources: Point2Surveyors Scan Data (received 28/08/18) Greggs Twickenham_UpdateAug2018_Recap.rcp	Key: Existing Buildings Proposed Scheme		Project: Greggs, Twi	ckenham		Title: 3D View Proposed Scheme received 1	0/10/19
Site Photos (received 17/08/18) Surrounding Elevs/IMG_1144-1912.jpg							
Proposed Scheme (received 04/02/19) A2871 Greggs - North.dwg A2871 Greggs - South.dwg	All Heights in mm AOD						
Proposed Scheme (received 10/10/19) A2871 3D Model.max P1886_17[AA Mark up].pdf (received 16/10/19)	Scheme Confirmed: -	Date: -	Drawn By: JG/BZW/FV	Scale: NTS @ A3	Date: Oct 19	Dwg No: P1886/18	

Point 2 Surveyors Limited, 17 Slingsby Place, London, WC2E 9AB | 0207 836 5828 | point2.co.uk




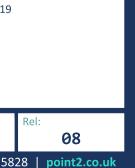





Appendix 2: Overlay Drawings




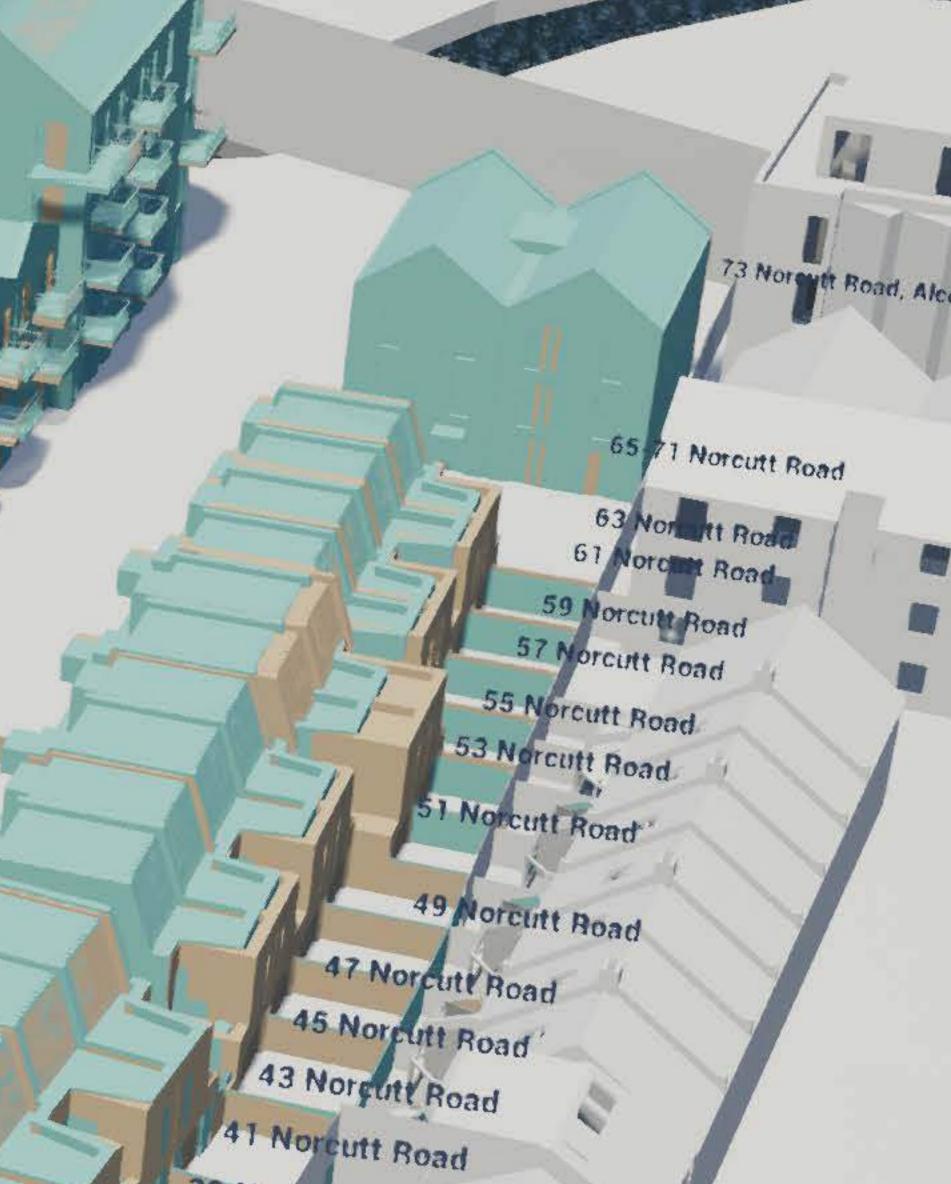

×

 

 

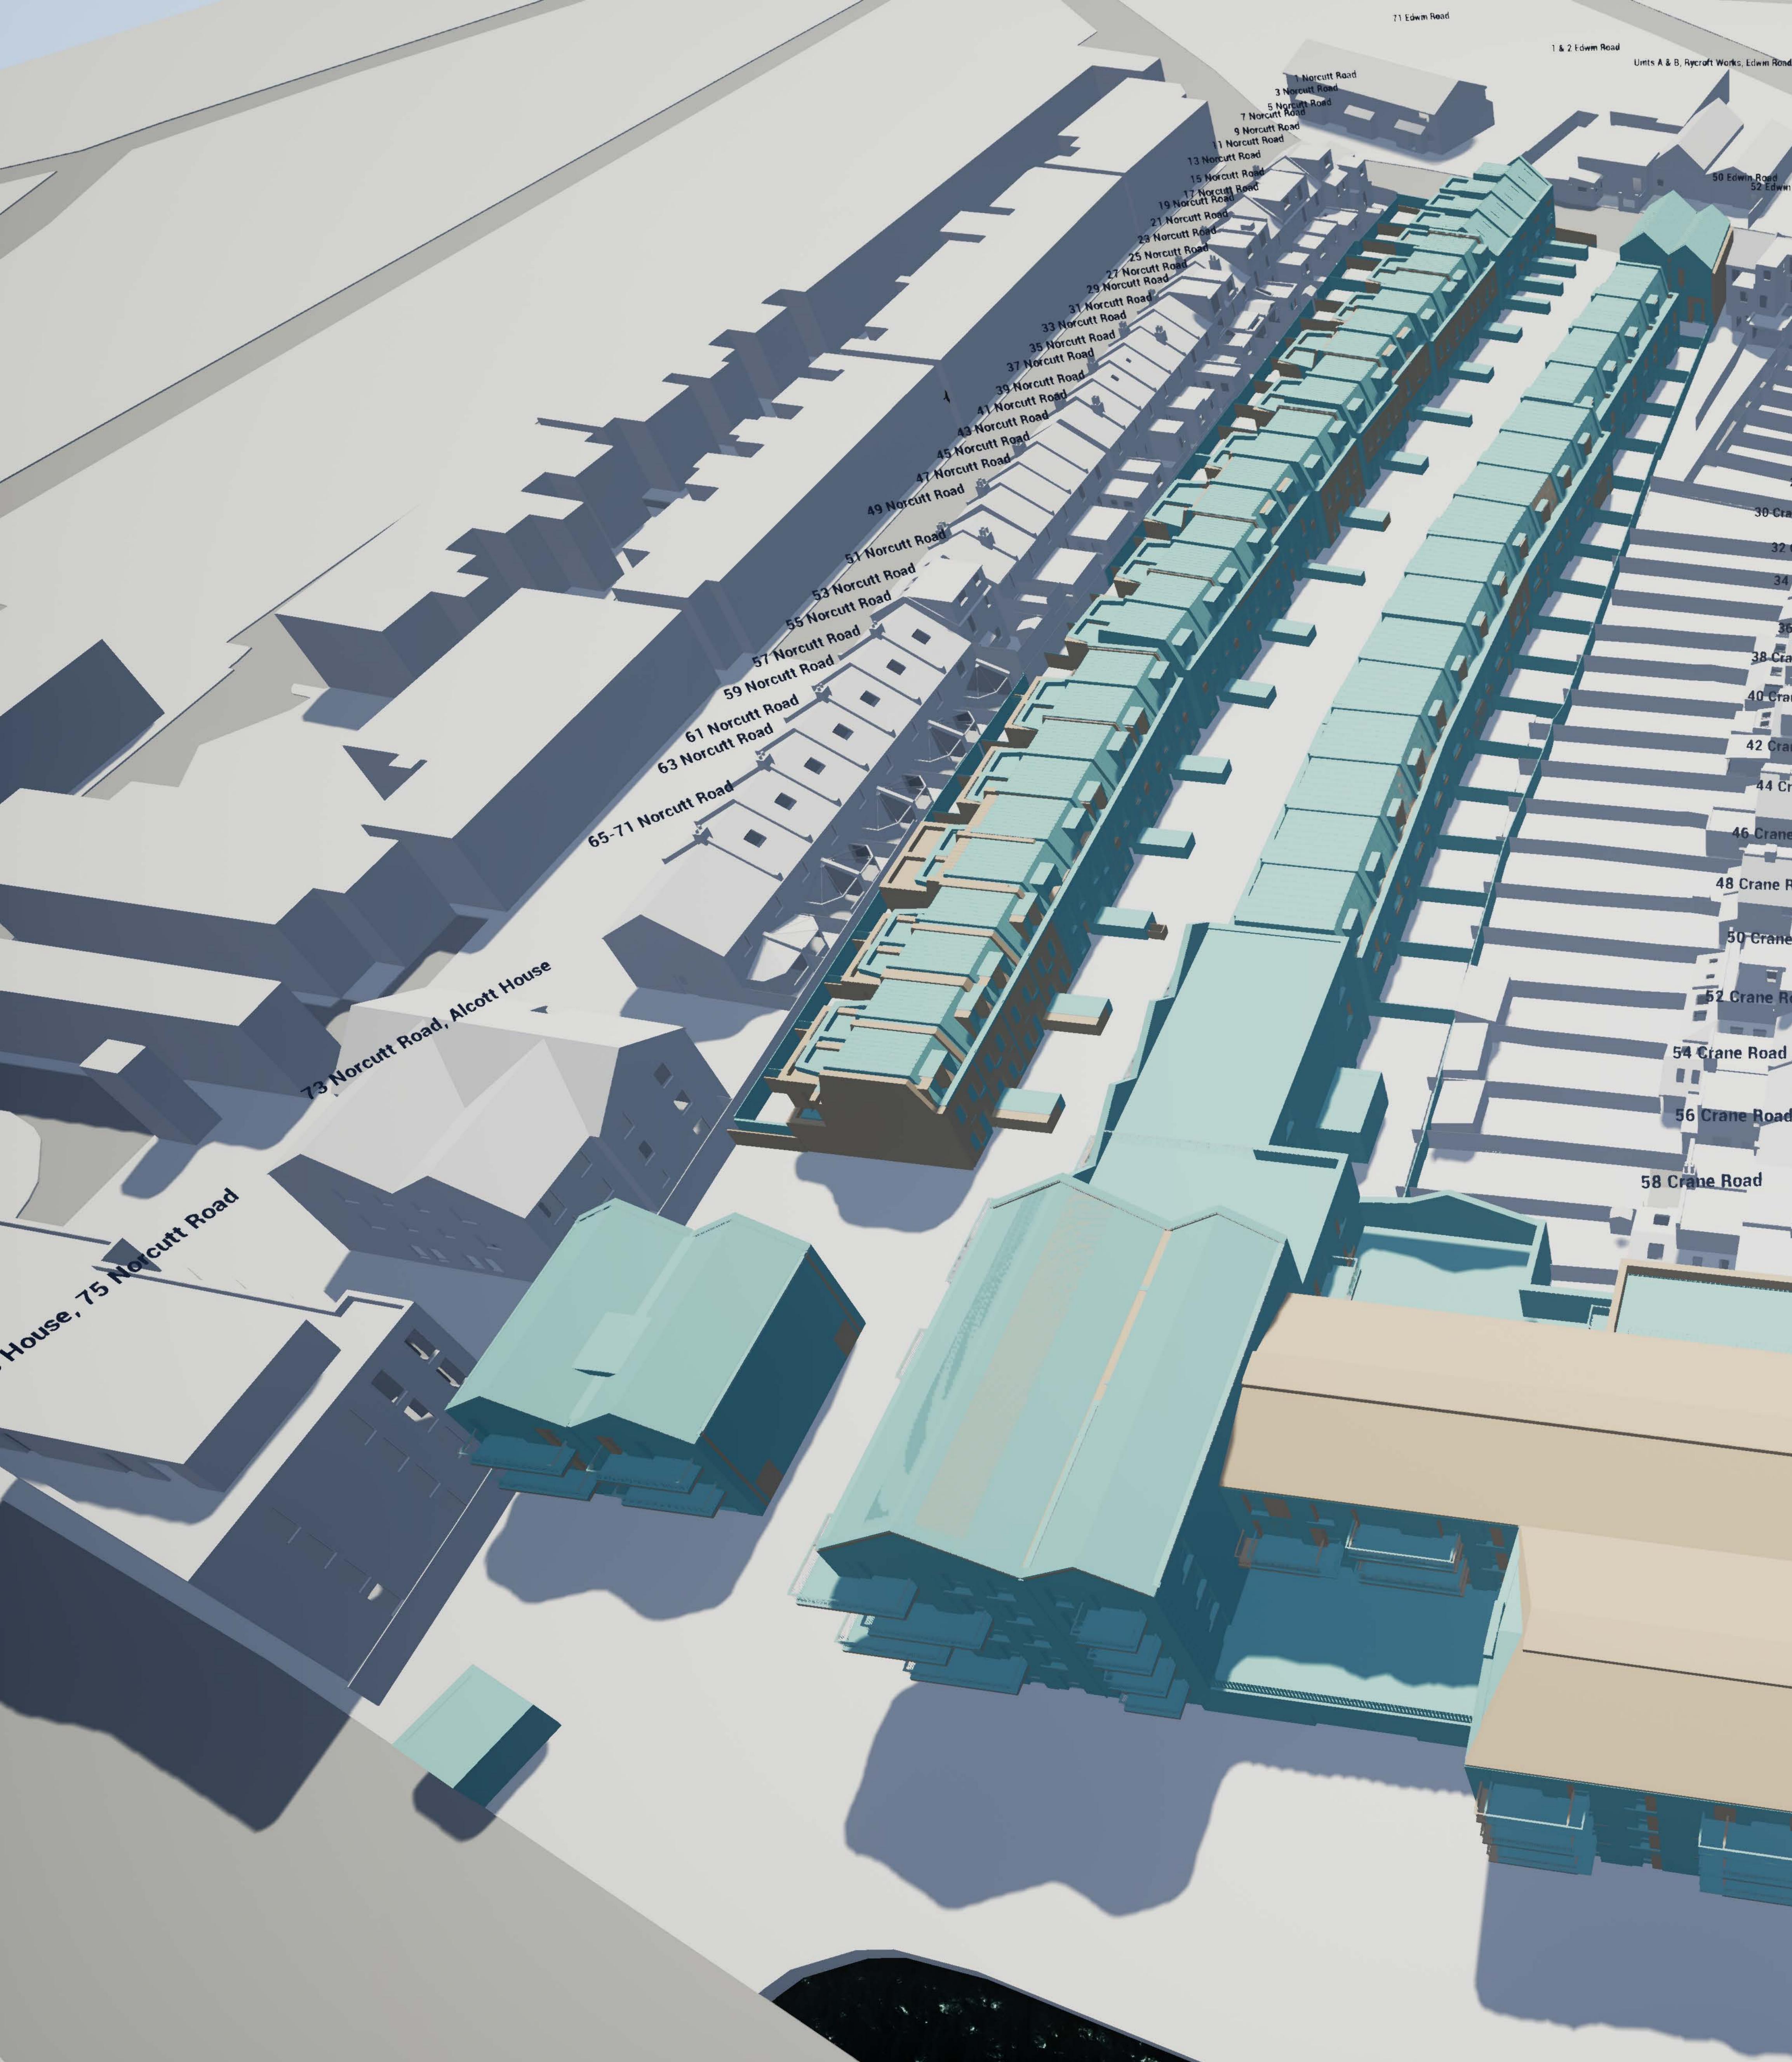

Umts A & B, Rycroft Works, Edwin Road 4 Crane Road

Ga

En

Roa


4 Gould Road

 
Arrest Contraction

48 Crane Roa


50 Crane Road

-uld Rog Bould Road

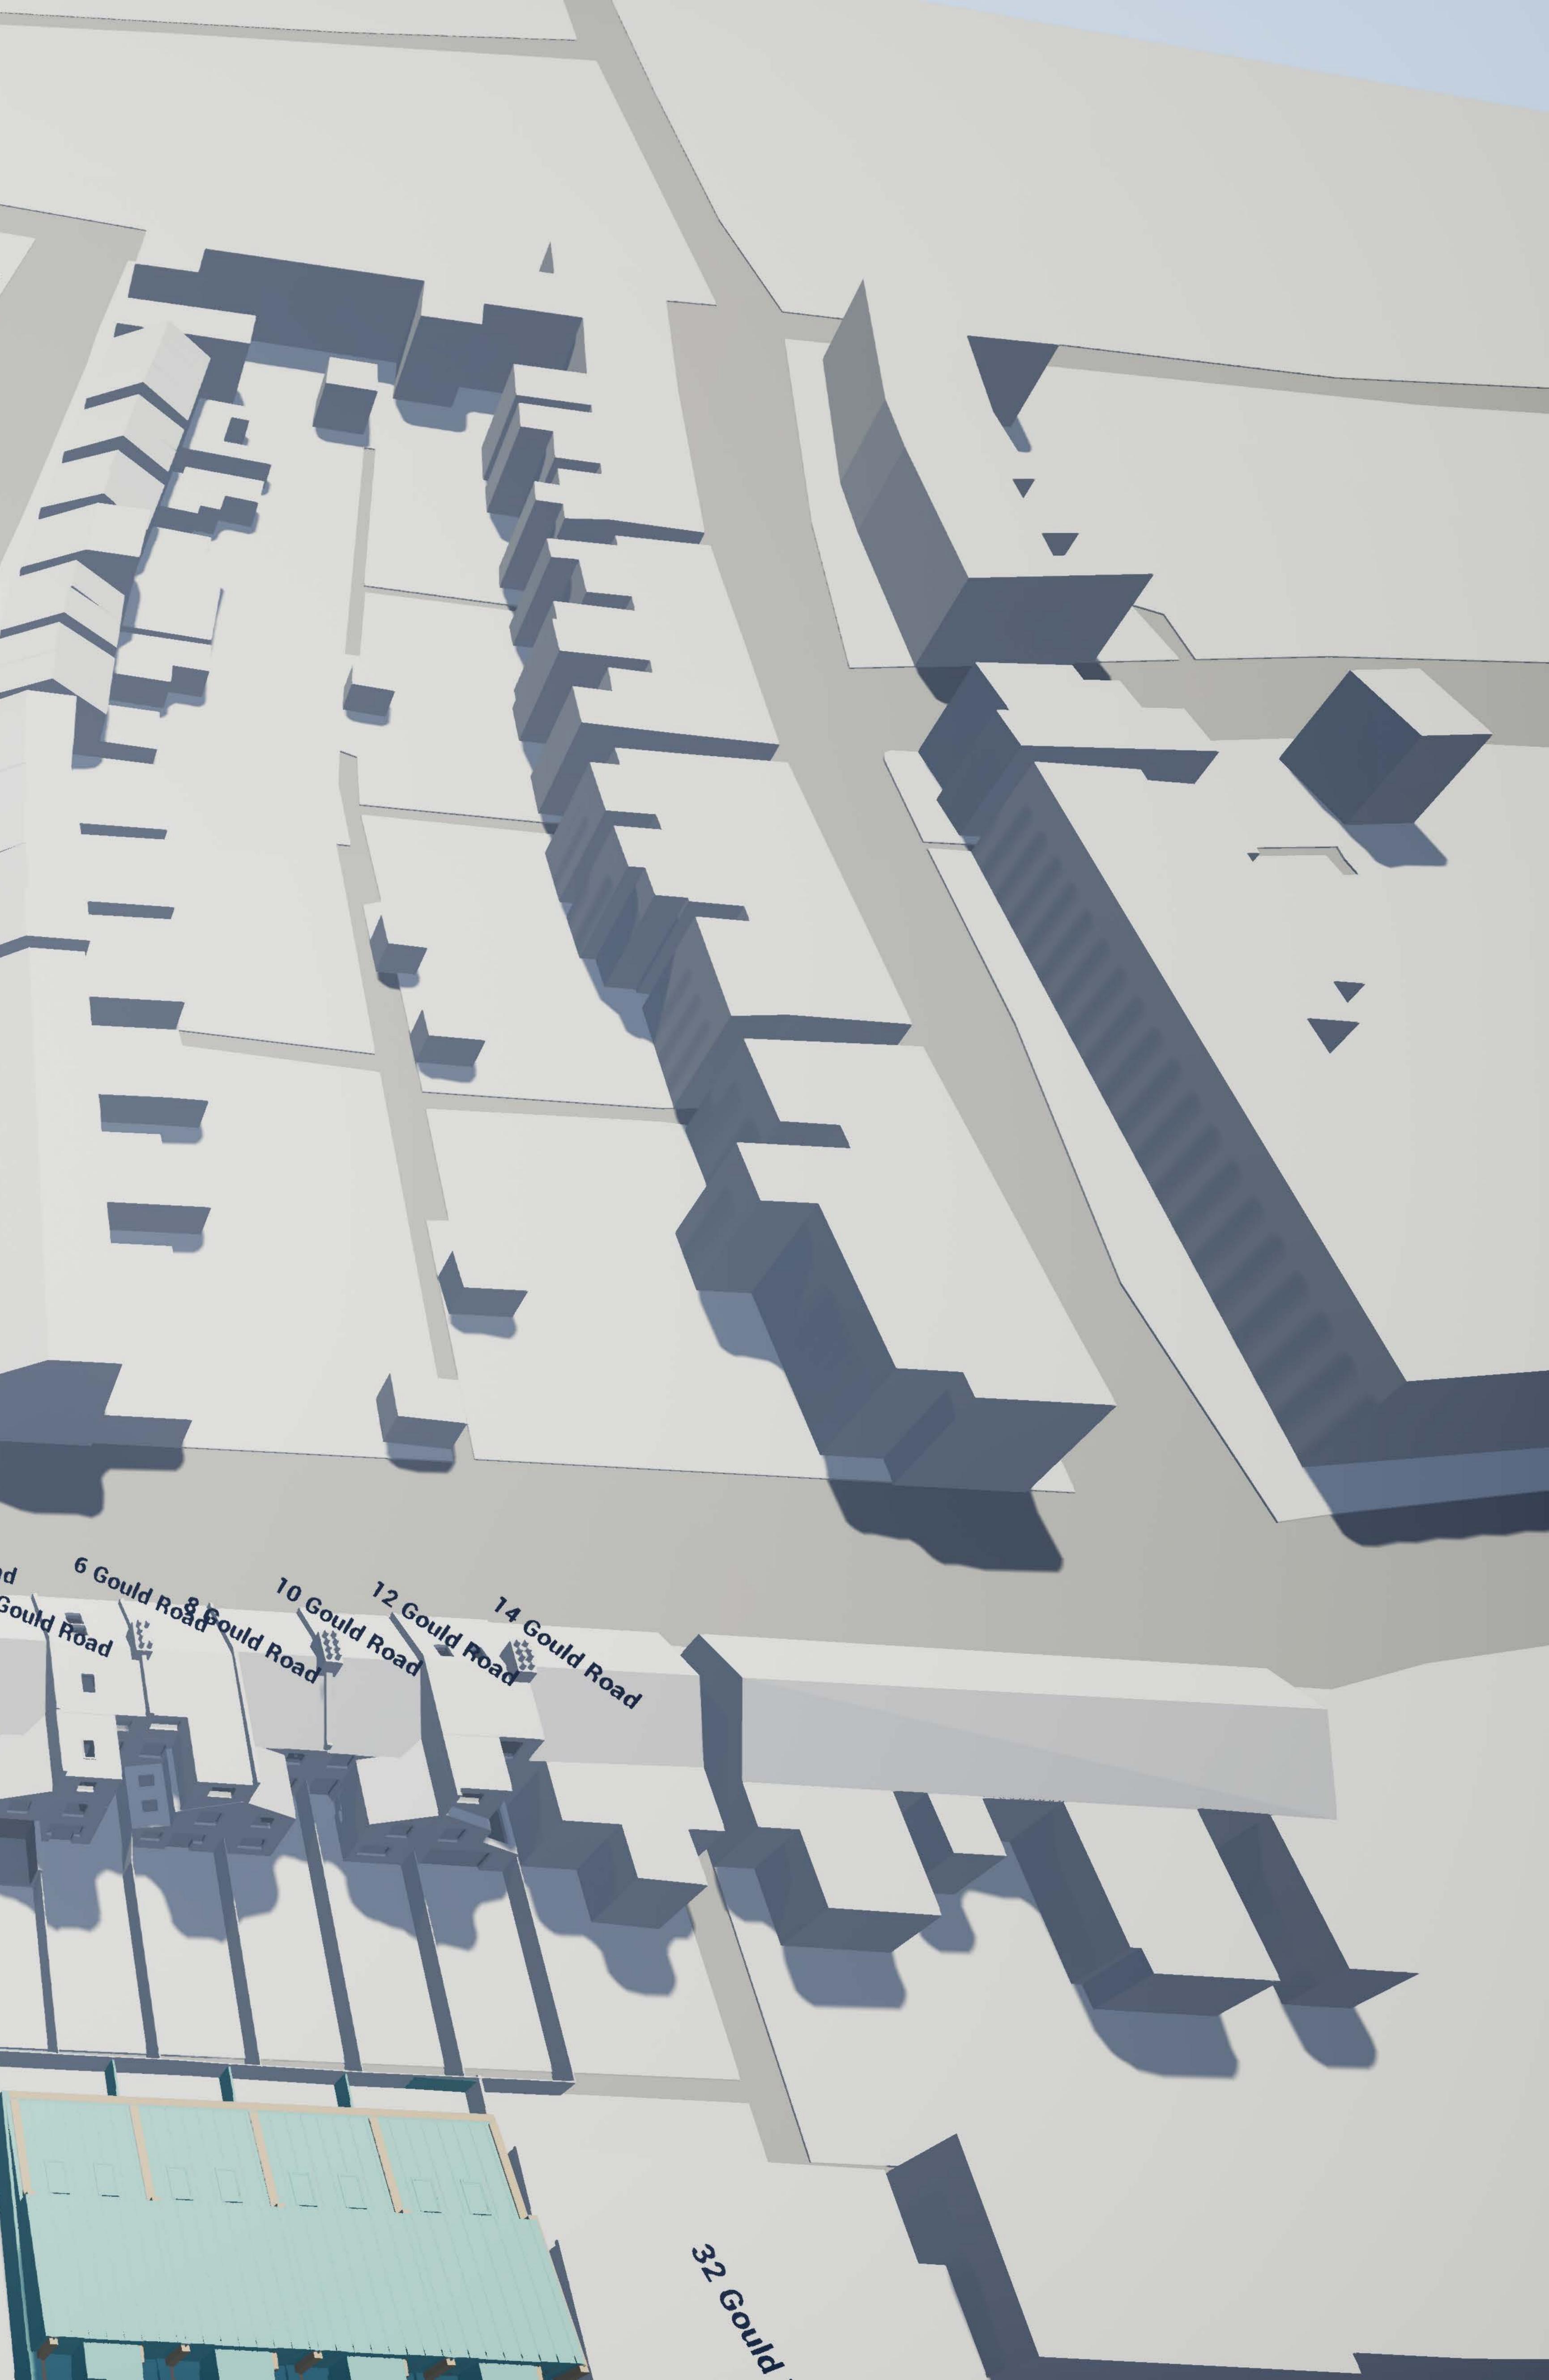





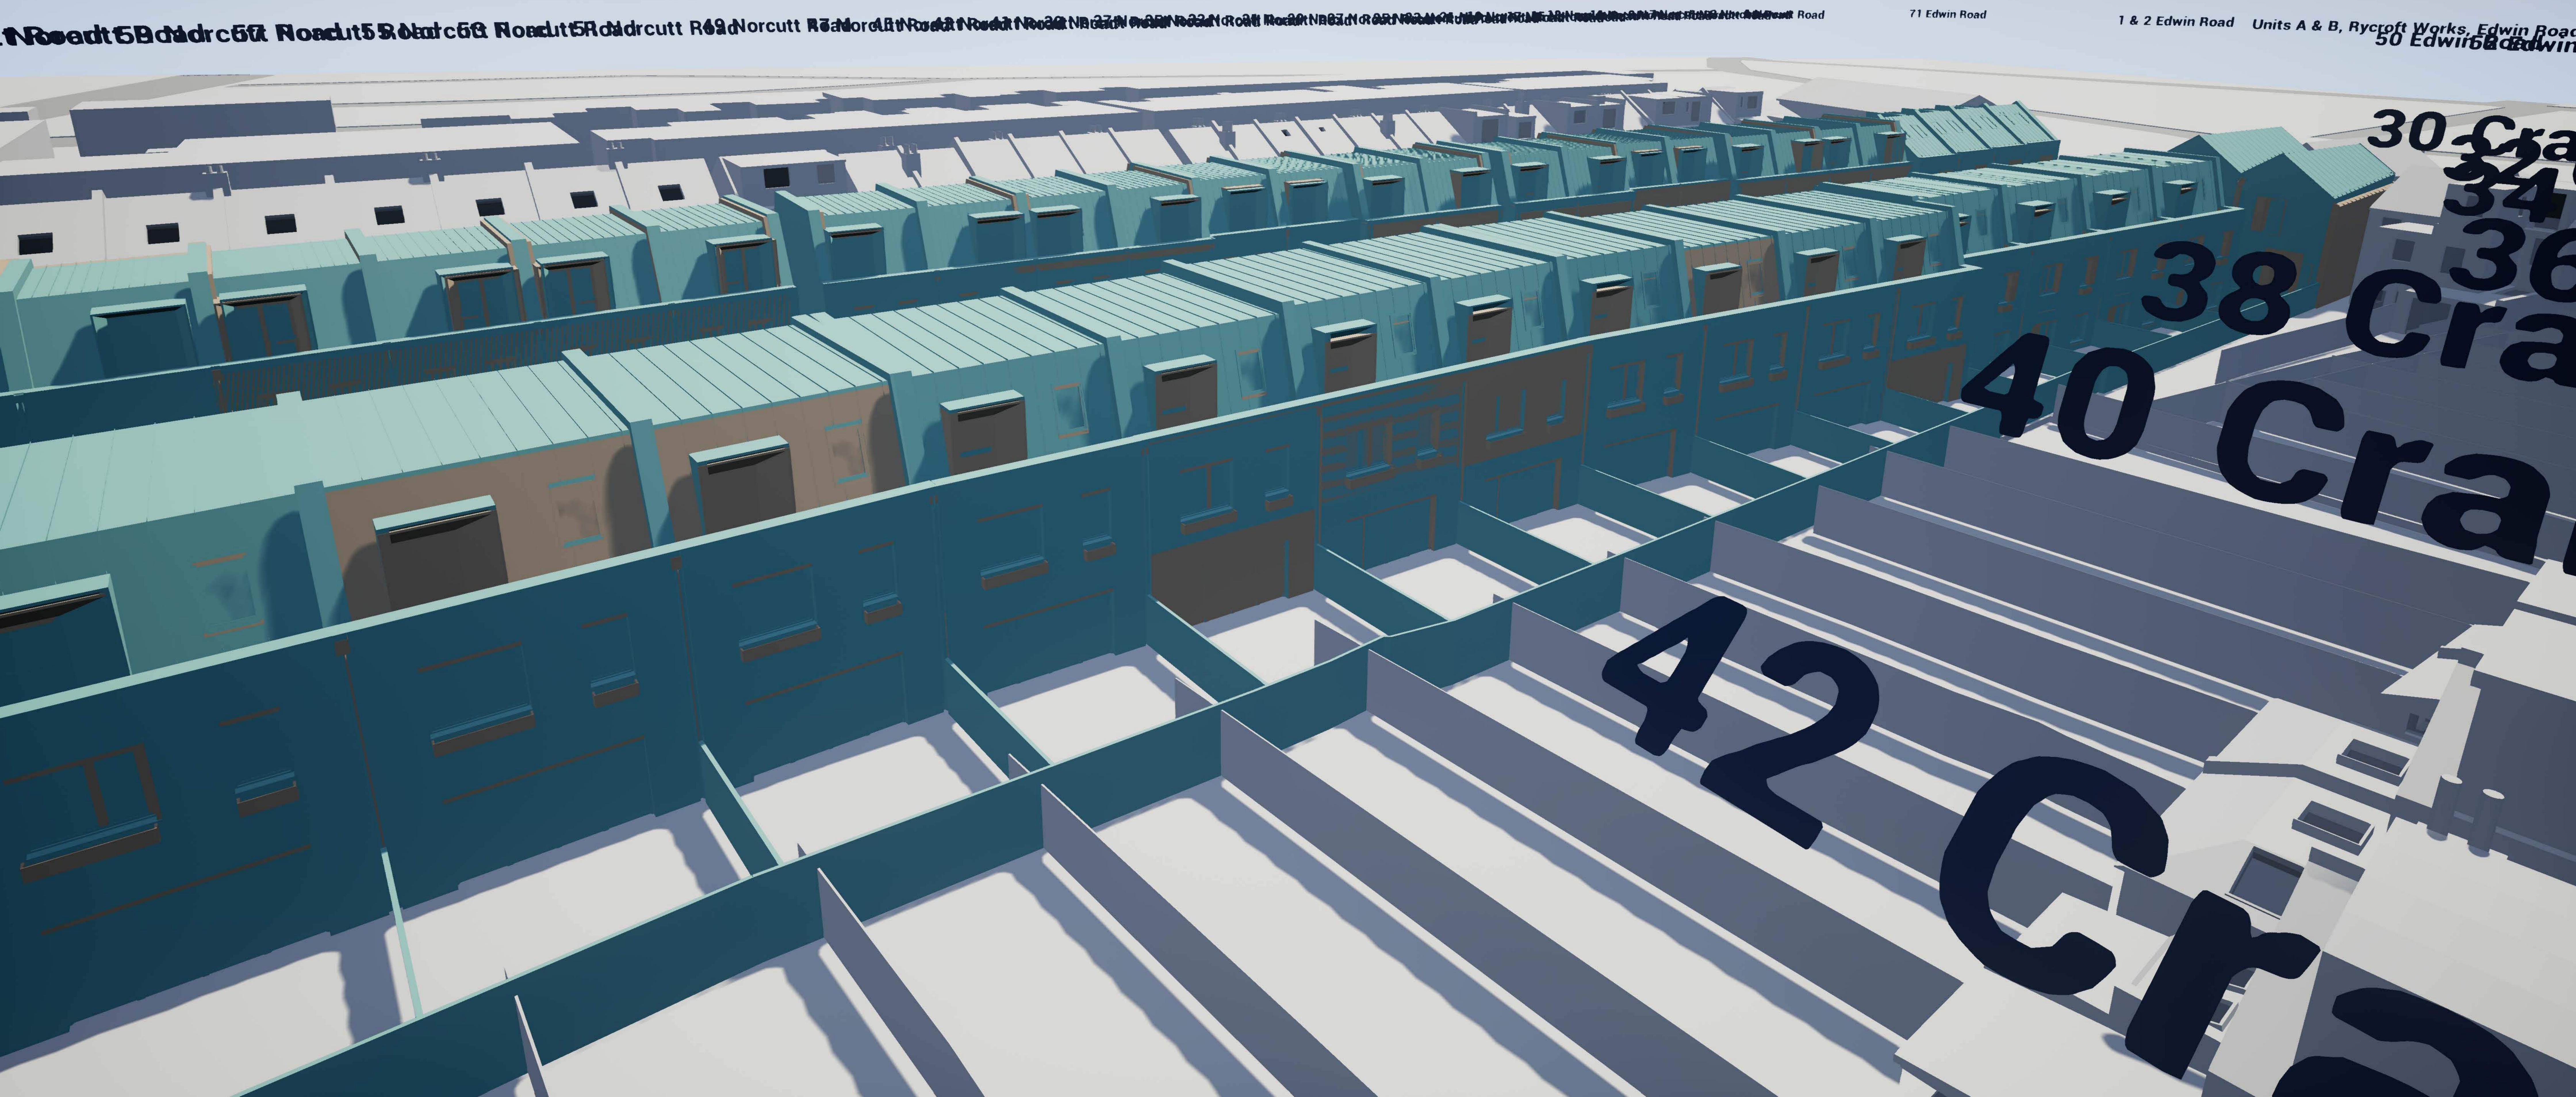

71 Edwin Road

