


DISCLAIMER:
 Dimensions to be verified on site. Only figured dimensions to be used and any discrepancies in dimensions are to be reported to RJHA. No dimensions are to be scaled from printed drawings. Any areas indicated on this drawing are for guidance only. No responsibility is taken for their accuracy.
 There is a risk of injury or death in construction if works are not properly planned and supervised. The contractor must not undertake any elements of the work without first having carried out the necessary risk assessments and prepare detailed method statements.

NOTES

STAGE
'AS-BUILT'

KEY

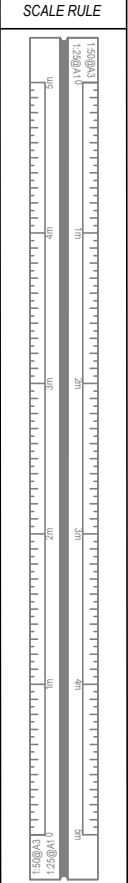

REV.	DESCRIPTION:	BY	DATE
-	'AS-BUILT'	BS	17-12-19

RICHARD JAMES HASTINGS ARCHITECTURE			
A: 26 ADAM AND EVE MEWS, W8 6UJ. E: CONTACT@RJHARCHITECTURE.COM			
Client	MR A. BRUSAROSCO & MS P. WALKER		
Address	38 WESTMORELAND ROAD, SW13 9RY		
TITLE	FRONT ELEVATION AS BUILT		
DRAWING	170037 GA-E-A		
REV.	-	SCALE	AS STATED
STATUS	'AS-BUILT'	DRAWN	CCS
DATE	20.12.2019	CHECKED	RJH

38 WESTMORELAND ROAD

40 WESTMORELAND ROAD

36 WESTMORELAND ROAD



1 FRONT ELEVATION AS BUILT
 GA-E-A SCALE: 1:50 @ A3 // 1:25 @ A1