


 



1 SECOND FLOOR PLAN AS BUILT
 GA-P-102 SCALE: 1:50 @ A3 // 1:25 @ A1

DISCLAIMER:
 Dimensions to be verified on site. Only figured dimensions to be used and any discrepancies in dimensions are to be reported to RJHA. No dimensions are to be scaled from printed drawings. Any areas indicated on this drawing are for guidance only. No responsibility is taken for their accuracy.
 There is a risk of injury or death in construction if works are not properly planning and supervised. The contractor must not undertake any elements of the work without first having carried out the necessary risk assessments and prepare detailed method statements.

NOTES

STAGE
'AS-BUILT'

- KEY**
-  EXISTING WALL
 -  BUILT WALL
 -  WOODEN FLOOR
 -  STONE/TILE FLOOR

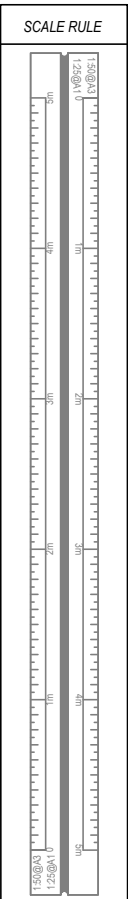

REV.	DESCRIPTION:	BY	DATE
-	'AS-BUILT'	BS	17-12-19

RICHARD JAMES HASTINGS ARCHITECTURE			
<small>A: 26 ADAM AND EVE MEWS, W8 6JJ. E: CONTACT@RJHARCHITECTURE.COM</small>			
Client	MR A. BRUSAROSCO & MS P. WALKER		
Address	38 WESTMORELAND ROAD, SW13 9RY		
TITLE	SECOND FLOOR PLAN AS BUILT		
DRAWING	170037 GA-P-102		
REV.	-	SCALE	AS STATED
STATUS	'AS-BUILT'	DRAWN	BS
DATE	17.12.2019	CHECKED	R/JH