




6 Section at Rooflight
1 : 20

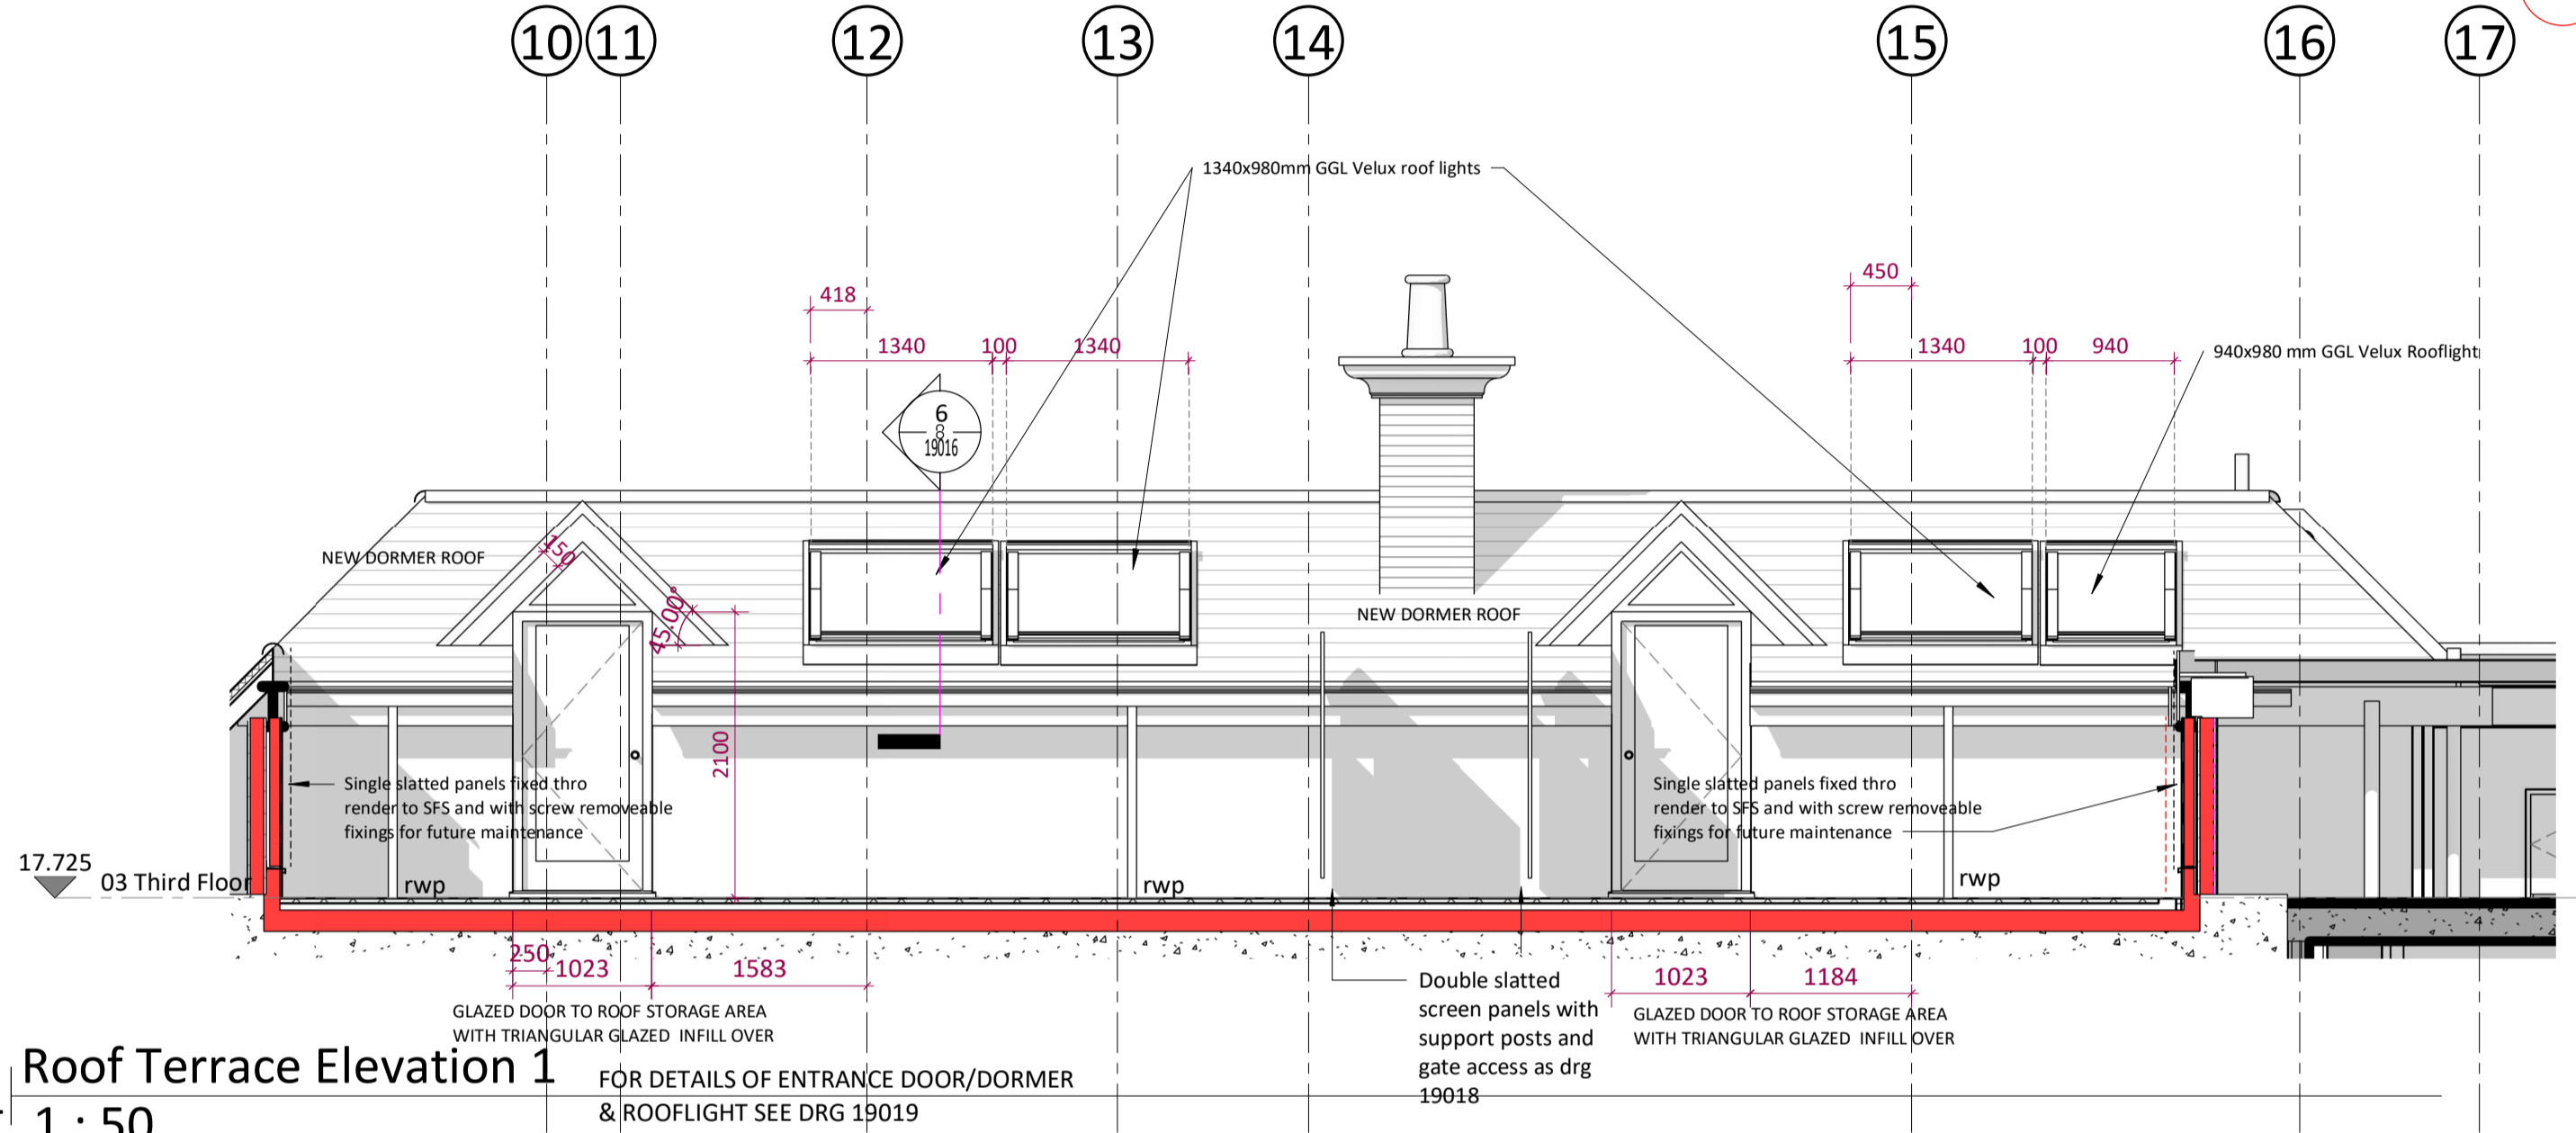


1 Roof Terrace Elevation 1
1 : 50

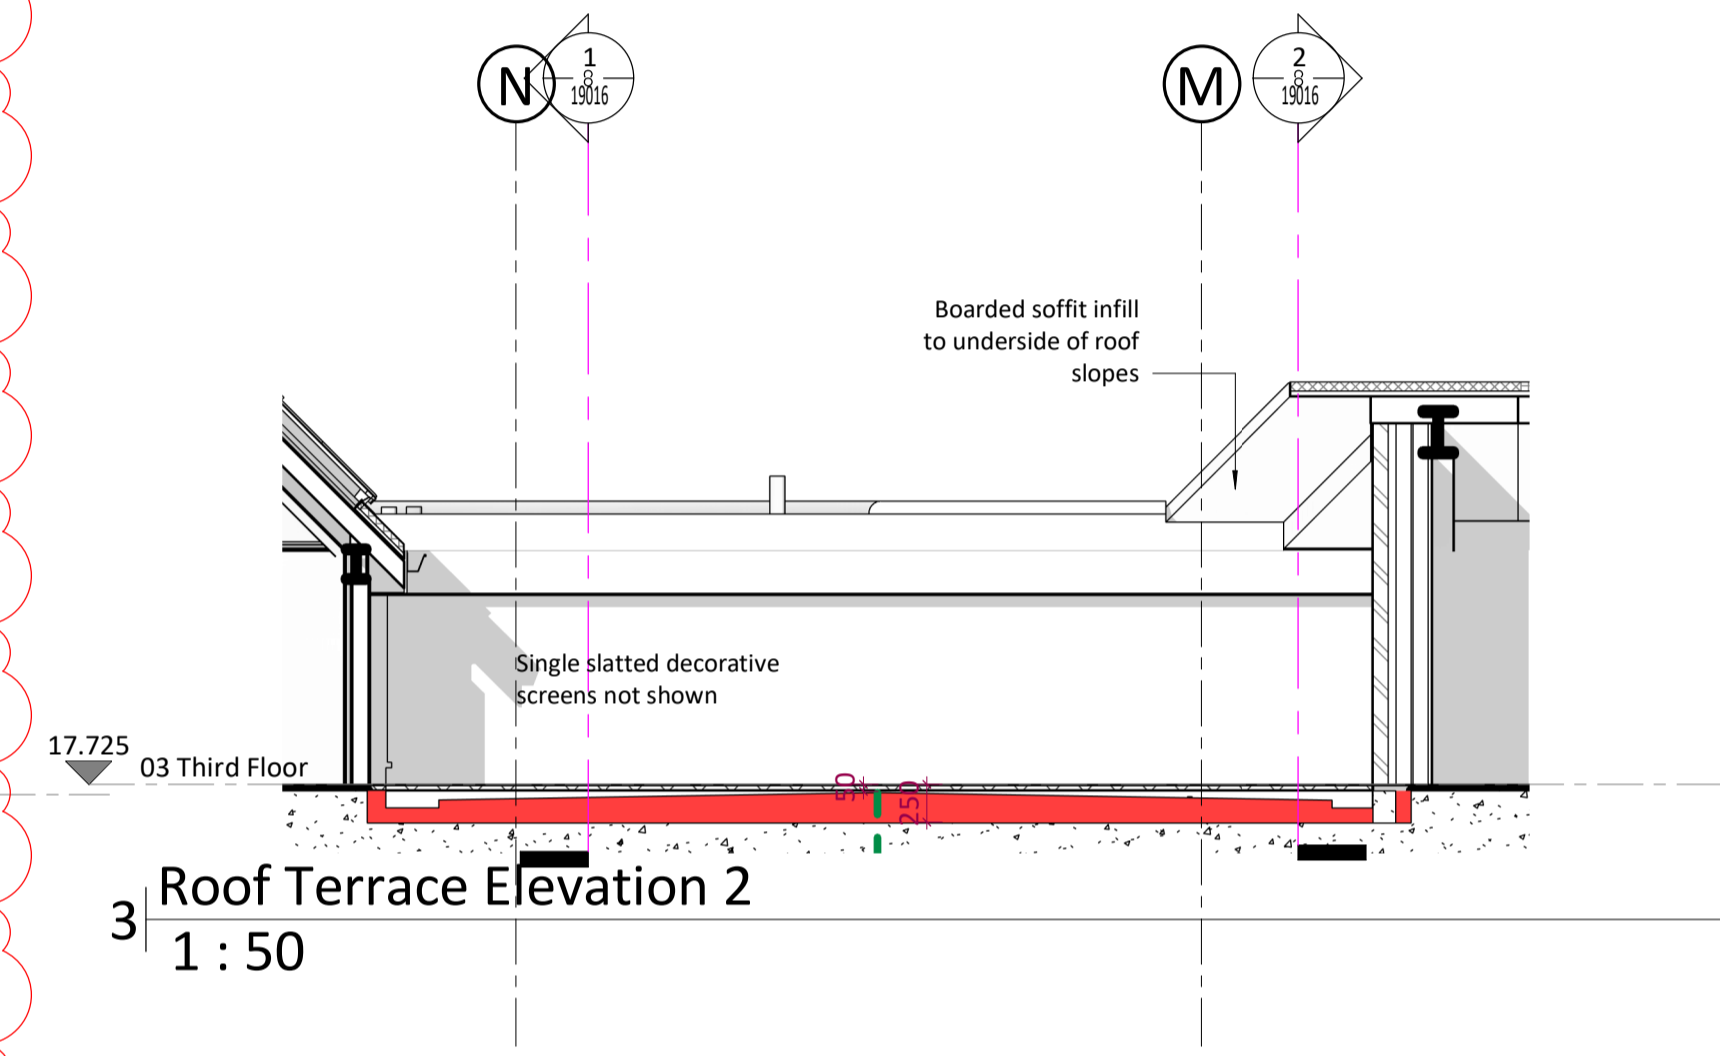


3 Roof Terrace Elevation 2
1 : 50

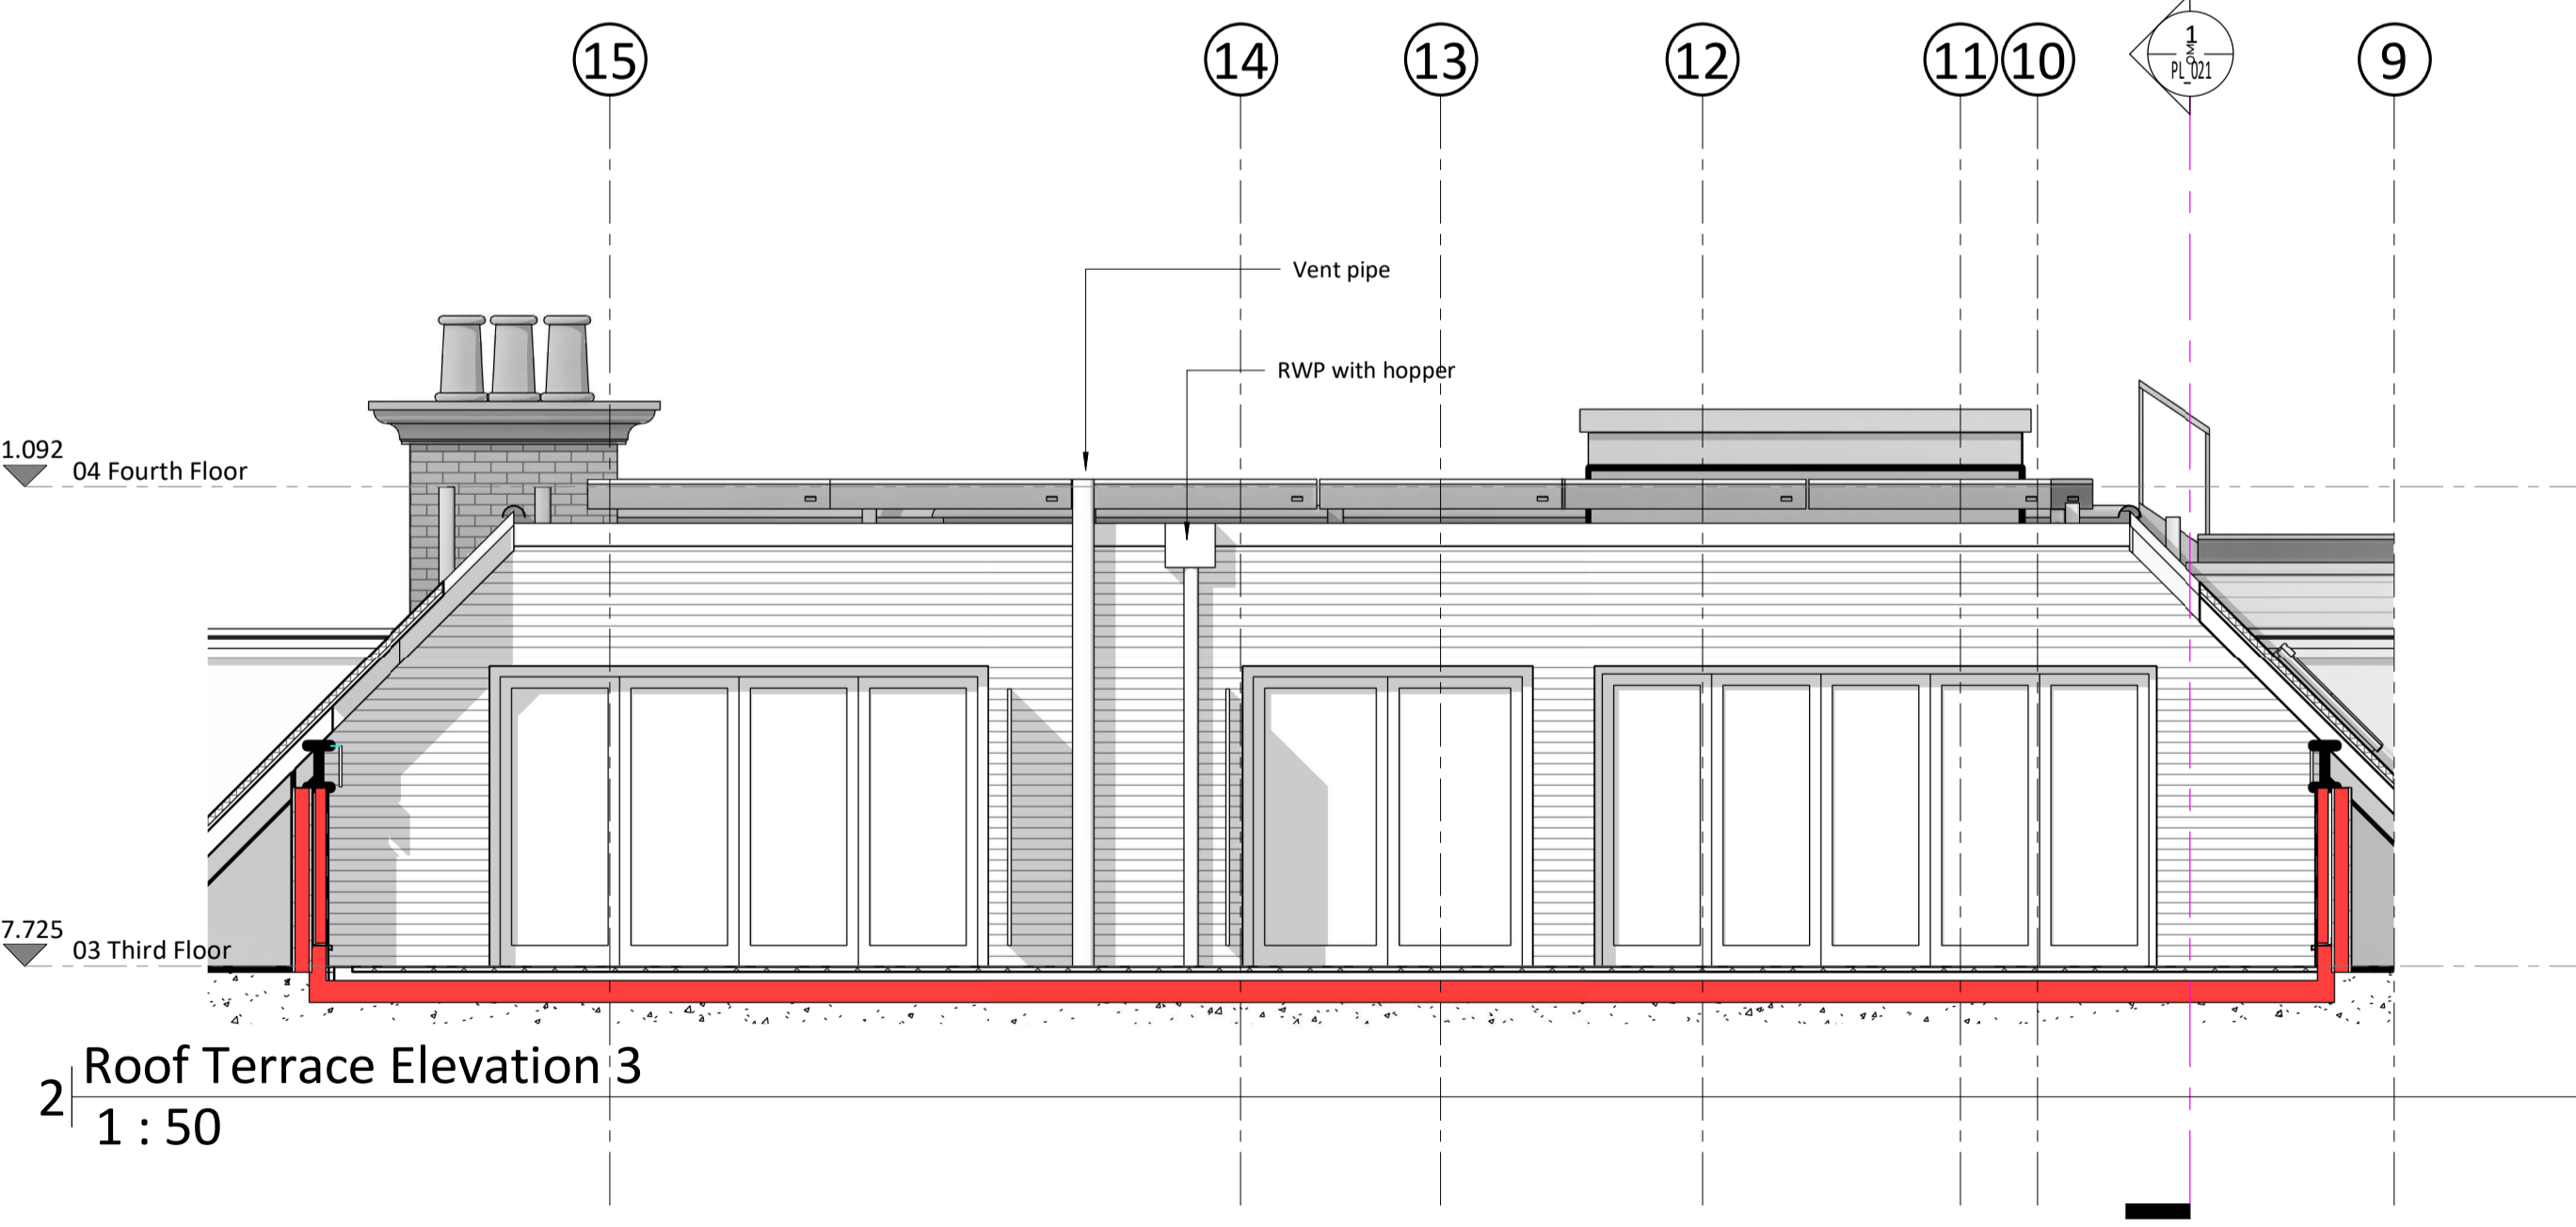

2 Roof Terrace Elevation 3
1 : 50

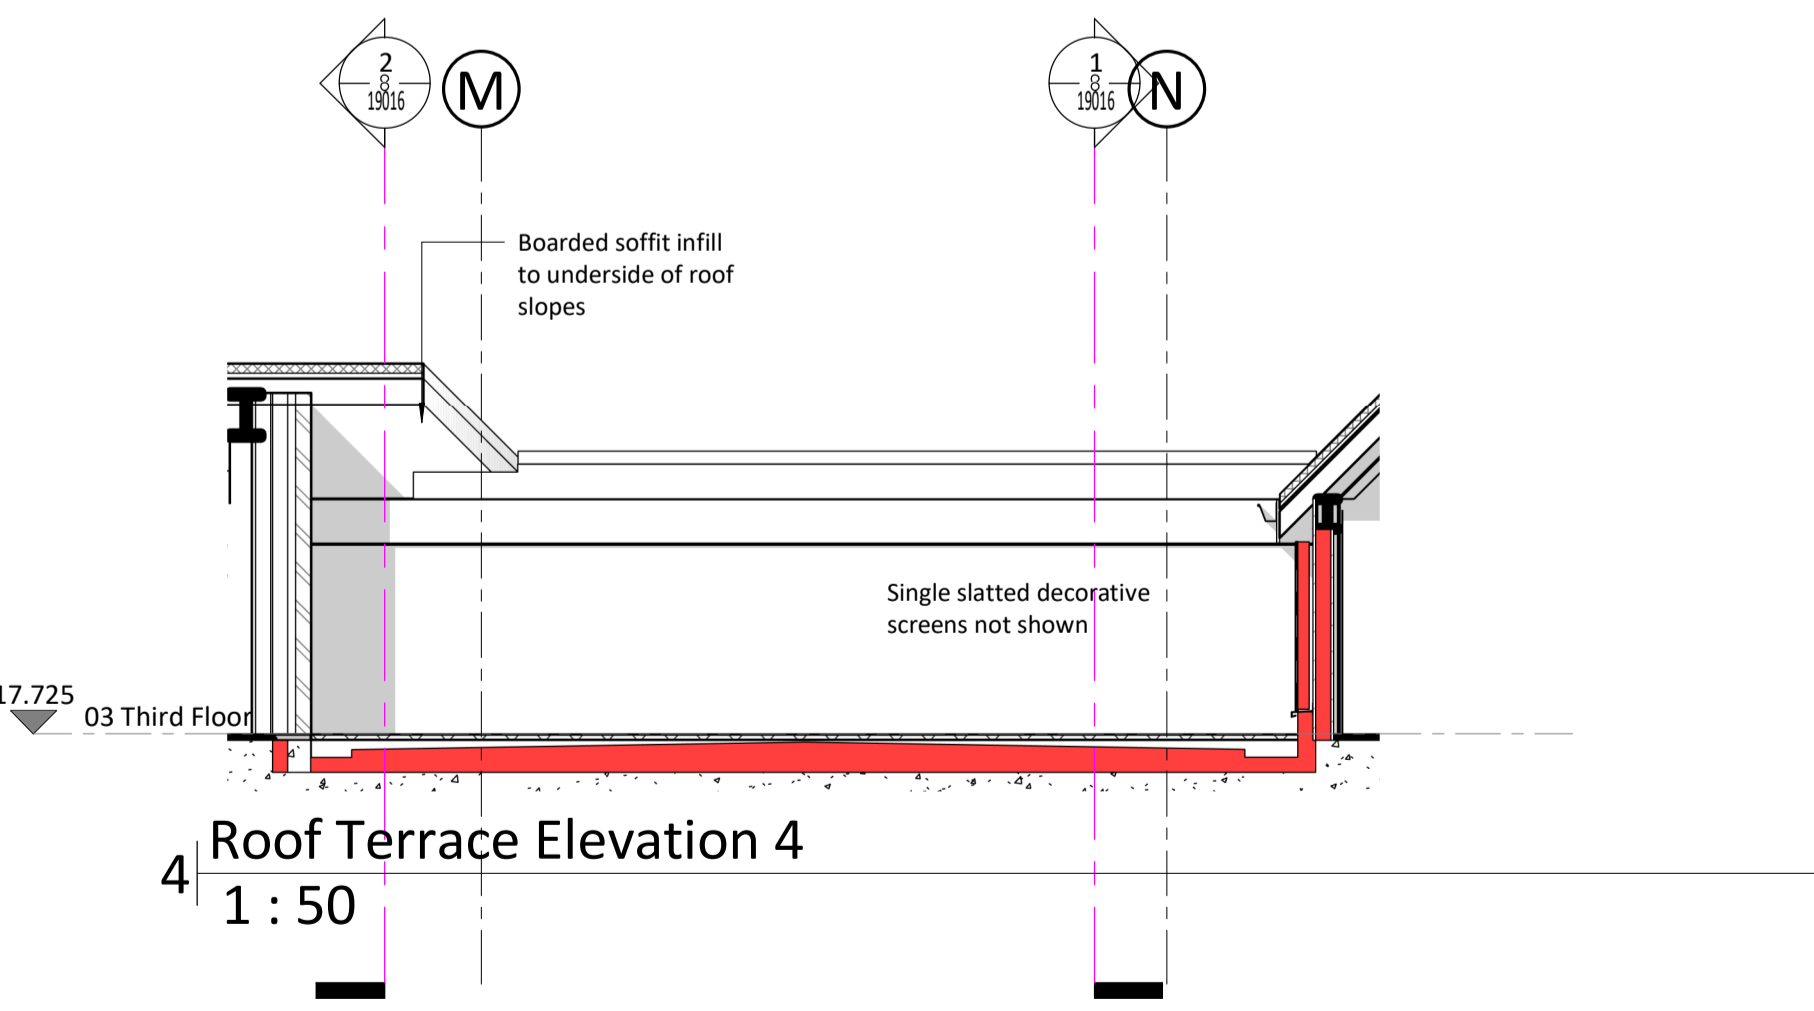

4 Roof Terrace Elevation 4
1 : 50

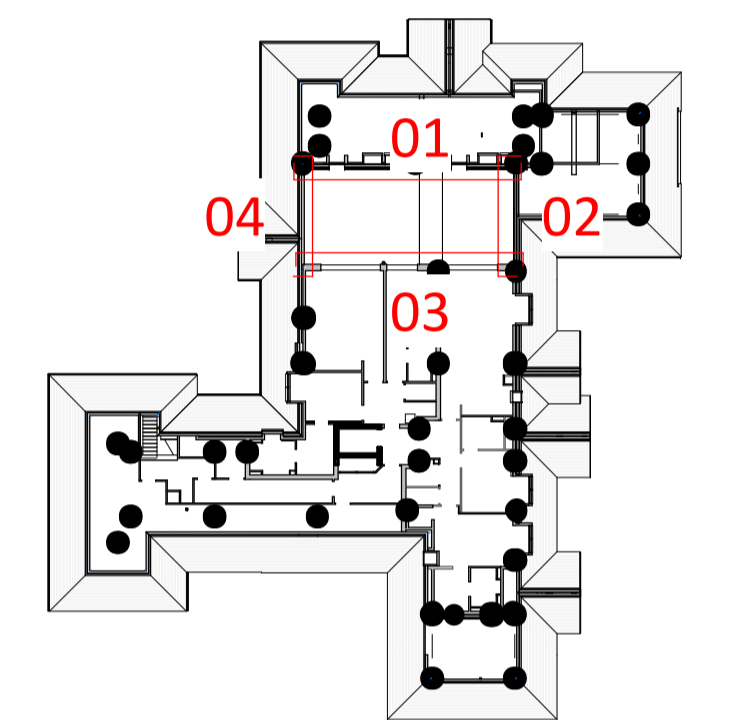

5 Key Plan
1 : 500

REV C7 - As-Built issue update following CIRC changes to the Rooflights

Rev	DESCRIPTION	DRW/CHK	Status	DATE
C7	As-Built Issue Update	MN/MN	AB	13/09/2021
C6	As-Built Issue Update	MN/MN	AB	23/08/2021
C5	Construction Issue Update	MN/MN	A	10/08/2021
C4	Construction Issue Update	MN/MN	A	02/08/2021
C3	Construction Issue Update	MN/MN	A	16/07/2021
C2	Construction Issue Update	MN/MN	A	09/07/2021
C1	Construction Issue Update	KP/MN	A	11/08/2020

CLIENT LOGO
CIRC Construction Management

ORIGINATOR
PRC 24 Church St. West, Woking, Surrey, GU21 6HT
01483 494 350
info@prc-group.com www.prc-group.com
Architecture: Planning, Master Planning, Urban Design, Interiors, Landscape
Offices: Woking, London, Milton Keynes, Warsaw

PROJECT
Mulberry Court, C102 11177

DRAWING TITLE
Roof Terrace Elevations

BIM FILE NAME

PROJECT STAGE
RIBA Stage 5 FIRST ISSUE DATE
08/03/20

STATUS CODE
CR : CONSTRUCTION RECORD SCALE
As indicated @ A1

PROJECT	ORIGINATOR	ZONE	LEVEL	TYPE	ROLE	NUMBER	REV
C102	PRC		03	DR	AR	19016	C7