
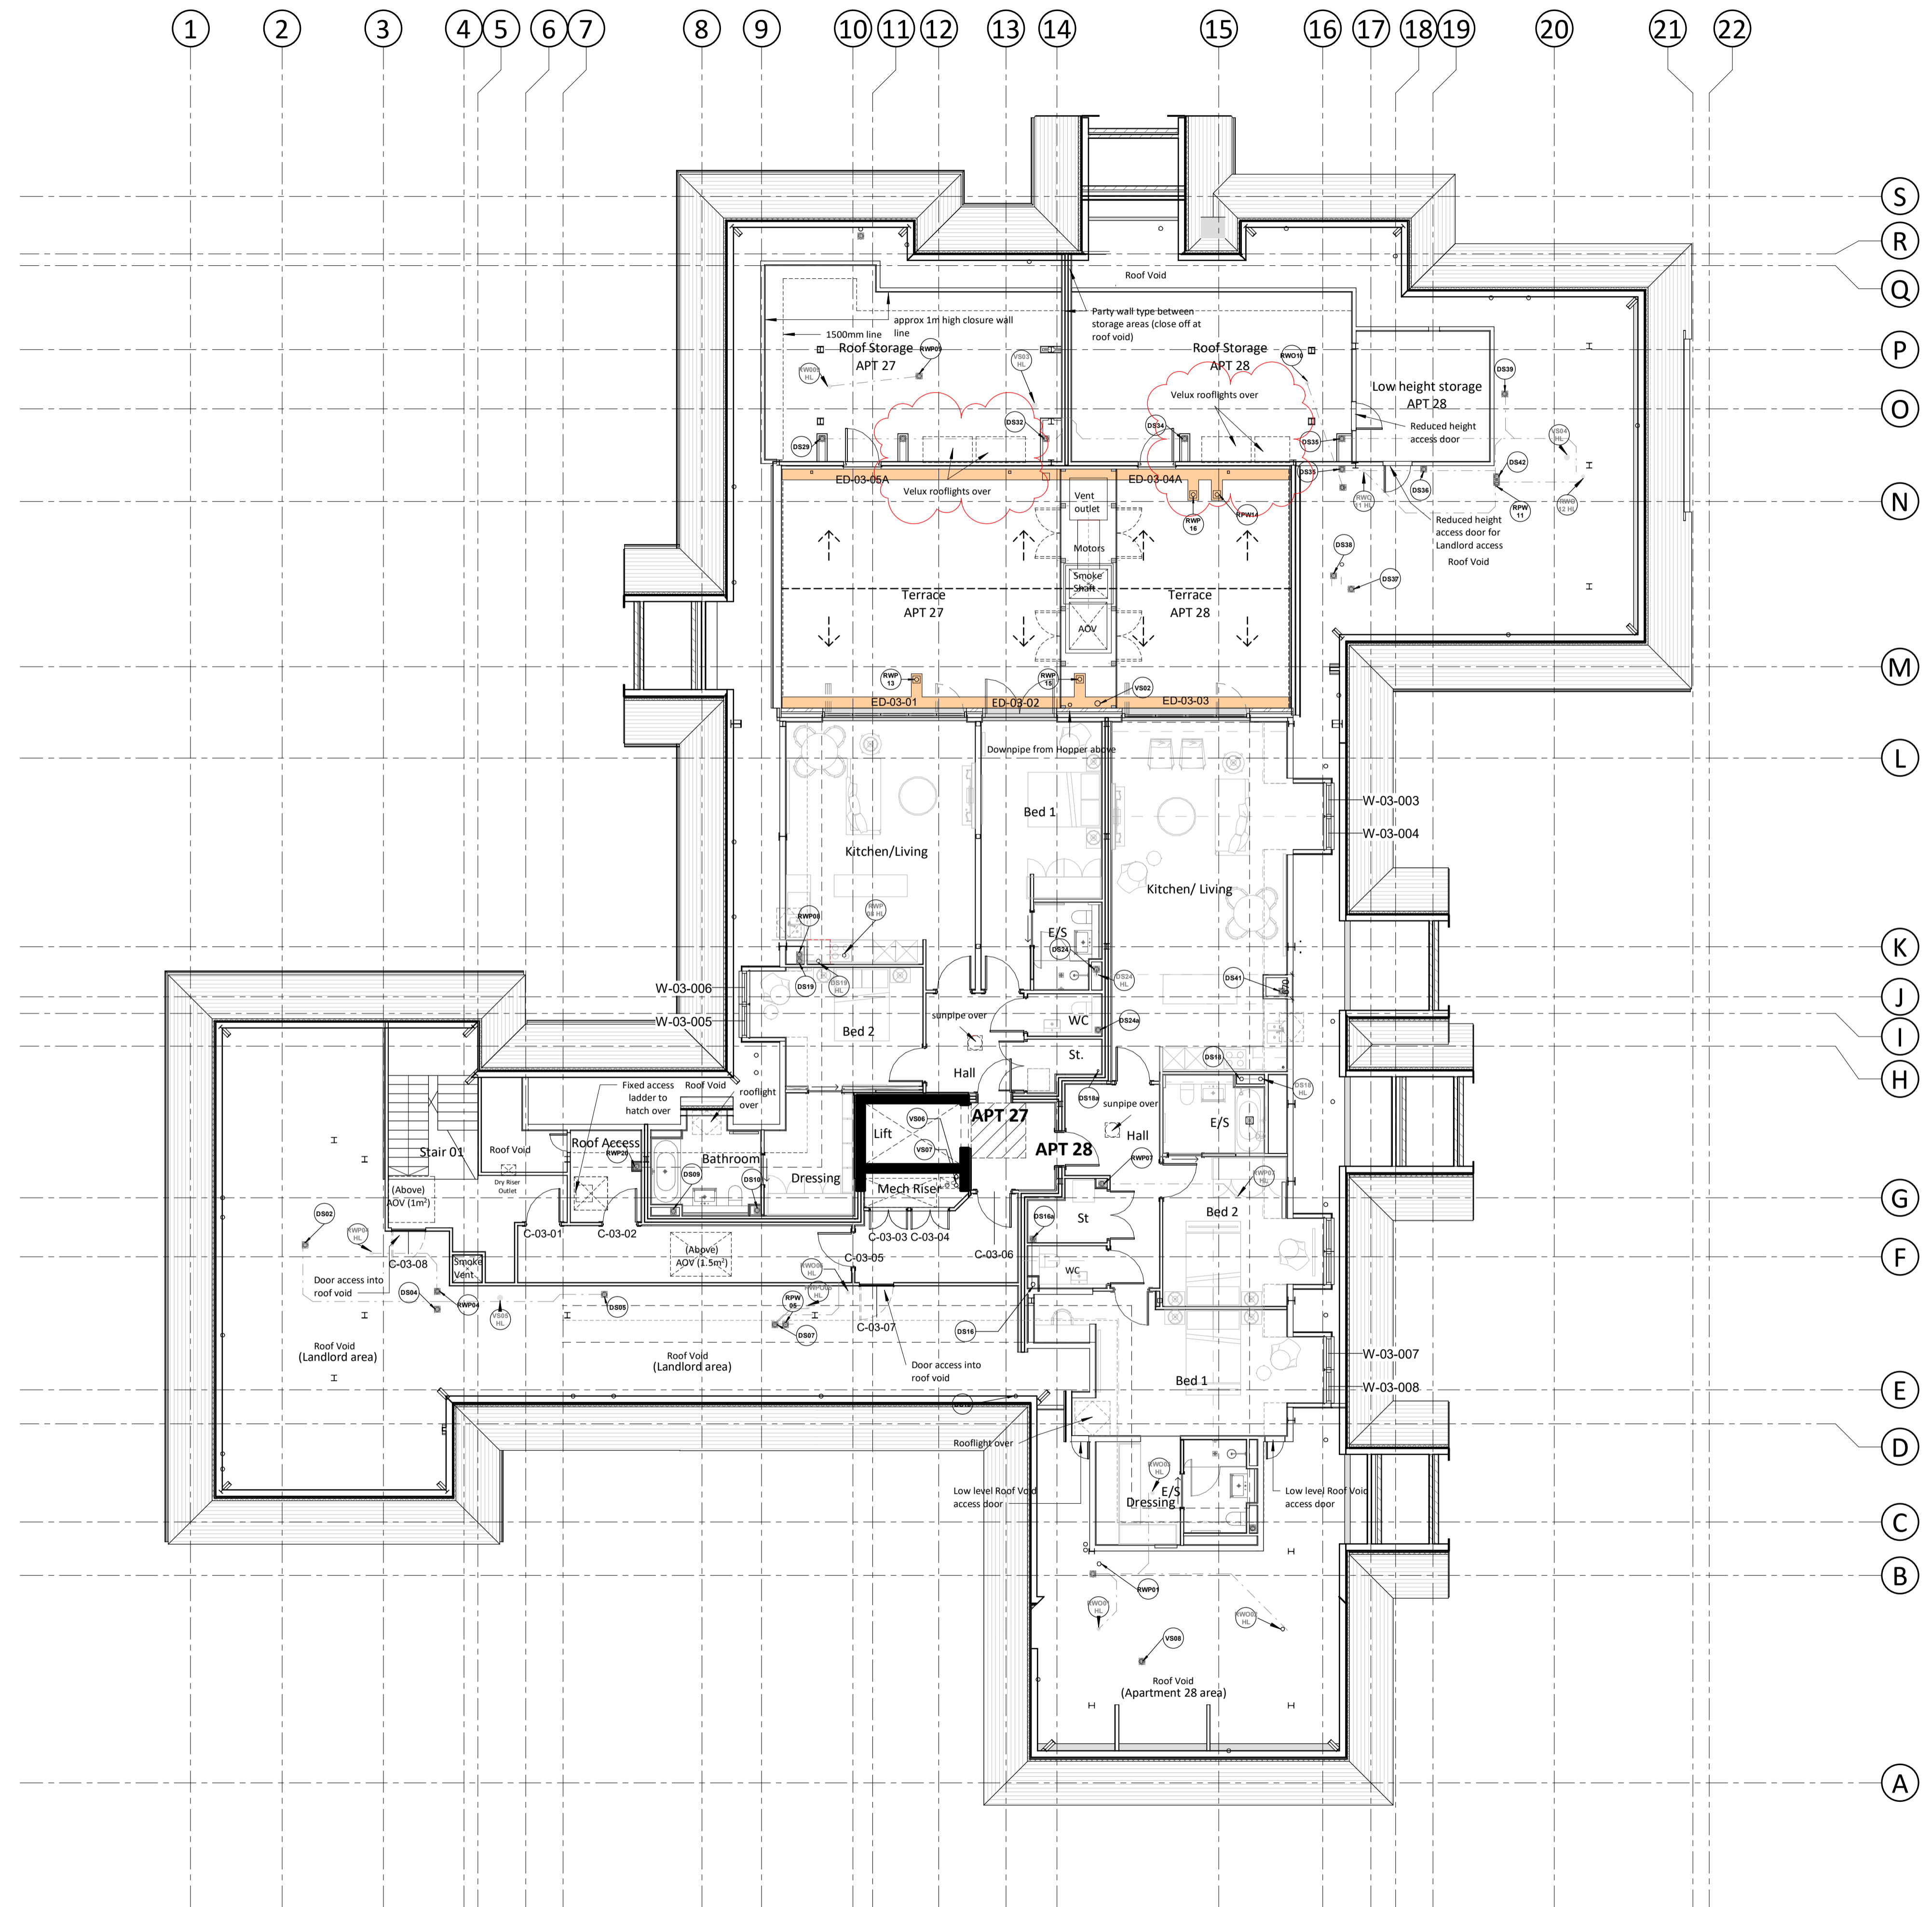


Responsibility is not accepted for errors made by others in scaling from this drawing.
All construction information should be taken from figured dimensions only.

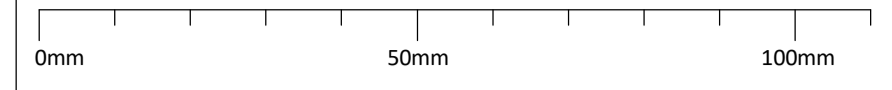

REV C10 - AS-BUILT ISSUE UPDATE

Rev	DESCRIPTION	DRW/CHK	Status	DATE
C10	As-Built Issue Update	MN/MN	AB	13/09/2021
C9	As-Built Issue	MN/MN	AB	23/08/2021
C8	As-Built Issue	MN/MN	AB	12/08/2021
C7	Construction Issue Update	MN/MN	A	02/08/2021
C6	Construction Issue Update	MN/MN	A	16/07/2021
C5	Construction Issue	MN/MN	A	09/07/2021
C4	Construction Issue Update	MN/MN	A	16/04/2021
C3	Update to Client Changes	KP/MN	A	06/08/2020
C2	Construction Issue Updated	MN/MAS	A	14/07/20

CLIENT LOGO

CIRC Construction Management

ORIGINATOR

24 Church St. West,
Woking, Surrey,
GU21 6HT
01483 494 350
info@prc-group.com
www.prc-group.com

Architecture
Planning
Master Planning
Urban Design
Interiors
Landscape

Offices
Woking
London
Milton Keynes
Warsaw

PROJECT 11177
Mulberry Court, C102

DRAWING TITLE
Third Floor Plan - Overall

BIM FILE NAME

PROJECT STAGE
RIBA Stage 5

FIRST ISSUE DATE
13.09.2019

STATUS CODE
CR : CONSTRUCTION RECORD

SCALE
1 : 100 @ A1

PROJECT	ORIGINATOR	ZONE	LEVEL	TYPE	ROLE	NUMBER	REV
C102	PRC		03	DR	AR	13005	C10

