



SCALE 1:50
SCALE 1:1

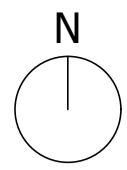


THE CONTRACTOR MUST VERIFY ALL DIMENSIONS ON SITE BEFORE MAKING SHOP DRAWINGS OR COMMENCING WORK OF ANY KIND. NO DIMENSIONS TO BE SCALED FROM THIS DRAWING.


REV. DATE REVISION

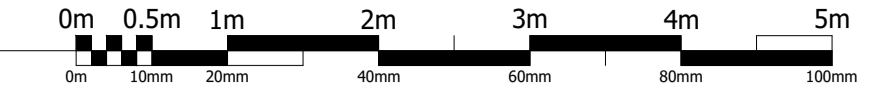

E1 PARK ROAD ELEVATION
Scale 1:50

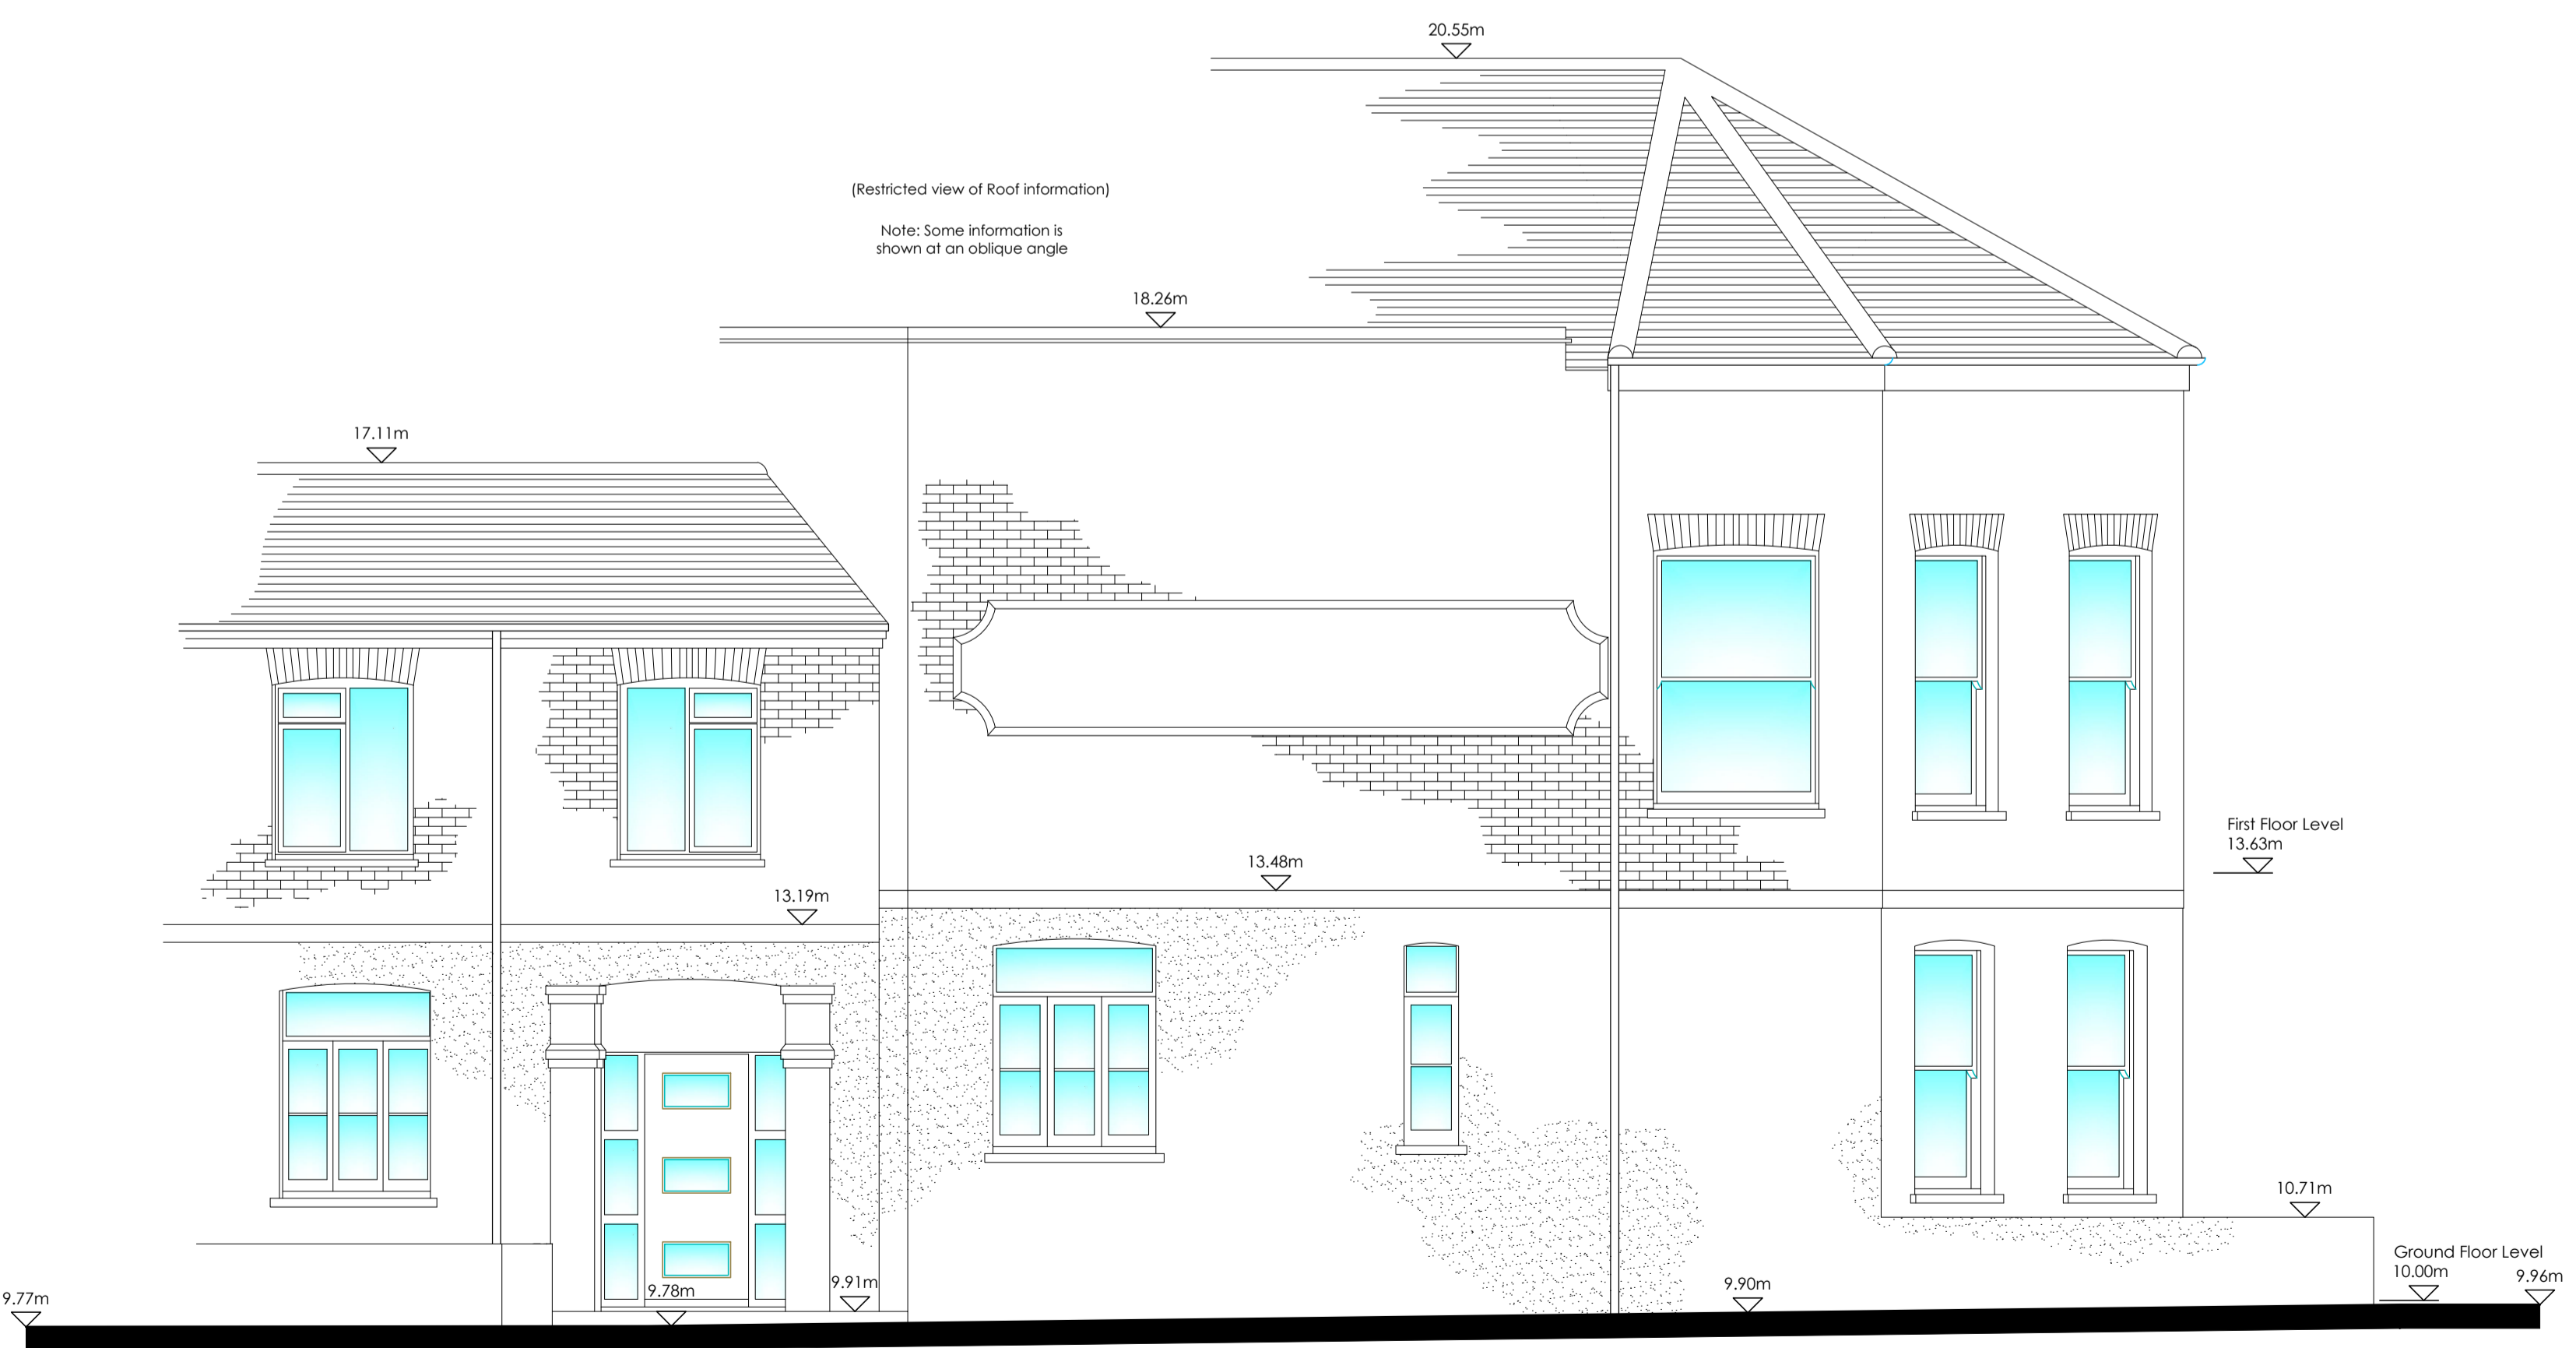

E2 SCHOOL ROAD ELEVATION
Scale 1:50

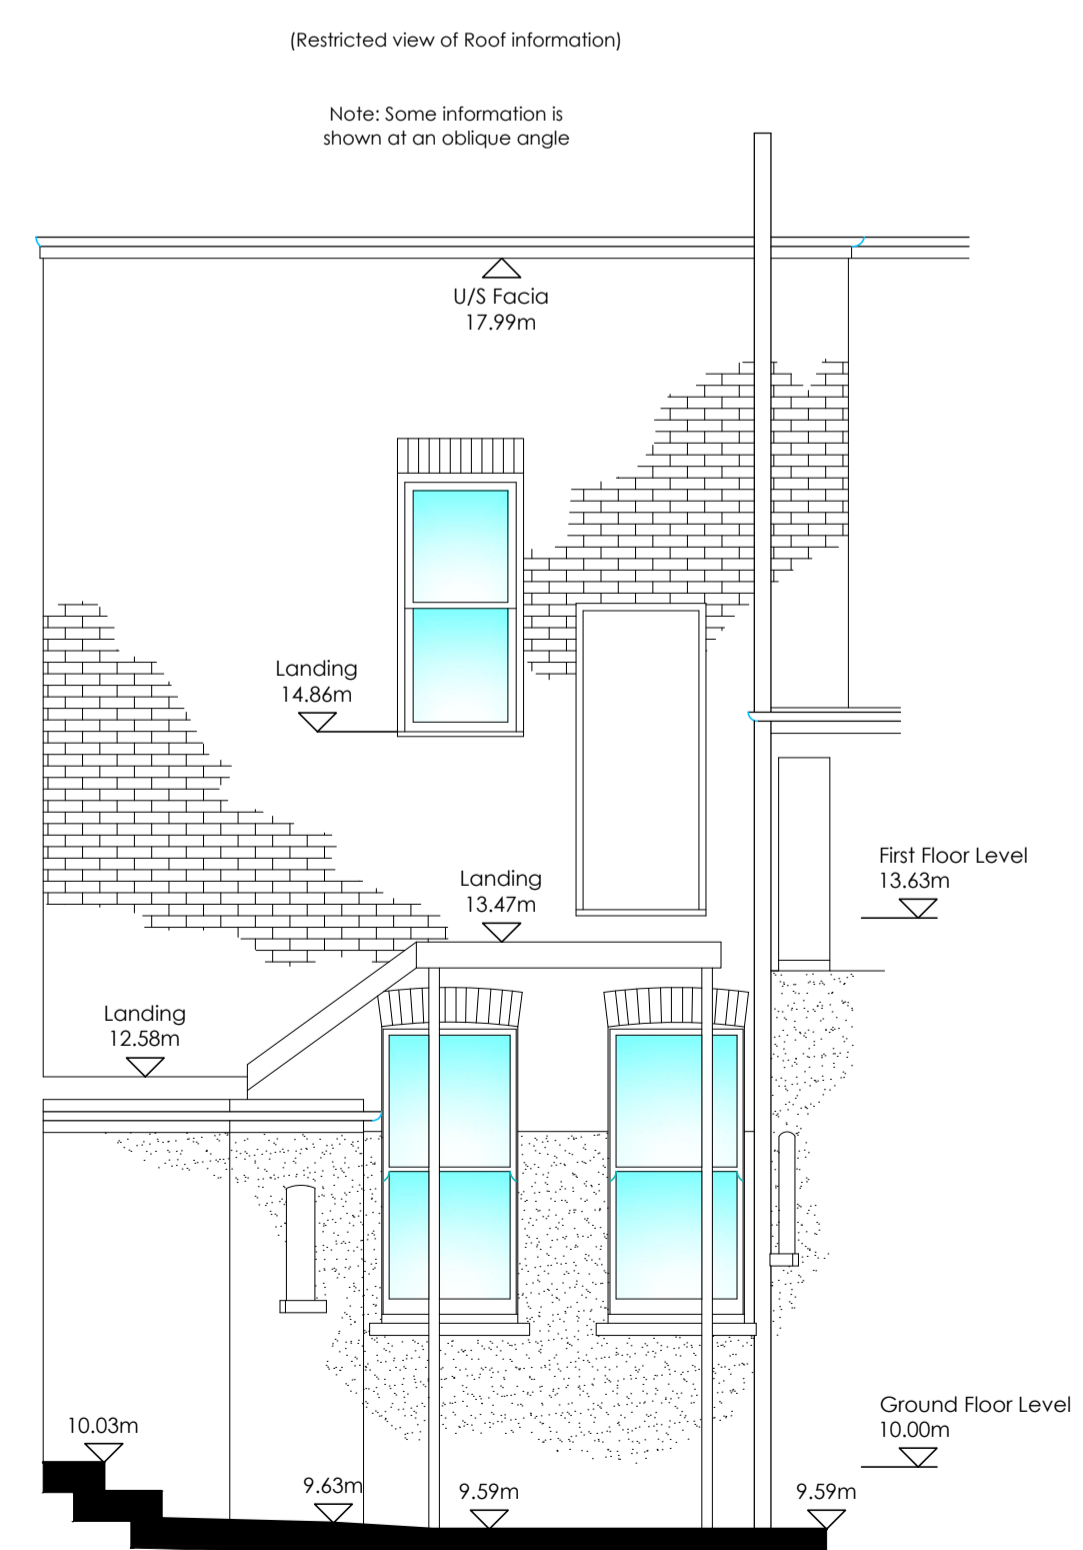

E3 COURTYARD ELEVATION
Scale 1:50

AS BUILT

Osel architecture

PROJECT: 12 PARK ROAD
HAMPTON WICK
RICHMOND KT1 4AS
CLIENT: BLUECREST LAND LTD.

DRAWING: EXISTING ELEVATIONS

DRAWING No.: E21-026/EXE001 REV: -

SCALE: 1:50@A1
DRAWN: VS DATE: JULY 2021
CHECKED: DATE:
G.04 | The Record Hall | 16-16A Baldwin's Gardens | London | EC1N 7RJ
Tel: 020 7224 2447

E-mail: admin@oselarch.co.uk Web: www.oselarchitecture.co.uk
©COPYRIGHT EXISTS ON THE DESIGNS AND INFORMATION SHOWN ON THIS DRAWING