


SCALE 1:50  
SCALE 1:1




THE CONTRACTOR MUST VERIFY ALL DIMENSIONS ON SITE BEFORE MAKING SHOP DRAWINGS OR COMMENCING WORK OF ANY KIND. NO DIMENSIONS TO BE SCALED FROM THIS DRAWING.


REV.	DATE	REVISION
A	15.01.22	Section added
B	28.11.22	Existing rooflights added

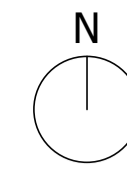

**E1** PARK ROAD ELEVATION  
Scale 1:50

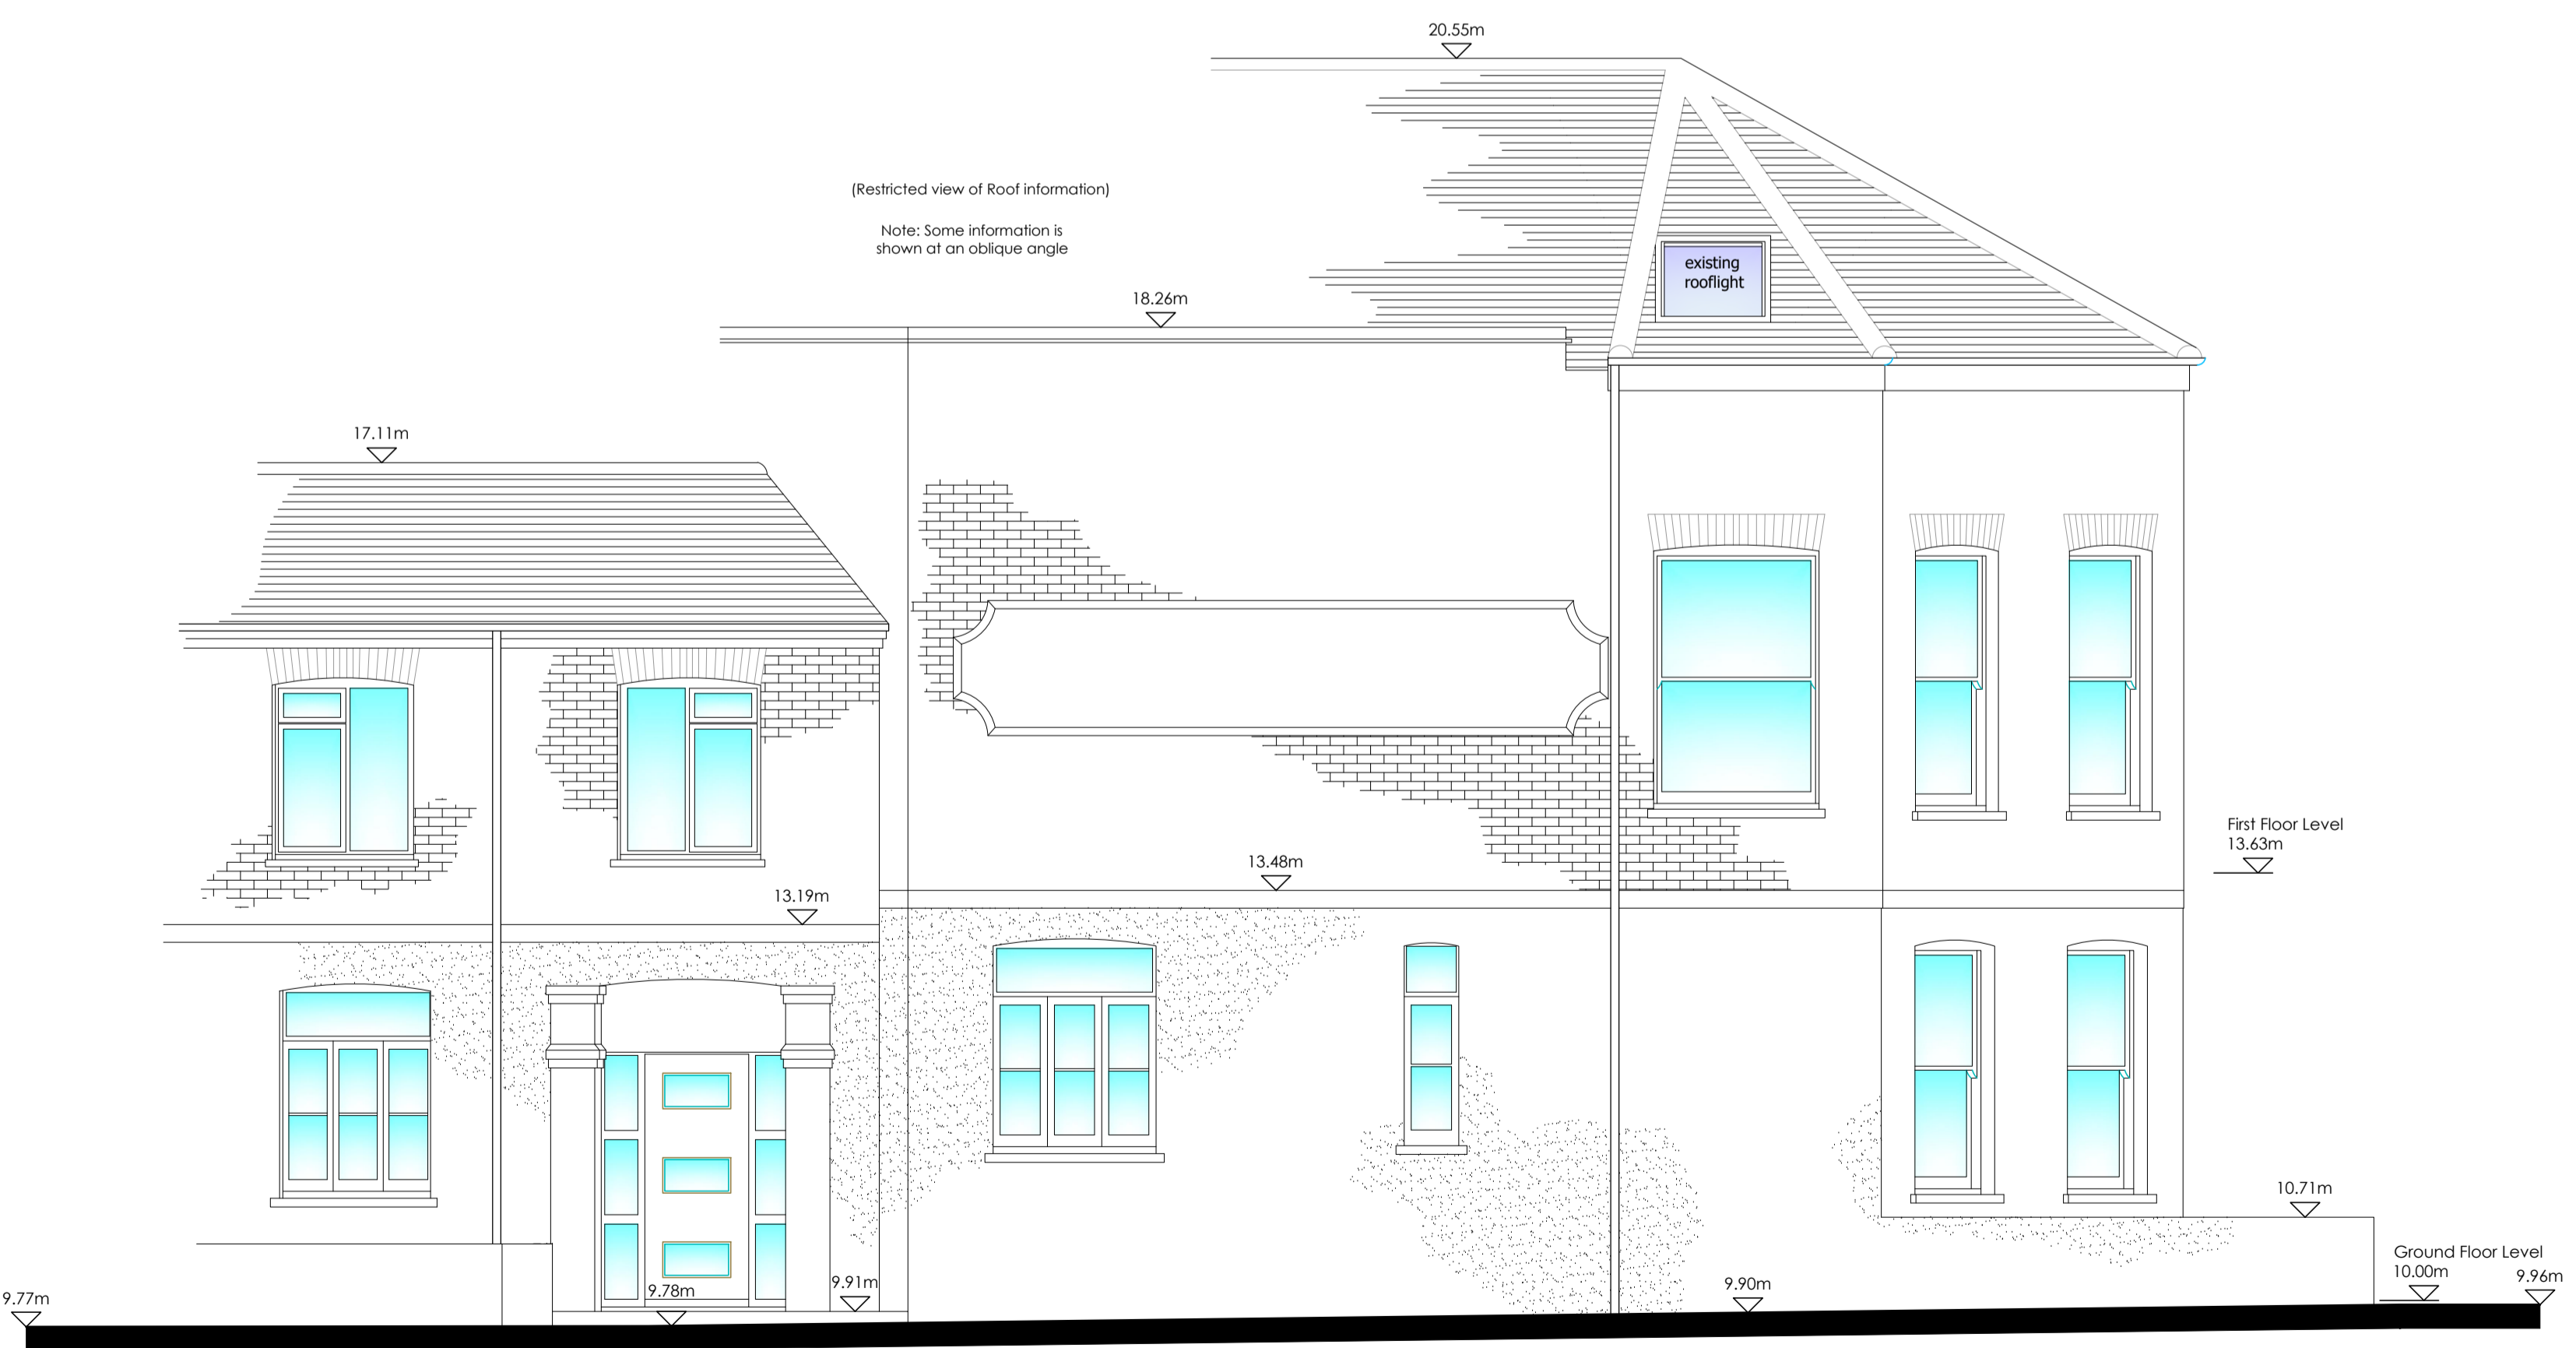

**E2** SCHOOL ROAD ELEVATION  
Scale 1:50

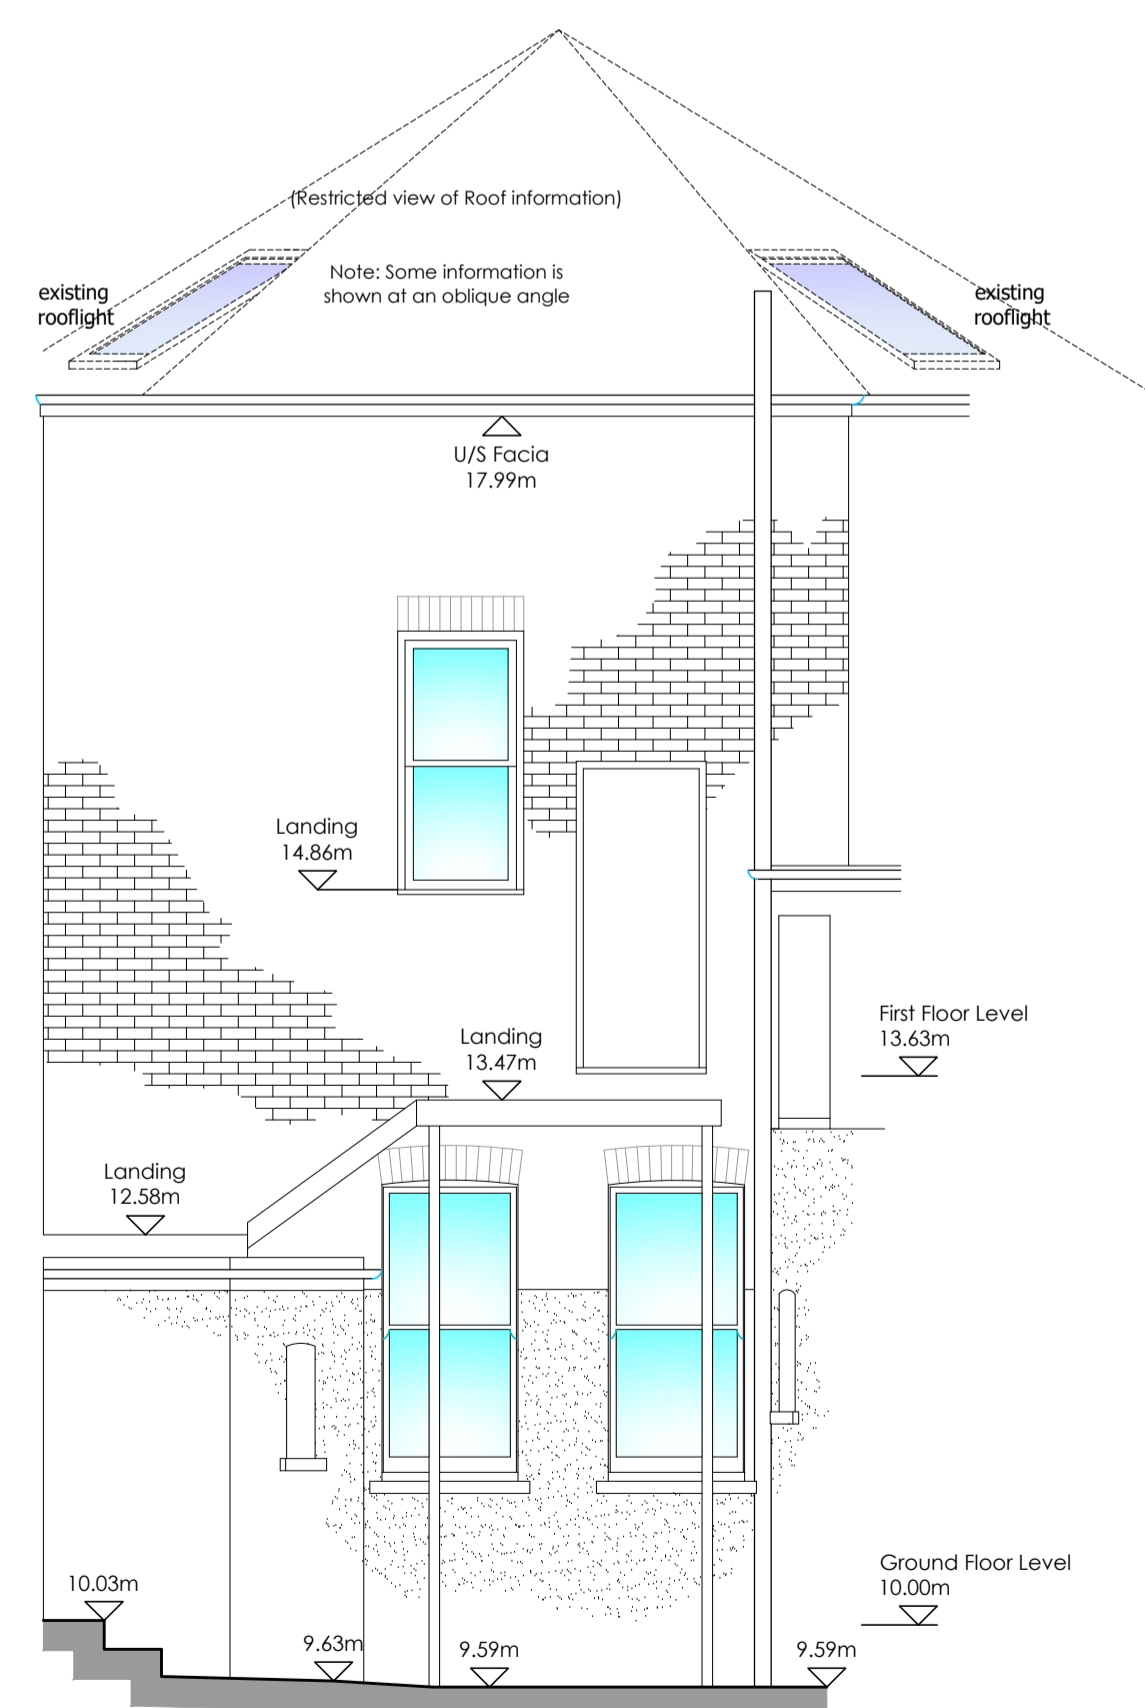

**E3** COURTYARD ELEVATION  
Scale 1:50

AS BUILT

Osel architecture

PROJECT: 12 PARK ROAD  
HAMPTON WICK  
RICHMOND KT1 4AS  
CLIENT: BLUECREST LAND LTD.

DRAWING: EXISTING ELEVATIONS

DRAWING No.: E21-026/EXE001 REV: B

SCALE: 1:50@A1  
DRAWN: VS DATE: JULY 2021  
CHECKED: DATE:  
G.04 | The Record Hall | 16-16A Baldwin's Gardens | London | EC1N 7RJ  
Tel: 020 7224 2447

E-mail: admin@oselarch.co.uk Web: www.oselarchitecture.co.uk  
©COPYRIGHT EXISTS ON THE DESIGNS AND INFORMATION SHOWN ON THIS DRAWING