

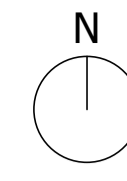


SCALE 1:50
SCALE 1:1

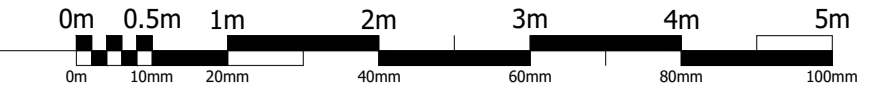

THE CONTRACTOR MUST VERIFY ALL DIMENSIONS ON SITE BEFORE MAKING SHOP DRAWINGS OR COMMENCING WORK OF ANY KIND. NO DIMENSIONS TO BE SCALED FROM THIS DRAWING.

REV.	DATE	REVISION
A	15.01.22	Section lines added
B	28.11.22	New rooflights added

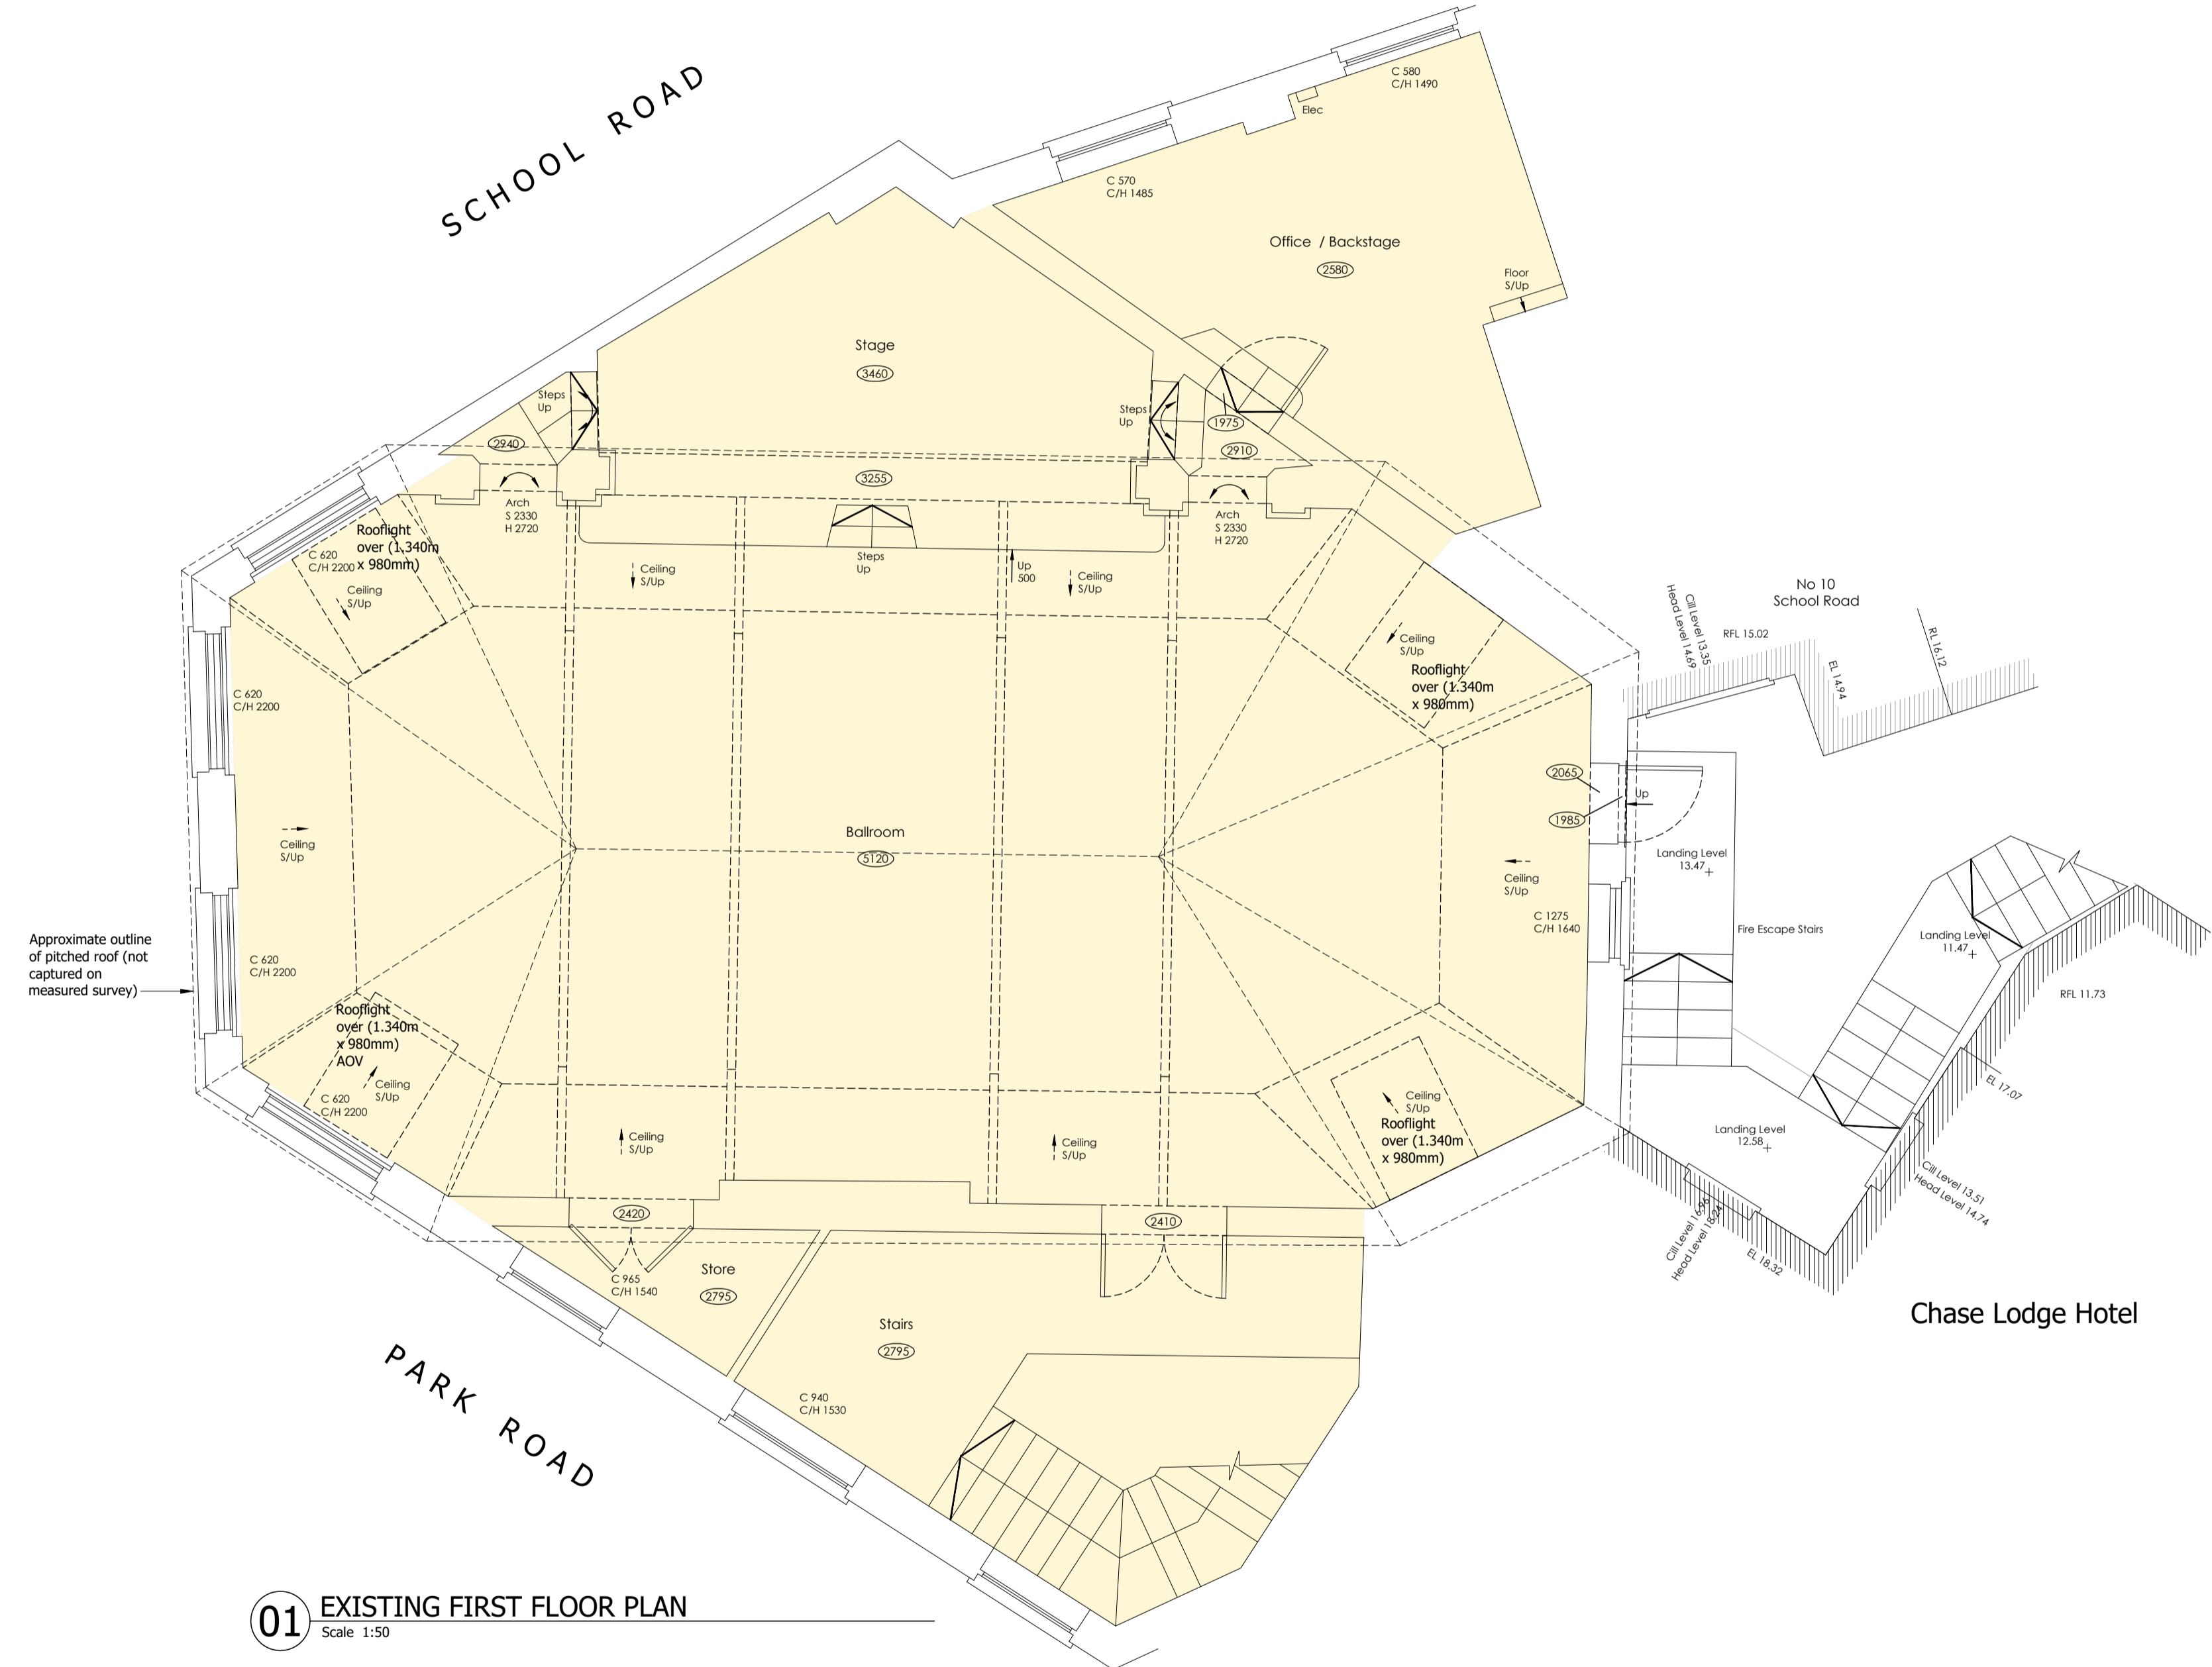

Approximate outline of pitched roof (not captured on measured survey)

01 EXISTING FIRST FLOOR PLAN
Scale 1:50

AS BUILT

Measured survey produced by:
Perceptum Design June 2015

Osel architecture

PROJECT:
12 PARK ROAD
HAMPTON WICK
RICHMOND KT1 4AS

CLIENT:
BLUECREST LAND LTD.

DRAWING:
EXISTING
FIRST FLOOR PLAN

DRAWING No.: **E21-026/EXP001** REV: **B**

SCALE: 1:50@A1
DRAWN: VS DATE: JULY 2021
CHECKED: DATE:

G.04 | The Record Hall | 16-16A Baldwin's Gardens | London | EC1N 7RJ
Tel: 020 7224 2447

E-mail: admin@oselarch.co.uk Web: www.oselarchitecture.co.uk
©COPYRIGHT EXISTS ON THE DESIGN AND INFORMATION SHOWN ON THIS DRAWING