
N S N

THE CONTRACTOR MUST VERIFY ALL DIMENSIONS ON SITE BEFORE MAKING SHOP DRAWINGS OR COMMENCING WORK OF ANY KIND. NO DIMENSIONS TO BE SCALED FROM THIS DRAWING.

REV. DATE REVISION

A 15.01.22 Section lines added

B 28.11.22 New rooflights added

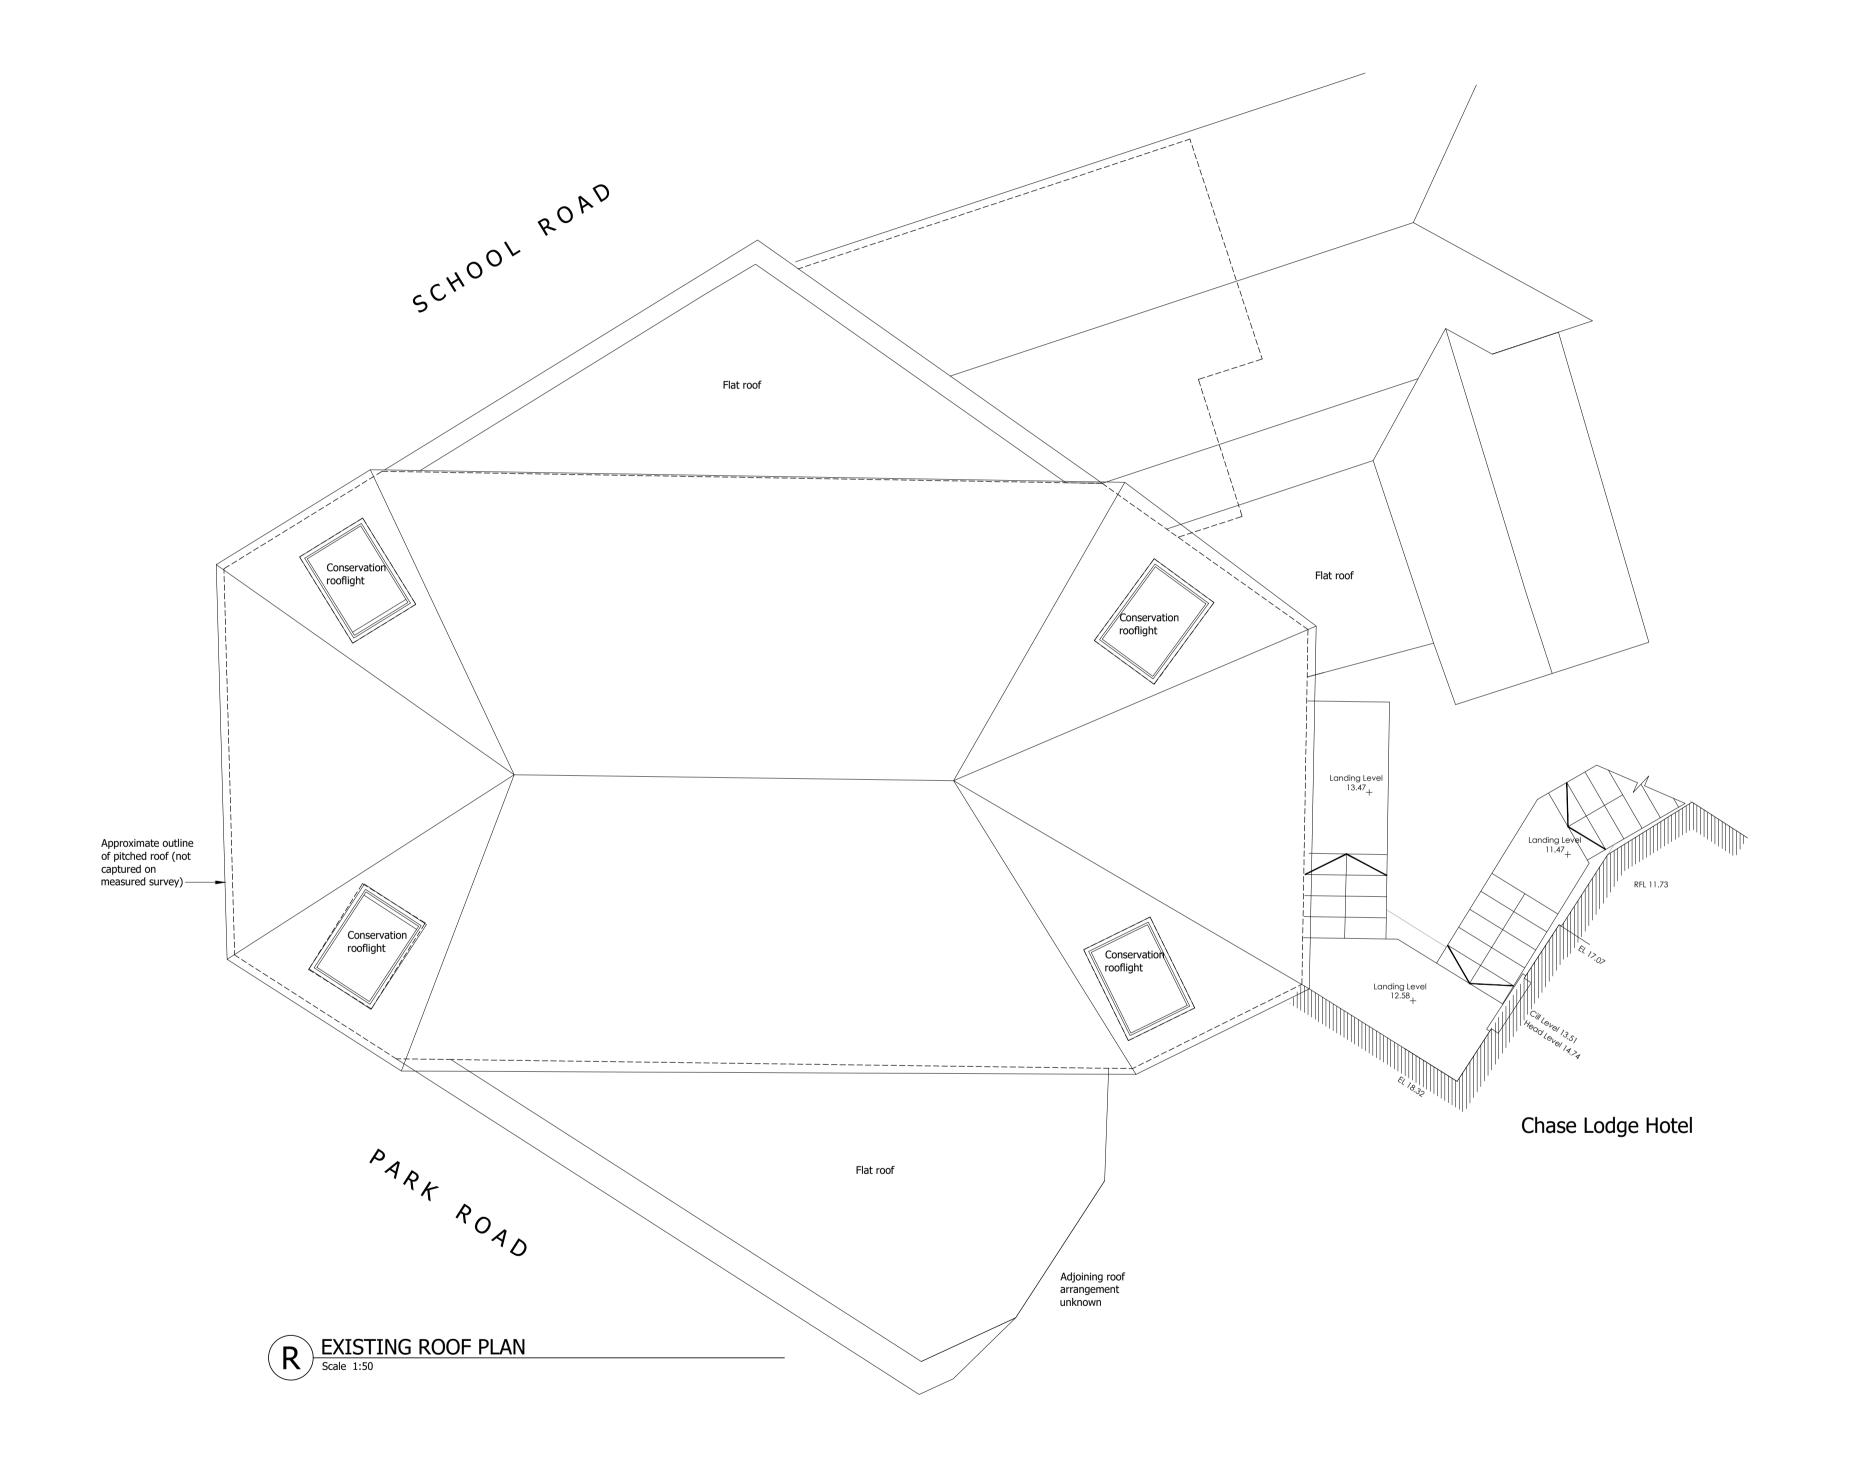

AS BUILT

## Osel architecture

PROJECT:

12 PARK ROAD HAMPTON WICK RICHMOND KT1 4AS

CLIENT:

BLUECREST LAND LTD.

DRAWING:

EXISTING ROOF PLAN

DRAWING No.: **E21-026/EXP001** 

SCALE: 1:50@A1

DRAWN: VS DATE: JULY 2021

CHECKED: DATE:
G.04 | The Record Hall | 16-16A Baldwin's Gardens | London | EC1N 7RJ
Tel: 020 7224 2447

E-mail: admin@oselarch.co.uk Web: www.oselarchitecture.co.uk ©COPYRIGHT EXISTS ON THE DESIGNS AND INFORMATION SHOWN ON THIS DRAWING