


GROUND FLOOR EXISTING
88m²

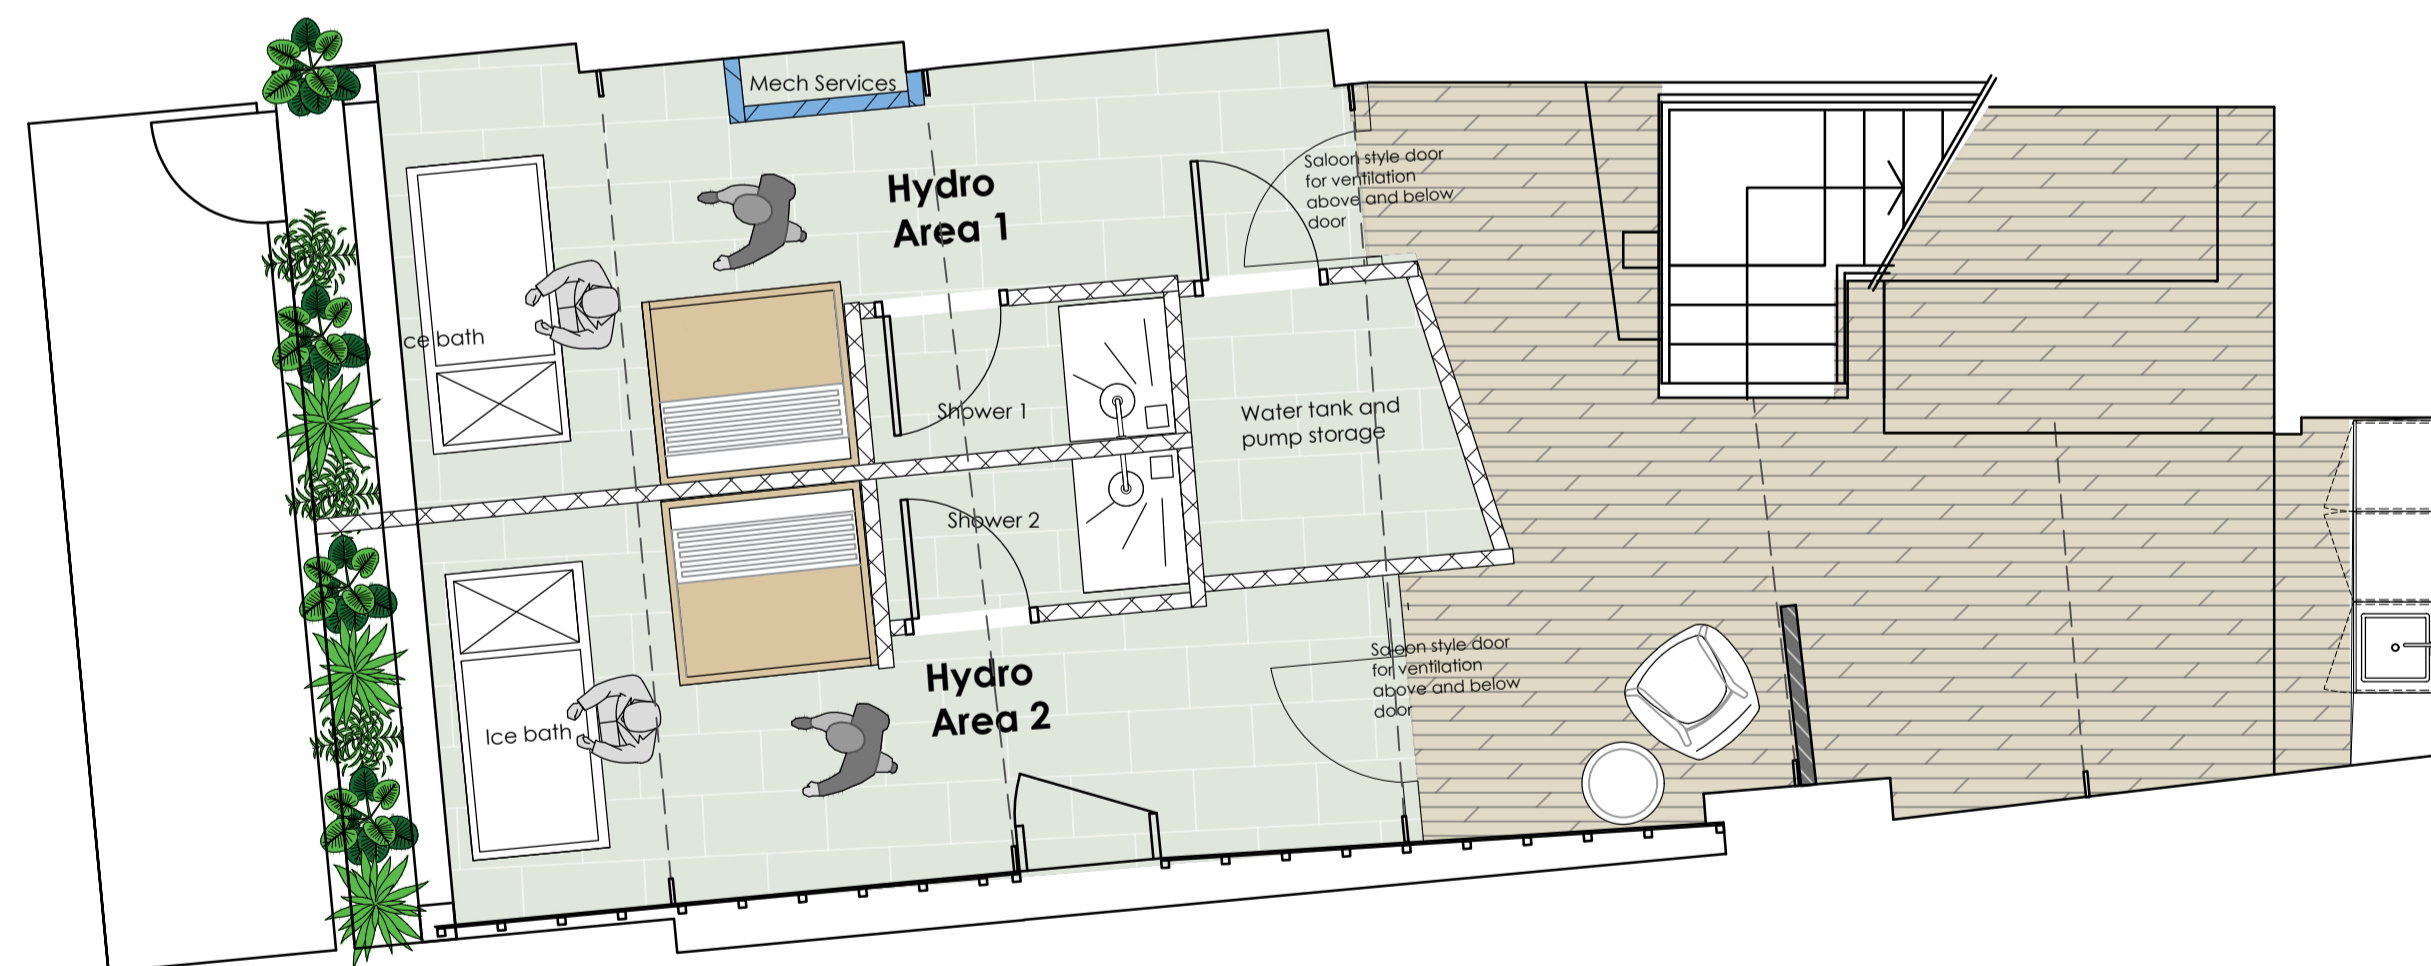

BASEMENT EXISTING
66m²

EXISTING FLOR PLANS

| REV | DESCRIPTION | AM | DATE |
|-----|-----------------|----|----------|
| - | AS BUILTS ISSUE | AM | 01/03/24 |

DRAWING STAGE:
AS BUILTS

CLIENT:
KOYO

SITE ADDRESS:
7 The Quadrant

RICHMOND
TW9 1BP

PROJECT DIRECTOR:
JACOB LEE

PROJECT DESIGNER:
SUSAN BOLD

DRAWING TITLE:
GROUND AND BASEMENT GENERAL
ARRANGEMENT PLAN - 1002

SCALE: 1:50 PAPER SIZE: A1 DRAWN BY: AM DATE: 01.03.24

PROJECT NO.: ES23203 BLD. NO.: 01 FLOOR: G & B DETAIL: GA STATUS: AB REV.: AB

