
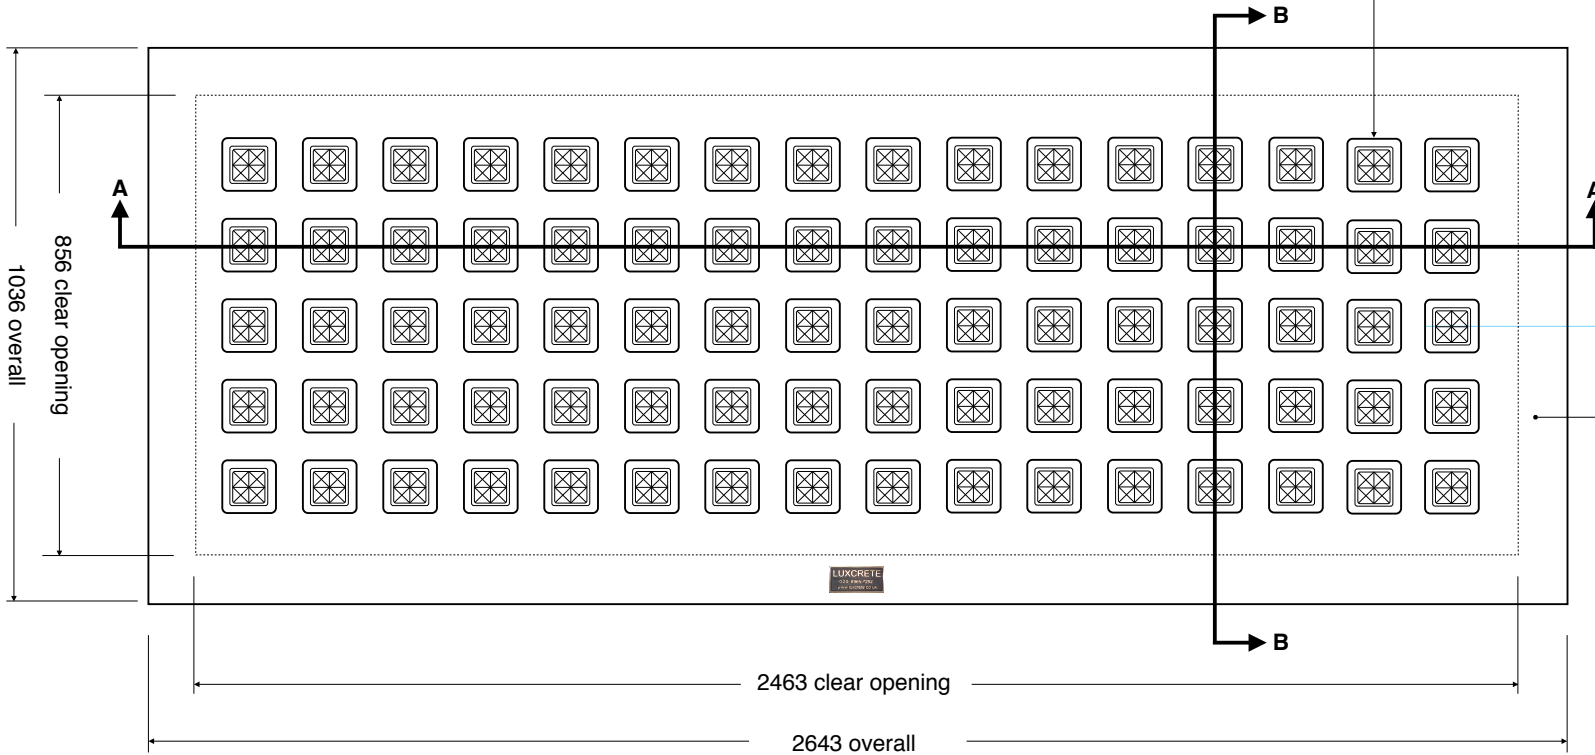



Section A - A

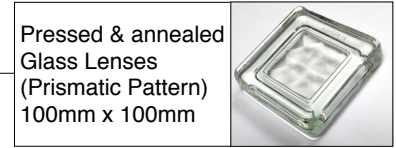

Plan View

AS BUILT

ETN-LUX-XX-00-DR-X-0001 AB

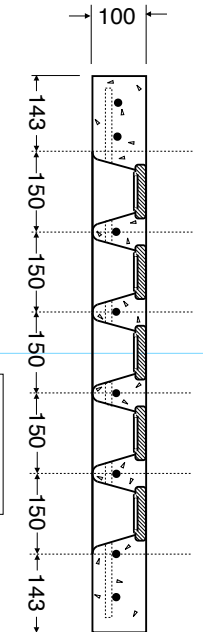

Section B - B

Concrete Grade: C40
Colour: Natural Light Grey
Top face to have a trowelled finish and the soffit to be 'as cast'

luxcrete
Unit 2, Firbank Industrial Estate,
Dallow Road, Luton Lu1 1TW

Tel: 01582 488767
Email: enquiries@luxcrete.co.uk
web: www.luxcrete.co.uk