


revision d : as-built roof plan, 31.08.16
 revision c : two central rwp's removed, as Client instruction, adjacent U4 and U1, 09.08.12
 revision b : further notes added to fall arrest system, rwp's added to unit 4 and 1, TENDER ISSUE, 21.12.11
 revision a : arrest wire added to unit 6 roof, velux rooflights location moved 343 up roof, to coordinate with first floor plan, 02.12.11

do not scale from this drawing.
 verify all dimensions by the measurements.
 errors and omissions to be reported to the architect.
 copyright

drawing status

Drawing issued for Planning purposes only

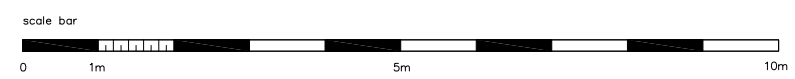

notes

1. Final coordination of drawings and information with ADS Associates and Mecserve to be finalised on later issues of this drawing. Any discrepancies to be reported to the architect

title	Proposed Roof Plan	client	Charles Richards	project	Proposed B1 units on land to rear of 33 - 57 Grosvenor Road Twickenham, Middlesex TW1 4AD	drawing number	165.102d
scale	1:50@A1 / 1:100@A3	drawn	gt	Genevieve Therault Architecture & Interiors 42 Brook Street, London W1K 5DB t: 07904 974 066 e: mail@genevieveherault.com			
date	12.08.11	checked					