



North East elevation - part to courtyard



Proposed North West Elevation (to proposed courtyard)

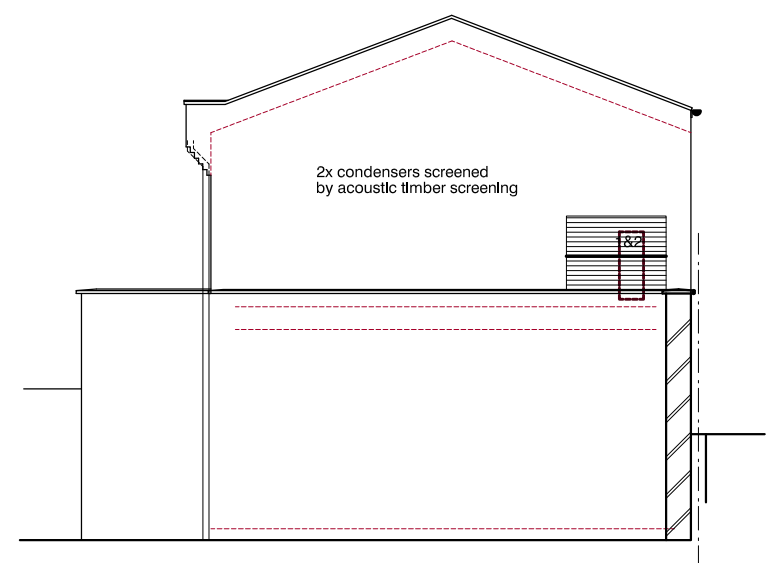

North West Elevation to Units 1 and 2 from garden of 31 Grosvenor Road

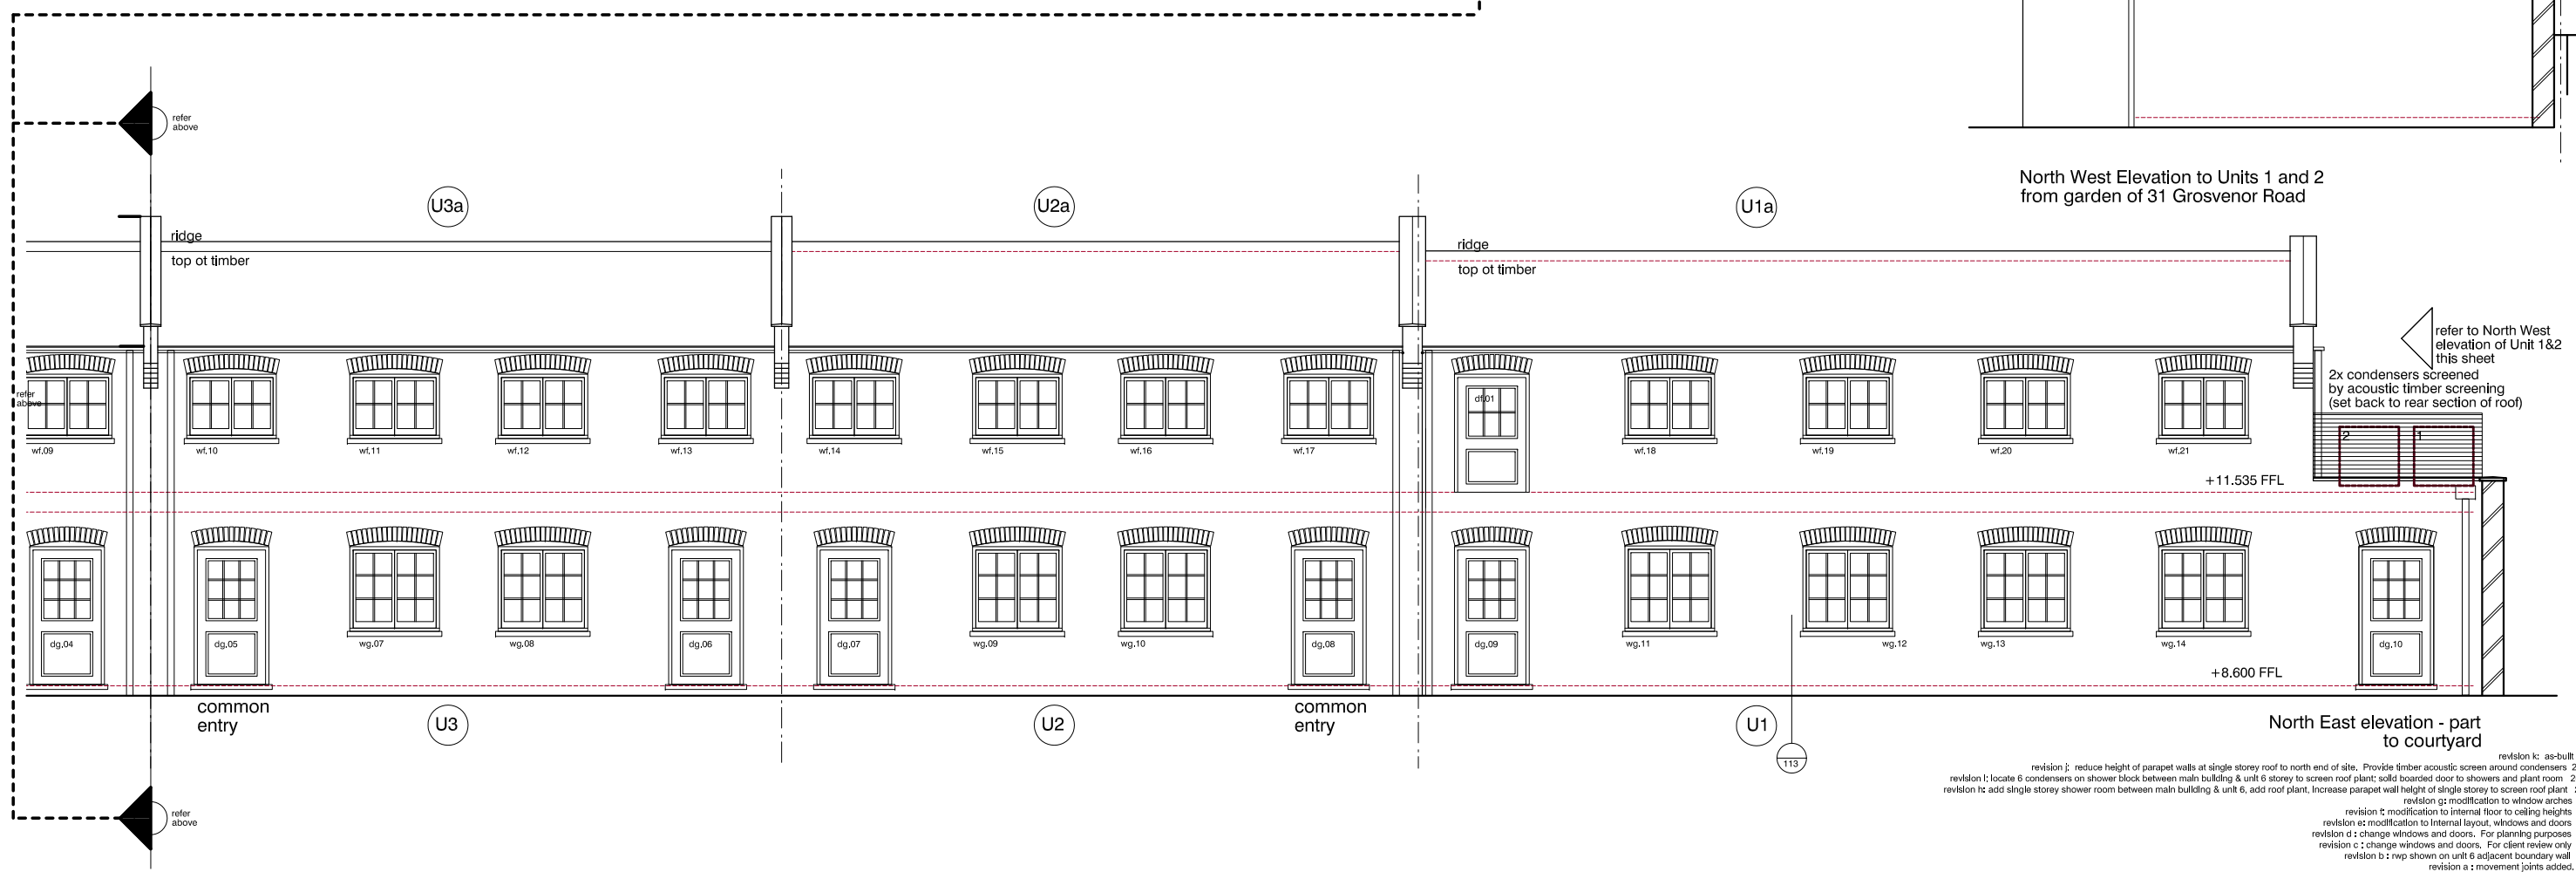


North East elevation - part to courtyard

- revision k: as-built 31.08.16
- revision j: reduce height of parapet walls at single storey roof to north end of site. Provide timber acoustic screen around condensers 28.01.16
- revision i: locate 6 condensers on shower block roof plant; solid boarded door to showers and plant room 20.10.15
- revision h: add single storey shower room between main building & unit 6, add roof plant. Increase parapet wall height of single storey to screen roof plant 21.07.15
- revision g: modification to window arches 24.02.14
- revision f: modification to internal floor to ceiling heights 26.11.13
- revision e: modification to internal layout, windows and doors 09.10.13
- revision d: change windows and doors. For planning purposes 28.08.13
- revision c: change windows and doors. For client review only 28.08.13
- revision b: rwp shown on unit 6 adjacent boundary wall 21.12.11
- revision a: movement joints added. 02.12.11

do not scale from this drawing.  
verify all dimensions by site measurement.  
errors and omissions to be reported to the architect.  
copyright.

Drawing issued for Planning purposes only

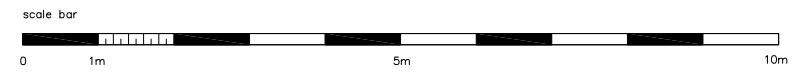

NOTES  
1. Final coordination of drawings and information with ADS Associates and Mecserve to be finalised on later issues of this drawing. Any discrepancies to be reported to the architect

title	Proposed North East elevation	client	Charles Richards	project	Proposed B1 units on land to rear of 33 - 57 Grosvenor Road Twickenham, Middlesex TW1 4AD	drawing number	165.103k
scale	1:50@A1 / 1:100@A3	drawn	gt		Genevieve Theriault Architecture & Interiors 42 Brook Street, London W1K 5DB t : 07904 974 066 e : mail@genevieveheriault.com		
date	12.08.11	checked					