


do not scale from this drawing
verify all dimensions by site measurement
errors and omissions to be reported to the architect
copyright

Drawing issued for Planning purposes only

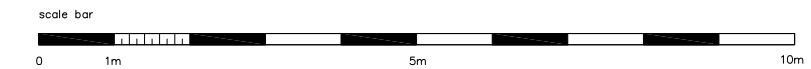

NOTES
1. Final coordination of drawings and information with ADS Associates and Mecserve to be finalised on later issues of this drawing. Any discrepancies to be reported to the architect

title	Proposed North West elevation	client	Charles Richards	project	Proposed B1 units on land to rear of 33 - 57 Grosvenor Road Twickenham, Middlesex TW1 4AD	drawing number	165.104d
scale	1:50@A1 / 1:100@A3	drawn	gt		Genevieve Theriault Architecture & Interiors 42 Brook Street, London W1K 5DB t : 07904 974 066 e : mail@genevievetheriault.com		
date	01.09.11	checked					

revision d : as-built 31.08.16
revision c : rwp's removed from units 1 and 4 09.08.12
revision b : rwp's added to units 1 and 4. rwp to unit 6 revised 21.12.11
revision a : movement joints added 02.12.11