

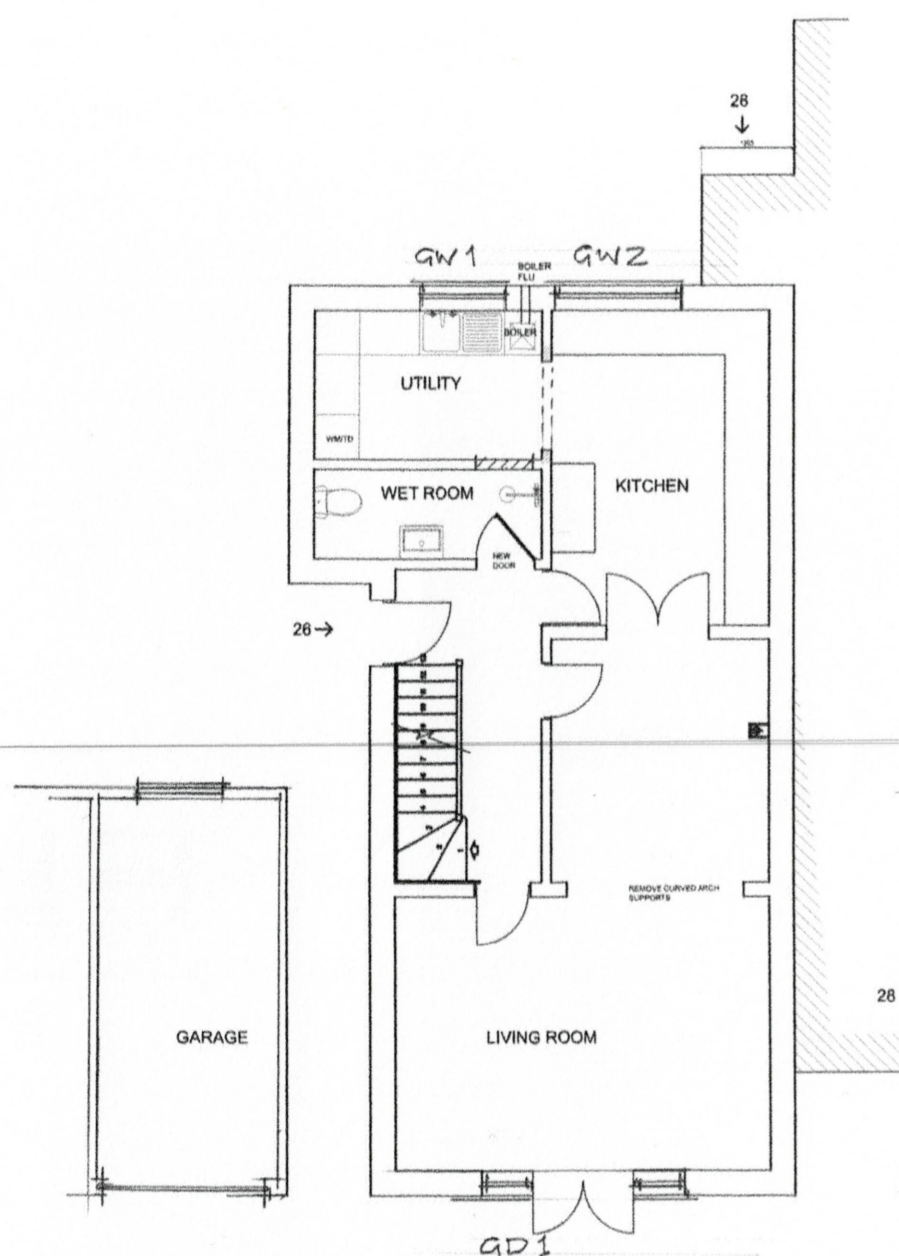



Scale 1:100

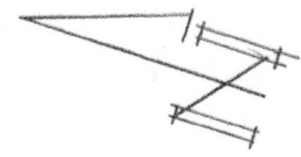

Ground Floor Plan 1:100

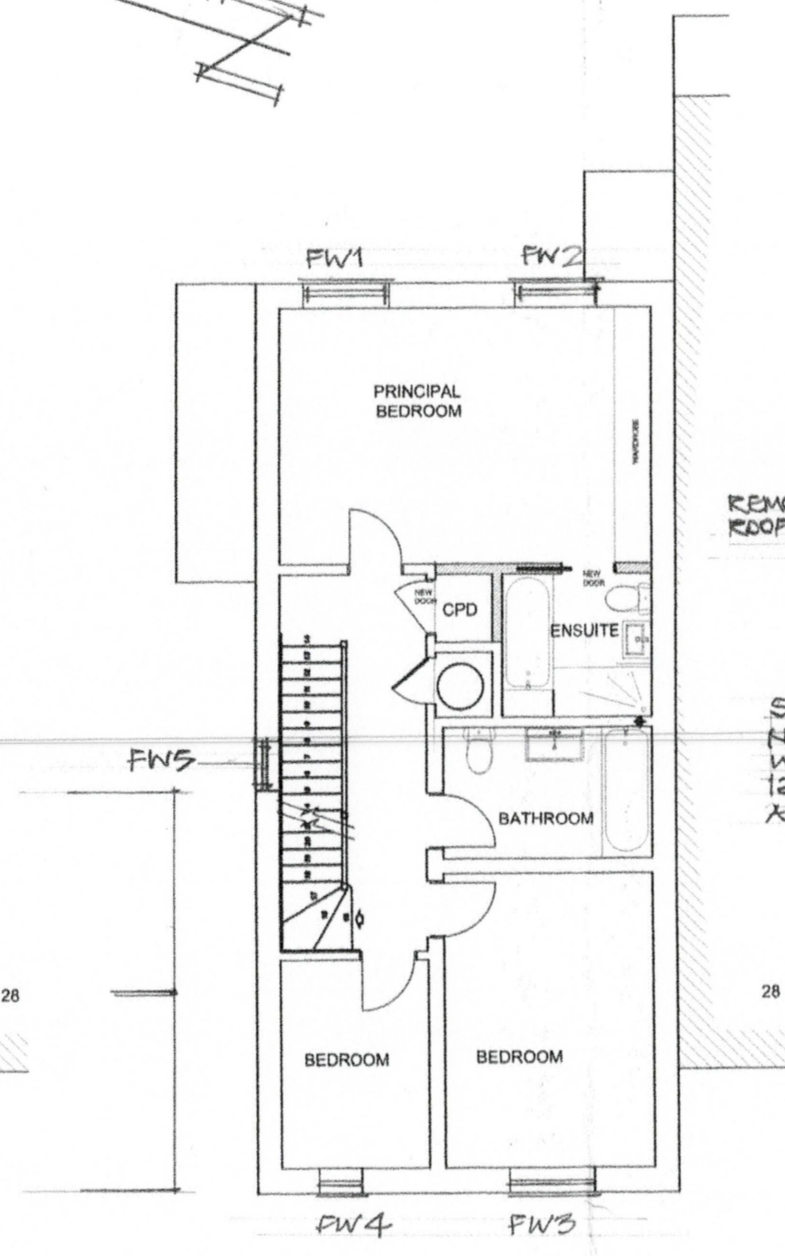

First Floor Plan 1:100

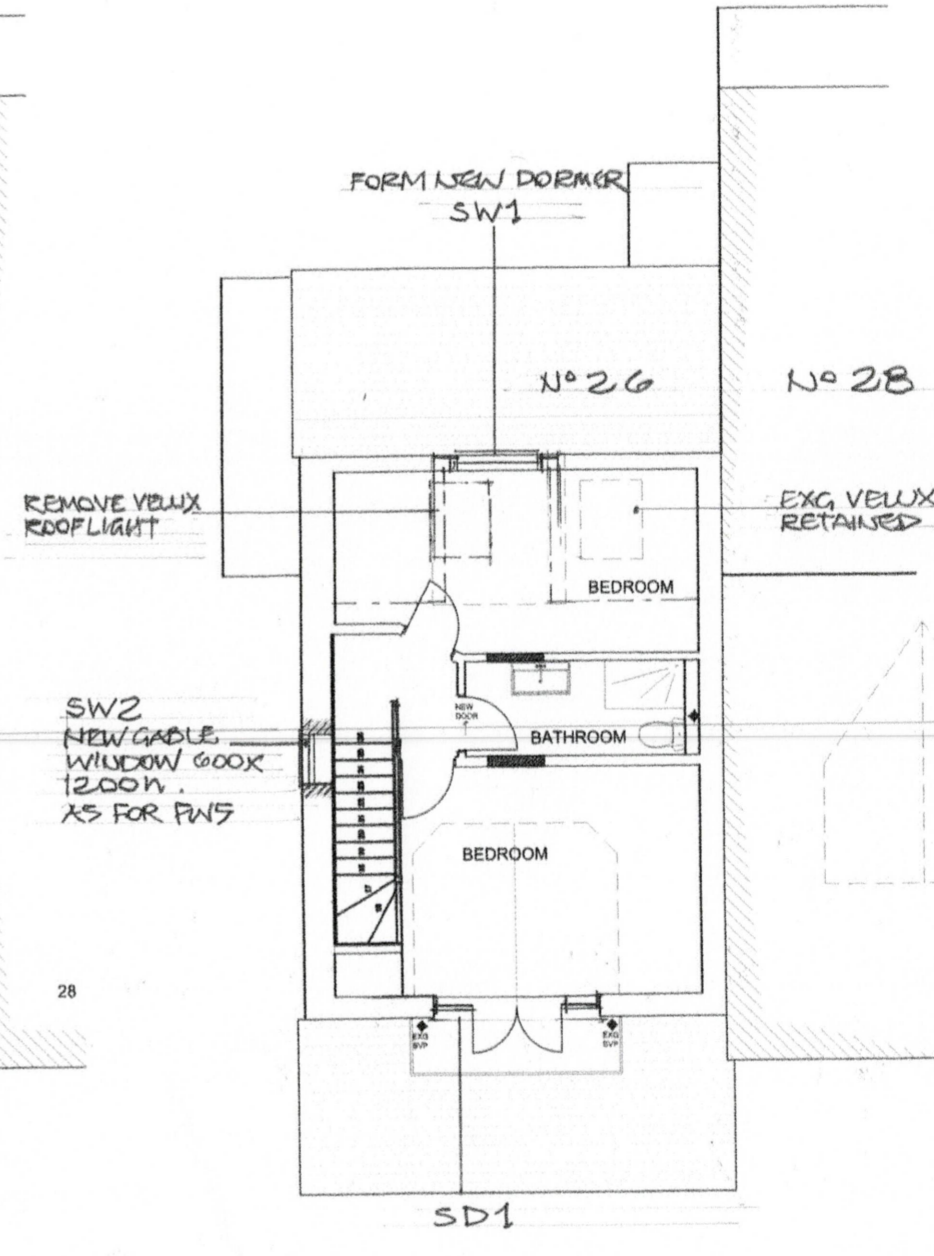

Second Floor Plan 1:100

SURVEY DRAWING	
<p>NOTES:</p> <ul style="list-style-type: none"> Copyright of this drawing remains the property of Buchan Rum Architects Ltd and should not be reproduced in full or parts or re-issued without written permission from Buchan Rum Architects Ltd. These drawings must be read in conjunction with the structural engineers drawings & details, and with all other consultants, sub-contractor and specialist's drawings & details. All dimensions are in millimetres, unless stated otherwise. All goods materials workmanship to conform with current building regulations BS8 and G00P's. All dimensions must be checked on site, and any discrepancies verified with the architect. Do not scale from the drawing. Any discrepancies between the drawings, details and specification must be reported to the architect immediately before work is put in hand. All work to be carried out in full accordance with current Building Regulations, British Standards and all Health & Safety Regulations. If in doubt please ask. 	
rev.	date comment
amendments	
Client	
Site address	
Albany Terrace, Albany Passage, Richmond, TW10	
Job Title	
ALBANY TERRACE - New rear dormer with window and new gable window and replace existing windows	
Drawing Title	
PROPOSED LOFT CONVERSION AND INTERNAL REFURBISHMENT - Proposed Plans.	
9 SAVILL ROAD LINDFIELD WEST SUSSEX RH162NY E : info@buchanrumarchitecture.co.uk	
Scale	Size
1:100	A3
Project Ref	Des By
24_004	BRA
Drawing number	Rev.
24.004sk3	

26 ALBANY TERRACE · TW10 6DN · EXISTING FLOOR PLANS (NEW WINDOW & DORMER MARKED UP)