



GENERAL NOTES: Do not scale from this drawing.  
 All dimensions are in millimetres unless otherwise stated.  
 This drawing is copyright of Grainne O'Keefe Architects.  
 This drawing cannot be copied or used in any way without the express permission of Grainne O'Keefe Architects.  
 Neighbouring properties not surveyed unless stated.

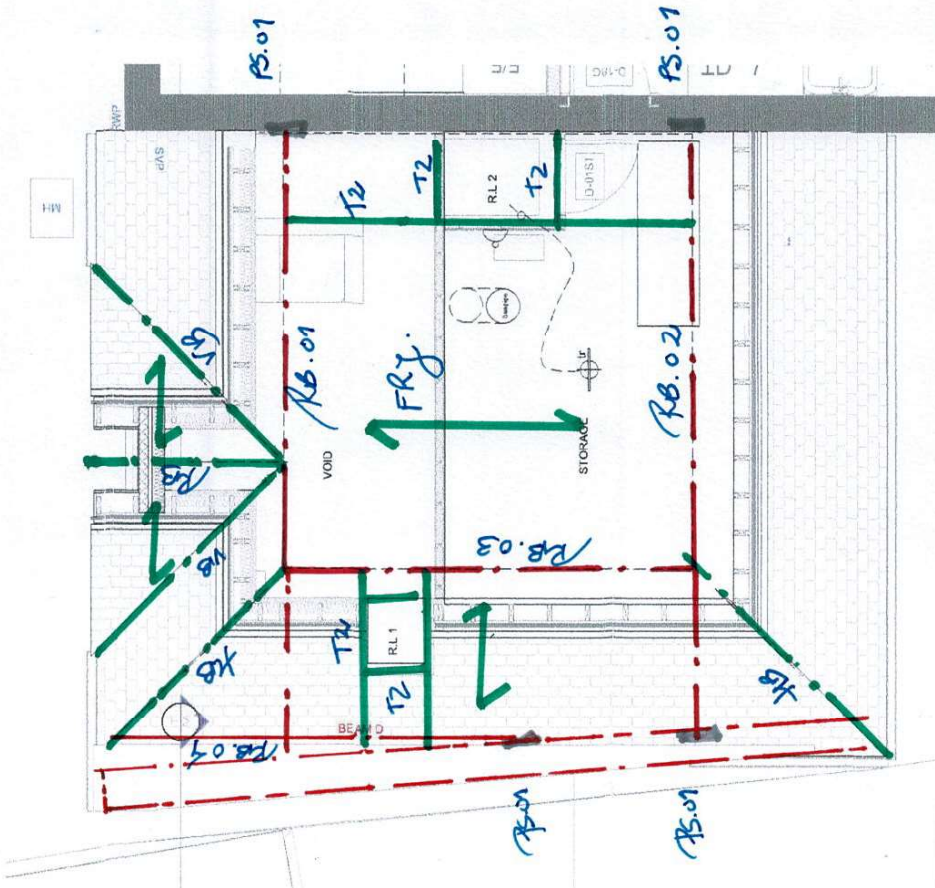

2 Roof void  
 Scale: 1:50

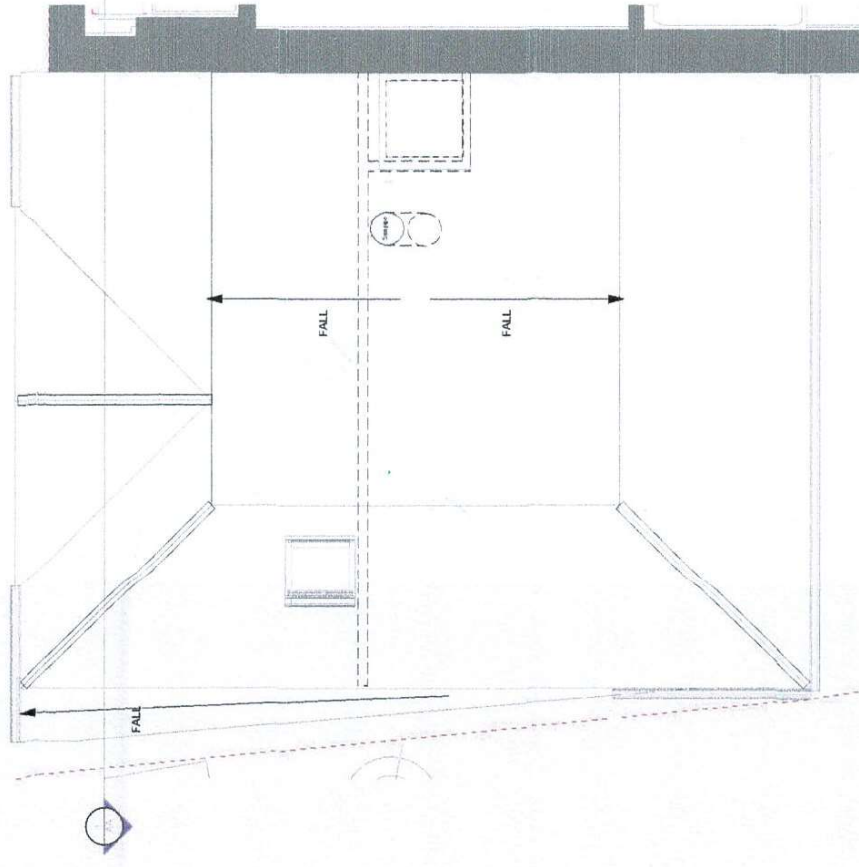

2 Roof Plan  
 Scale: 1:50

**DRAWING MARK UP** JOB NO.: 066642  
**DWG** SH  
**TITLE:** SH  
**DWG NO.:** SK.01 A  
**INITIALS:** SLC DATE: 12.07.2024

REV. A: RENEGED LAYOUT.

Job Name Chesterfield House 32 Broad Lane	Job No 2023 - 13	Revisions REV A 05/07/24 GENERAL UPDATES	Rev No A
Drawing Name First Floor Working	Dwg No 23	Dwg Scale 1:50	Date Entered 5/7/24
			Time 11:36:38

**GRAINNE O'KEEFE ARCHITECTS**  
 Architects, 30 Broad Lane, Hampton, TW12 3JZ  
 020 8941 1061 07976 38970  
 grainnearch@openwork.com  
 www.goaarchitects.co.uk