



8 HERBERT ROAD, WIMBLEDON, SW19 3SH

**PROJECT TITLE**  
**PROPOSED HOUSEHOLDER APPLICATION**  
 Erection of a part single, part two storey rear/side extensions and porch addition with alterations to existing roof to create a habitable second floor with a rear dormer, roof light additions and alterations to existing fenestration

**SITE ADDRESS**  
 64 BOILEAU ROAD, LONDON SW13 9BL, UK

**INTELLECTUAL PROPERTY RIGHTS**  
 The Planning Documents and other documents prepared by Design Professional (or prepared by Construction Manager / General Contractor or its Trade Contractors under a performance specification) pursuant to this Contract are the property of the Owner. Neither CM/GC nor any Subcontractor shall own or claim a copyright in such drawings, specifications, and other similar related documents; Owner shall retain all common law, statutory, and other intellectual property rights with respect thereto. All models are property of the owner.

DESIGNED BY : CHP  
 DRAWN BY : CHP  
 CHECKED BY : PC  
 DATE : 09.11.2024

ISSUED FOR :


**PLANNING**

REVISIONS :


REV. NO.	DESCRIPTION	DATE	BY

CONTENTS :  
 FLOOR PLANS

SCALE	SHEET NO.	SCOPE
AS SHOWN	3 of 8	A

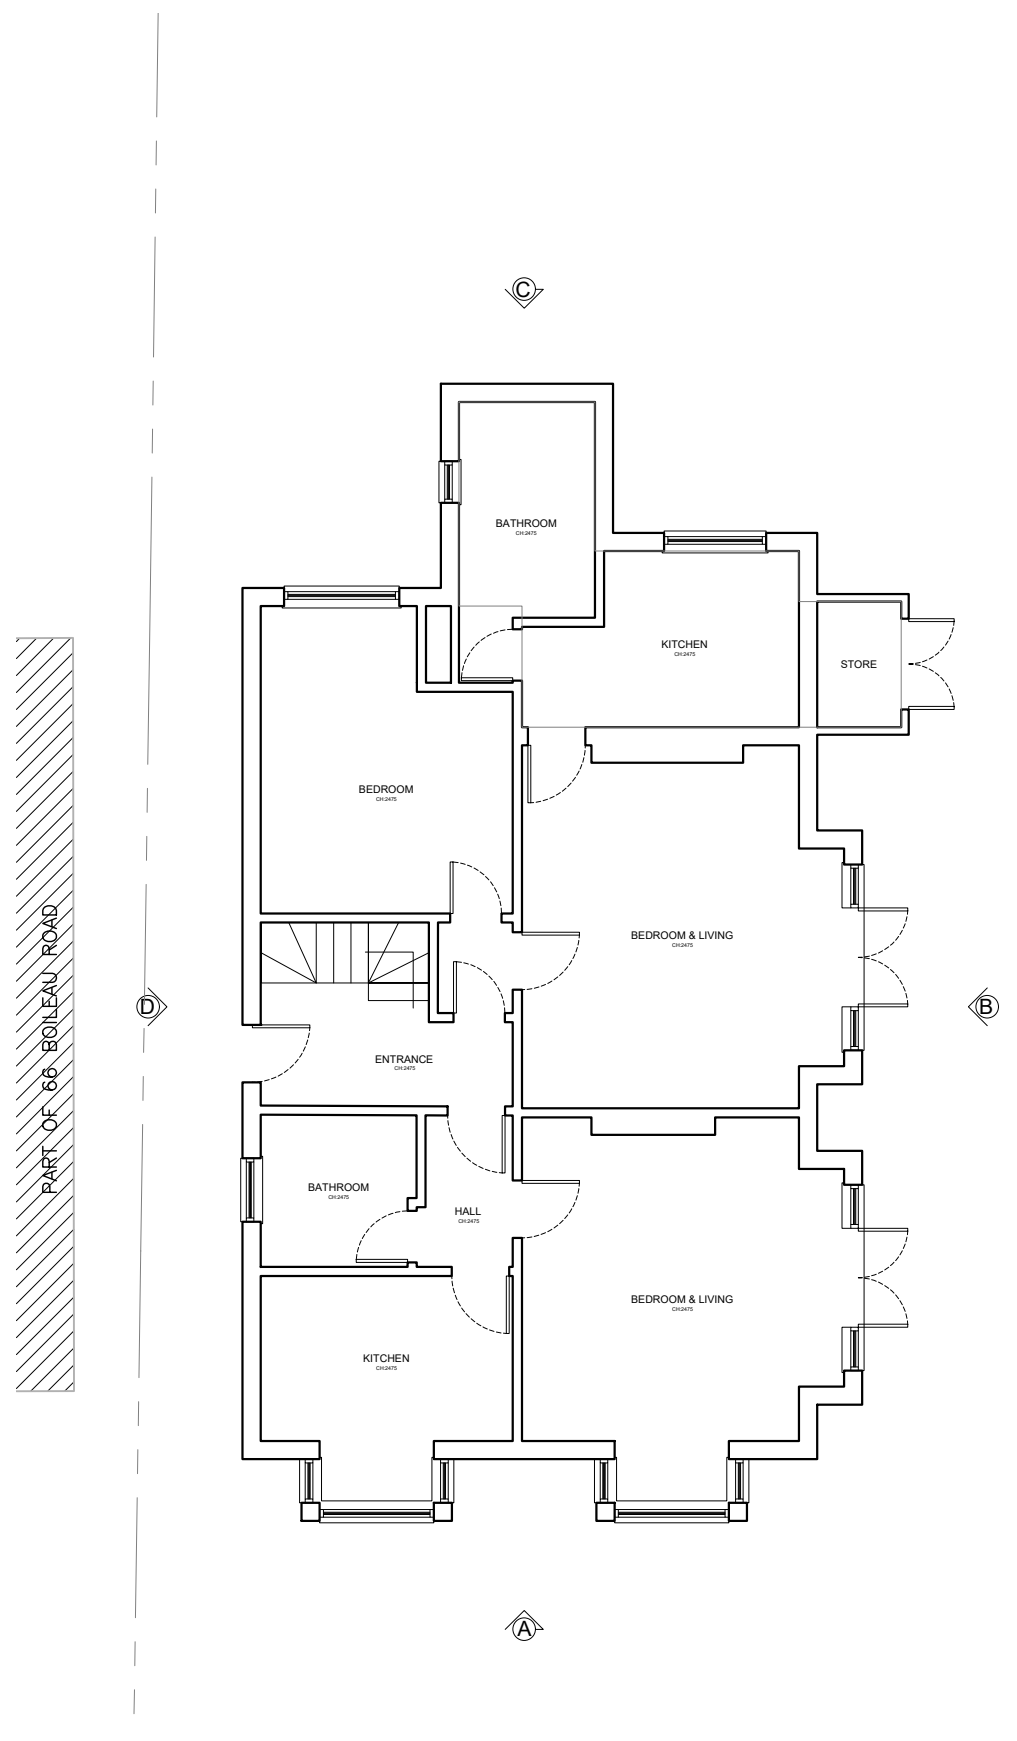


**EXISTING GROUND FLOOR PLAN**  
 SCALE 1:100 MTS

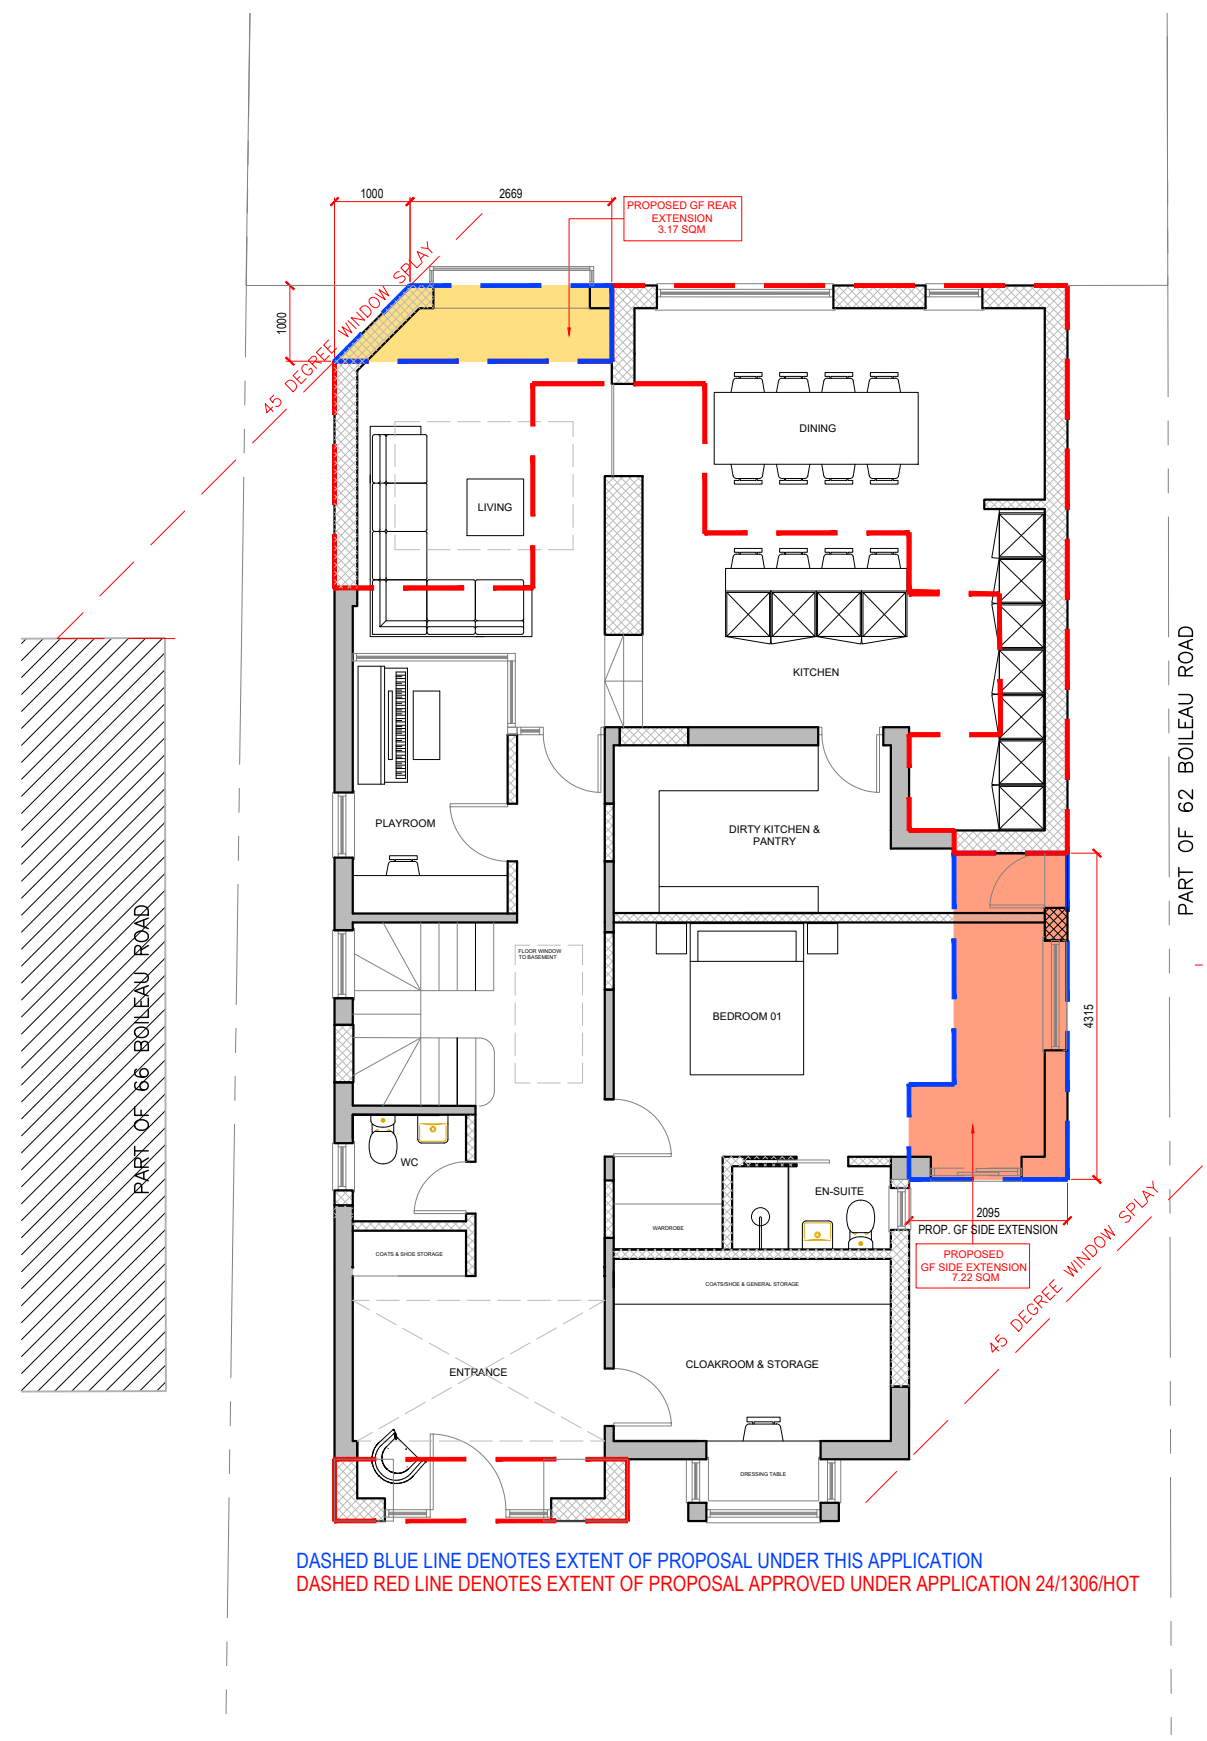

**PROPOSED GROUND FLOOR PLAN**  
 SCALE 1:100 MTS

DASHED BLUE LINE DENOTES EXTENT OF PROPOSAL UNDER THIS APPLICATION  
 DASHED RED LINE DENOTES EXTENT OF PROPOSAL APPROVED UNDER APPLICATION 24/1306/HOT

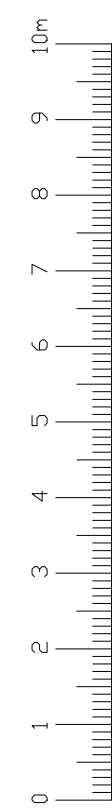

PART OF 62 BOILEAU ROAD

PART OF 66 BOILEAU ROAD

PART OF 66 BOILEAU ROAD