



8 HERBERT ROAD, WIMBLEDON, SW19 3SH

PROJECT TITLE

PROPOSED HOUSEHOLDER APPLICATION

Erection of a part single, part two storey rear/side extensions and porch addition with alterations to existing roof to create a habitable second floor with a rear dormer, roof light additions and alterations to existing fenestration

SITE ADDRESS

64 BOILEAU ROAD, LONDON SW13 9BL, UK

INTELLECTUAL PROPERTY RIGHTS

The Planning Documents and other documents prepared by Design Professional (or prepared by Construction Manager / General Contractor or its Trade Contractors under a performance specification) pursuant to this Contract are the property of the Owner. Neither CM/GC nor any Subcontractor shall own or claim a copyright in such drawings, specifications, and other similar related documents; Owner shall retain all common law, statutory, and other intellectual property rights with respect thereto. All models are property of the owner.

DESIGNED BY : CHP

DRAWN BY : CHP

CHECKED BY : PC

DATE : 09.11.2024

ISSUED FOR :

PLANNING

REVISIONS :

REV. NO.	DESCRIPTION	DATE	BY

CONTENTS :


FLOOR PLANS

SCALE SHEET NO. SCOPE

AS SHOWN


5 of 8

A

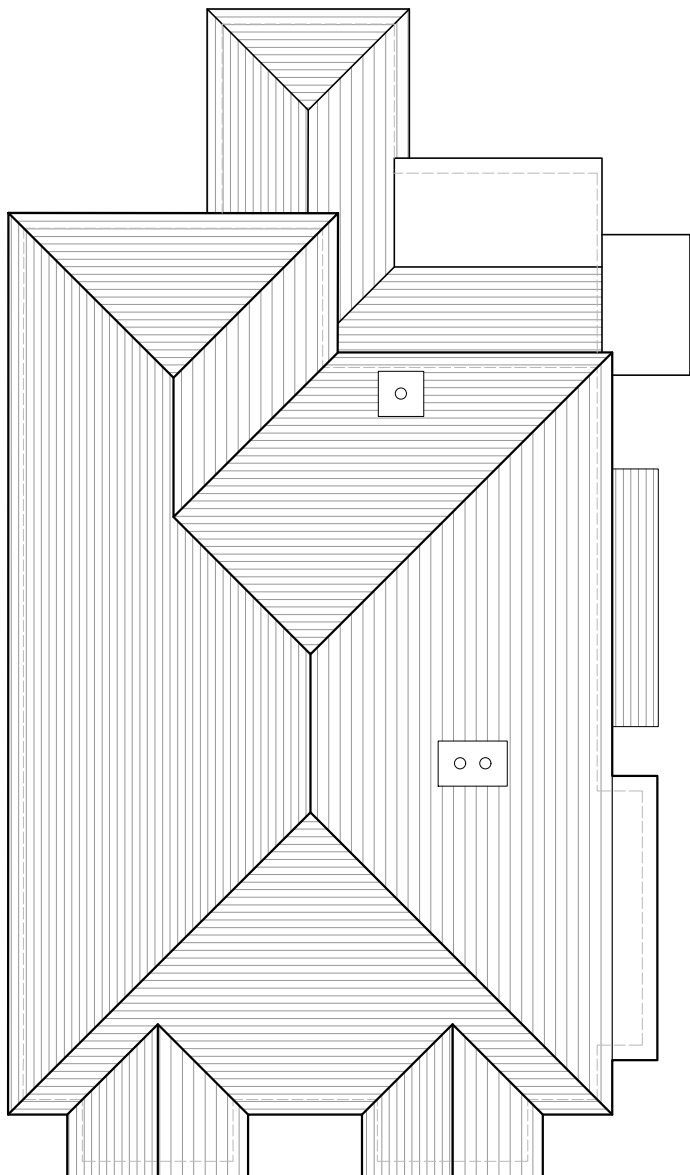

EXISTING ROOF PLAN

SCALE 1:100 MTS

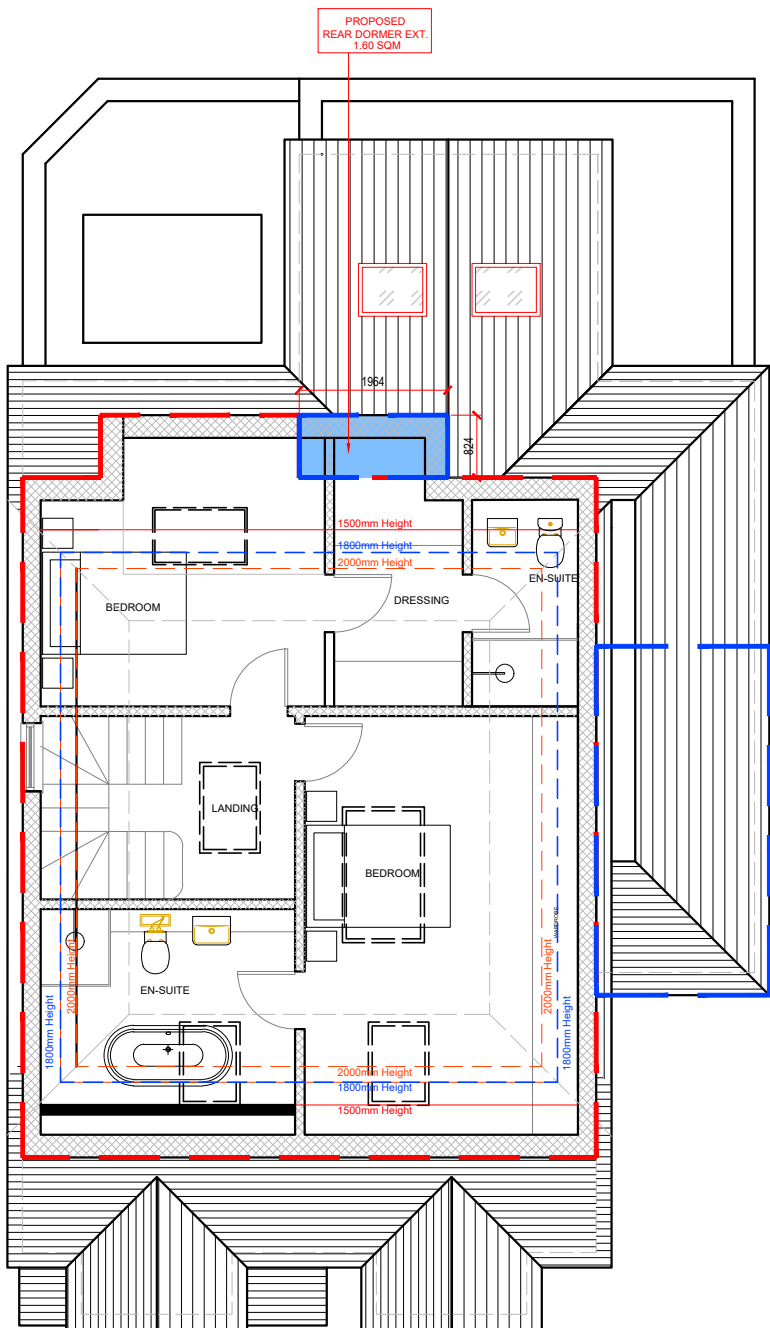

DASHED BLUE LINE DENOTES EXTENT OF PROPOSAL UNDER THIS APPLICATION
DASHED RED LINE DENOTES EXTENT OF PROPOSAL APPROVED UNDER APPLICATION 24/1306/HOT
ALTERATIONS TO THE ROOF AS APPROVED UNDER APPLICATION 41306HOT

PROPOSED SECOND FLOOR (LOFT) PLAN

SCALE 1:100 MTS

