



498 KINGSTON ROAD, LONDON SW20 8DT

**PROJECT TITLE**

**PROPOSED HOUSEHOLDER APPLICATION**  
Erection of a part single, part two storey rear/side extensions and porch addition with alterations to existing roof to create a habitable second floor with a rear dormer, roof light additions and alterations to existing fenestration

**SITE ADDRESS**

64 BOILEAU ROAD, LONDON SW13 9BL, UK

**INTELLECTUAL PROPERTY RIGHTS**

The Planning Documents and other documents prepared by Design Professional (or prepared by Construction Manager / General Contractor or its Trade Contractors under a performance specification) pursuant to this Contract are the property of the Owner. Neither CM/GC nor any Subcontractor shall own or claim a copyright in such drawings, specifications, and other similar related documents; Owner shall retain all common law, statutory, and other intellectual property rights with respect thereto. All models are property of the owner.

DESIGNED BY : CHP

DRAWN BY : CHP

CHECKED BY : PC

DATE : 09.11.2024

ISSUED FOR :

**PLANNING**

**REVISIONS**


REV. NO.	DESCRIPTION	DATE	BY

**CONTENTS**

ELEVATIONS

SCALE	SHEET NO.	SCOPE
-------	-----------	-------


AS SHOWN	7 of 8	<b>A</b>
----------	--------	----------

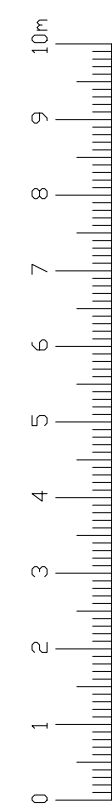


**EXISTING RIGHT SIDE ELEVATION B**  
SCALE 1:100 MTS



**EXISTING FRONT ELEVATION A**  
SCALE 1:100 MTS

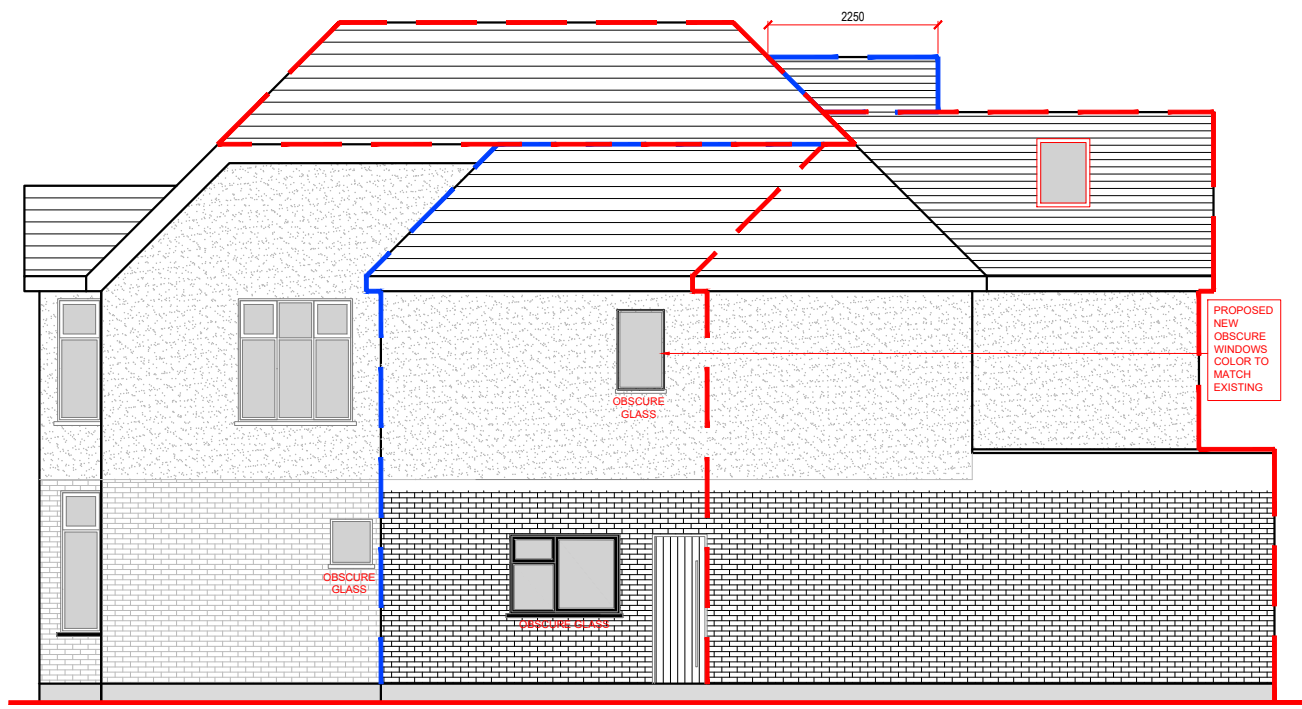

**PROPOSED RIGHT SIDE ELEVATION B**  
SCALE 1:100 MTS

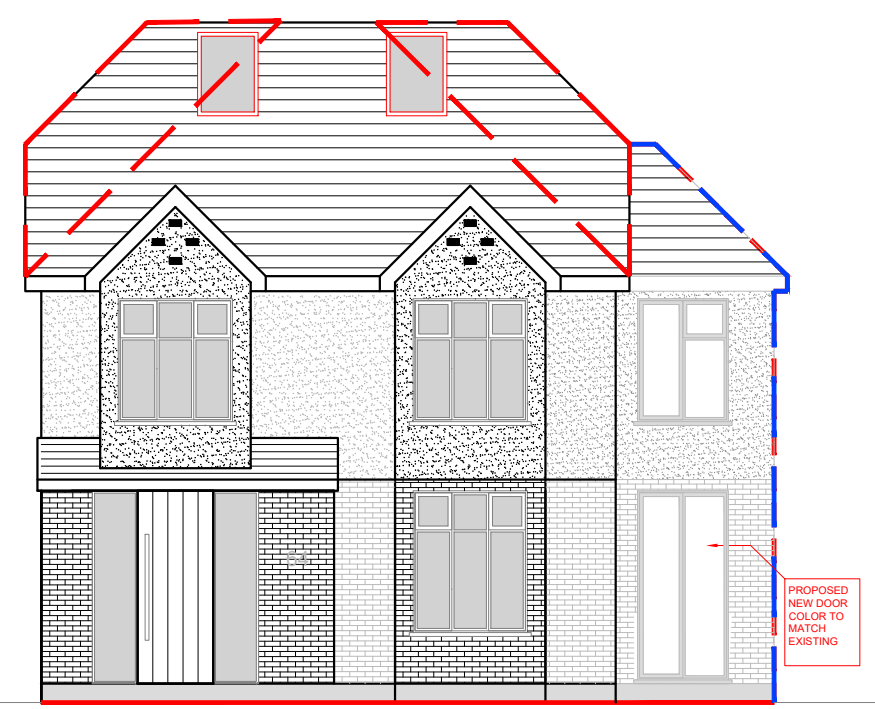

**PROPOSED FRONT ELEVATION A**  
SCALE 1:100 MTS

DASHED BLUE LINE DENOTES EXTENT OF PROPOSAL UNDER THIS APPLICATION  
DASHED RED LINE DENOTES EXTENT OF PROPOSAL APPROVED UNDER APPLICATION 24/1306/HOT

DASHED BLUE LINE DENOTES EXTENT OF PROPOSAL UNDER THIS APPLICATION  
DASHED RED LINE DENOTES EXTENT OF PROPOSAL APPROVED UNDER APPLICATION 24/1306/HOT