



498 KINGSTON ROAD, LONDON SW20 8DT

**PROJECT TITLE**

**PROPOSED HOUSEHOLDER APPLICATION**  
 Erection of a part single, part two storey rear/side extensions and porch addition with alterations to existing roof to create a habitable second floor with a rear dormer, roof light additions and alterations to existing fenestration

**SITE ADDRESS**

64 BOILEAU ROAD, LONDON SW13 9BL, UK

**INTELLECTUAL PROPERTY RIGHTS**

The Planning Documents and other documents prepared by Design Professional (or prepared by Construction Manager / General Contractor or its Trade Contractors under a performance specification) pursuant to this Contract are the property of the Owner. Neither CM/GC nor any Subcontractor shall own or claim a copyright in such drawings, specifications, and other similar related documents; Owner shall retain all common law, statutory, and other intellectual property rights with respect thereto. All models are property of the owner.

DESIGNED BY : CHP

DRAWN BY : CHP

CHECKED BY : PC

DATE : 09.11.2024

ISSUED FOR :

**PLANNING**

**REVISIONS**

REV. NO.	DESCRIPTION	DATE	BY

**CONTENTS**

**ELEVATIONS**


SCALE	SHEET NO.	SCOPE
-------	-----------	-------

AS SHOWN 8 of 8 A

PART OF 62 BOILEAU RD



**EXISTING REAR ELEVATION C**  
SCALE 1:100 MTS

PART OF 66 BOILEAU RD



**EXISTING LEFT SIDE ELEVATION D**  
SCALE 1:100 MTS

7.980 - SF - Landing FCL

5.560 - SF - Landing FFL

5.340 - FF - Landing FCL


2.790 - FF - Landing FFL

2.550 - GF - Entrance FCL

0.000 - GF - Entrance FFL

-0.250 - GF - FFL


PART OF 66 BOILEAU RD

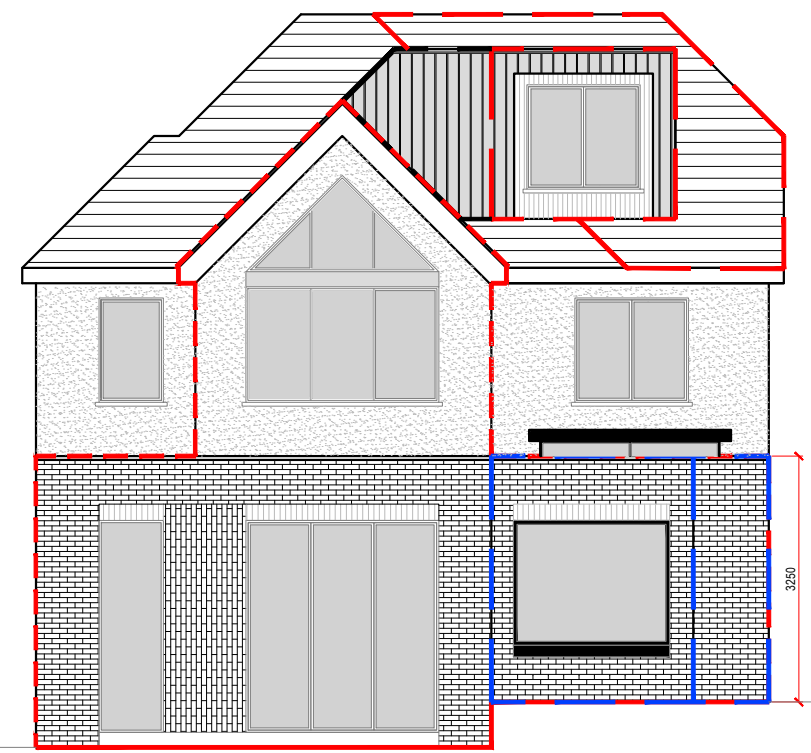

DASHED BLUE LINE DENOTES EXTENT OF PROPOSAL UNDER THIS APPLICATION  
 DASHED RED LINE DENOTES EXTENT OF PROPOSAL APPROVED UNDER APPLICATION 24/1306/HOT

**PROPOSED REAR ELEVATION C**  
SCALE 1:100 MTS

2250

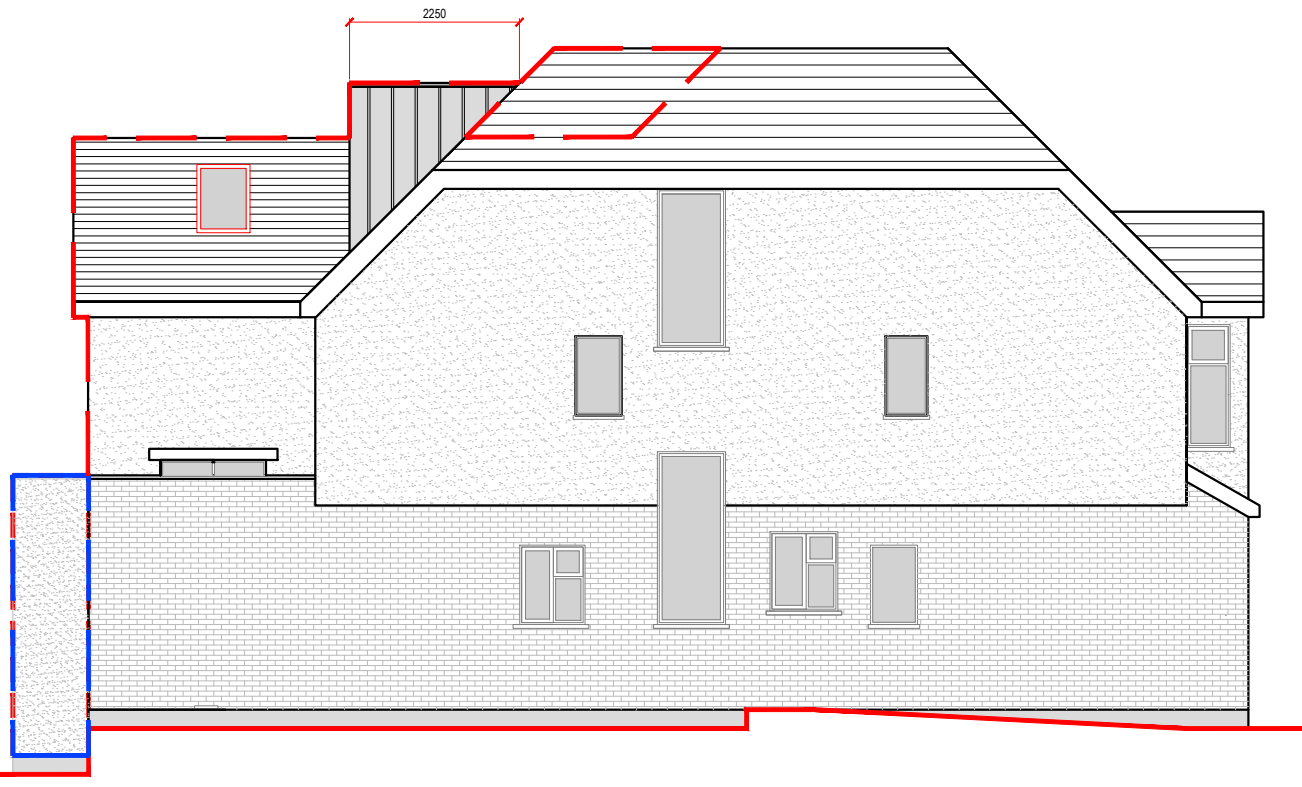

DASHED BLUE LINE DENOTES EXTENT OF PROPOSAL UNDER THIS APPLICATION  
 DASHED RED LINE DENOTES EXTENT OF PROPOSAL APPROVED UNDER APPLICATION 24/1306/HOT

**PROPOSED LEFT SIDE ELEVATION D**  
SCALE 1:100 MTS

