
NB: THIS DRAWING IS BASED ON DRAWING NOS: 0582(00)09 &10 BY DYER GRIMES ARCHITECTS. DO NOT SCALE.

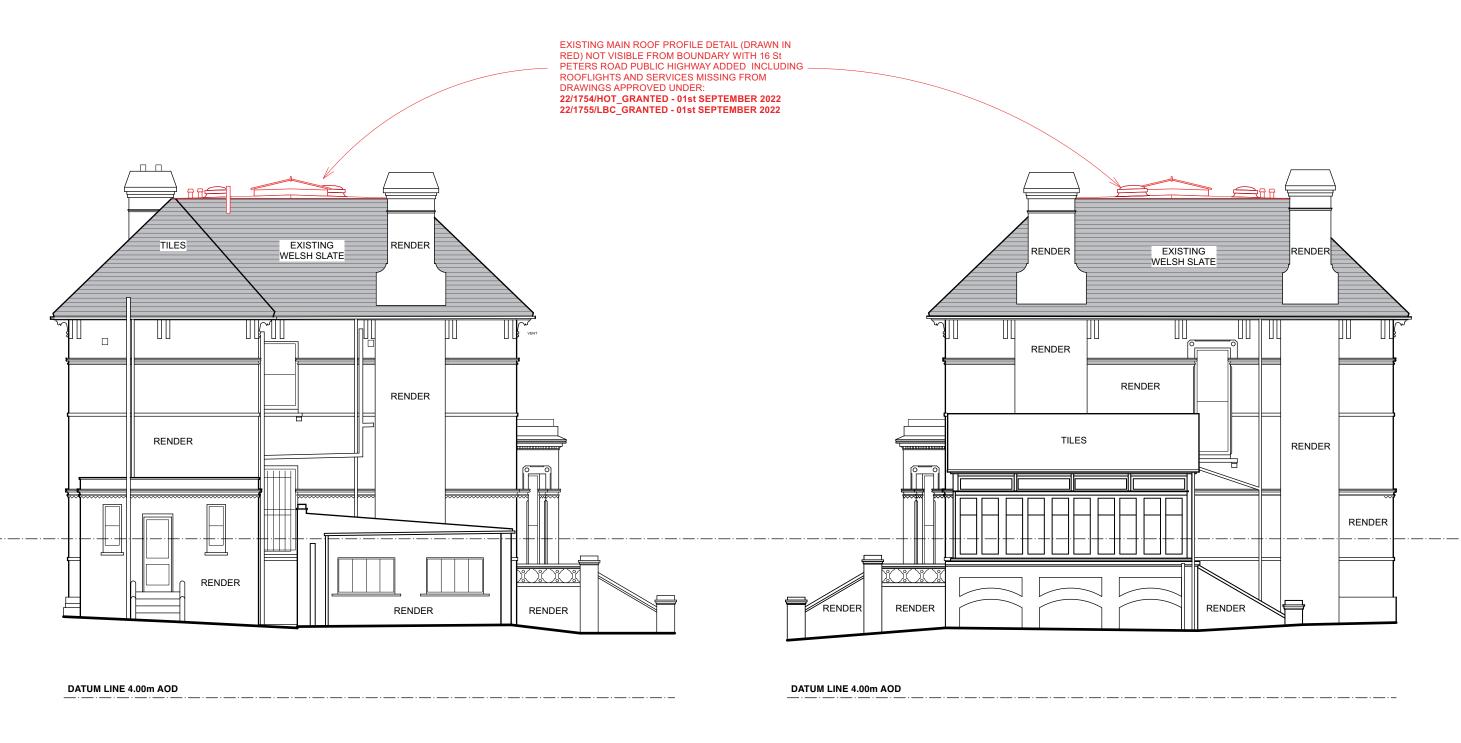

Existing South East (Side) Elevation

Existing North West (Side) Elevation

LISTED BUILDING CONSENT AND PLANNING APPROVAL ISSUE

Butler Hegarty ArchitectsUnit 3.3, Islington Studios, 159-163 Marlborough Road, London, N19 4NF tel: 020 72638933 email: mail@butlerhegartyarchitects.co.uk

0 2m 10m

Rev C. Note on roof material changed to match existing slate.

Oct 24

Rev B. Lower level of consesrvatory shown

Jun 24

Rev A. Issued for Listed Building Consent and Planning Approval with existing main roof profile detail (drawn in red) added.

16 St. Peters Road

Title: Existing South East & North West (Side) Elevations Drawing No: 0122823-**Su09C** Scale 1:100 @ A3