


NB: THIS DRAWING IS BASED ON DRAWING NO: 0582(00)08 BY DYER GRIMES ARCHITECTS. DO NOT SCALE.

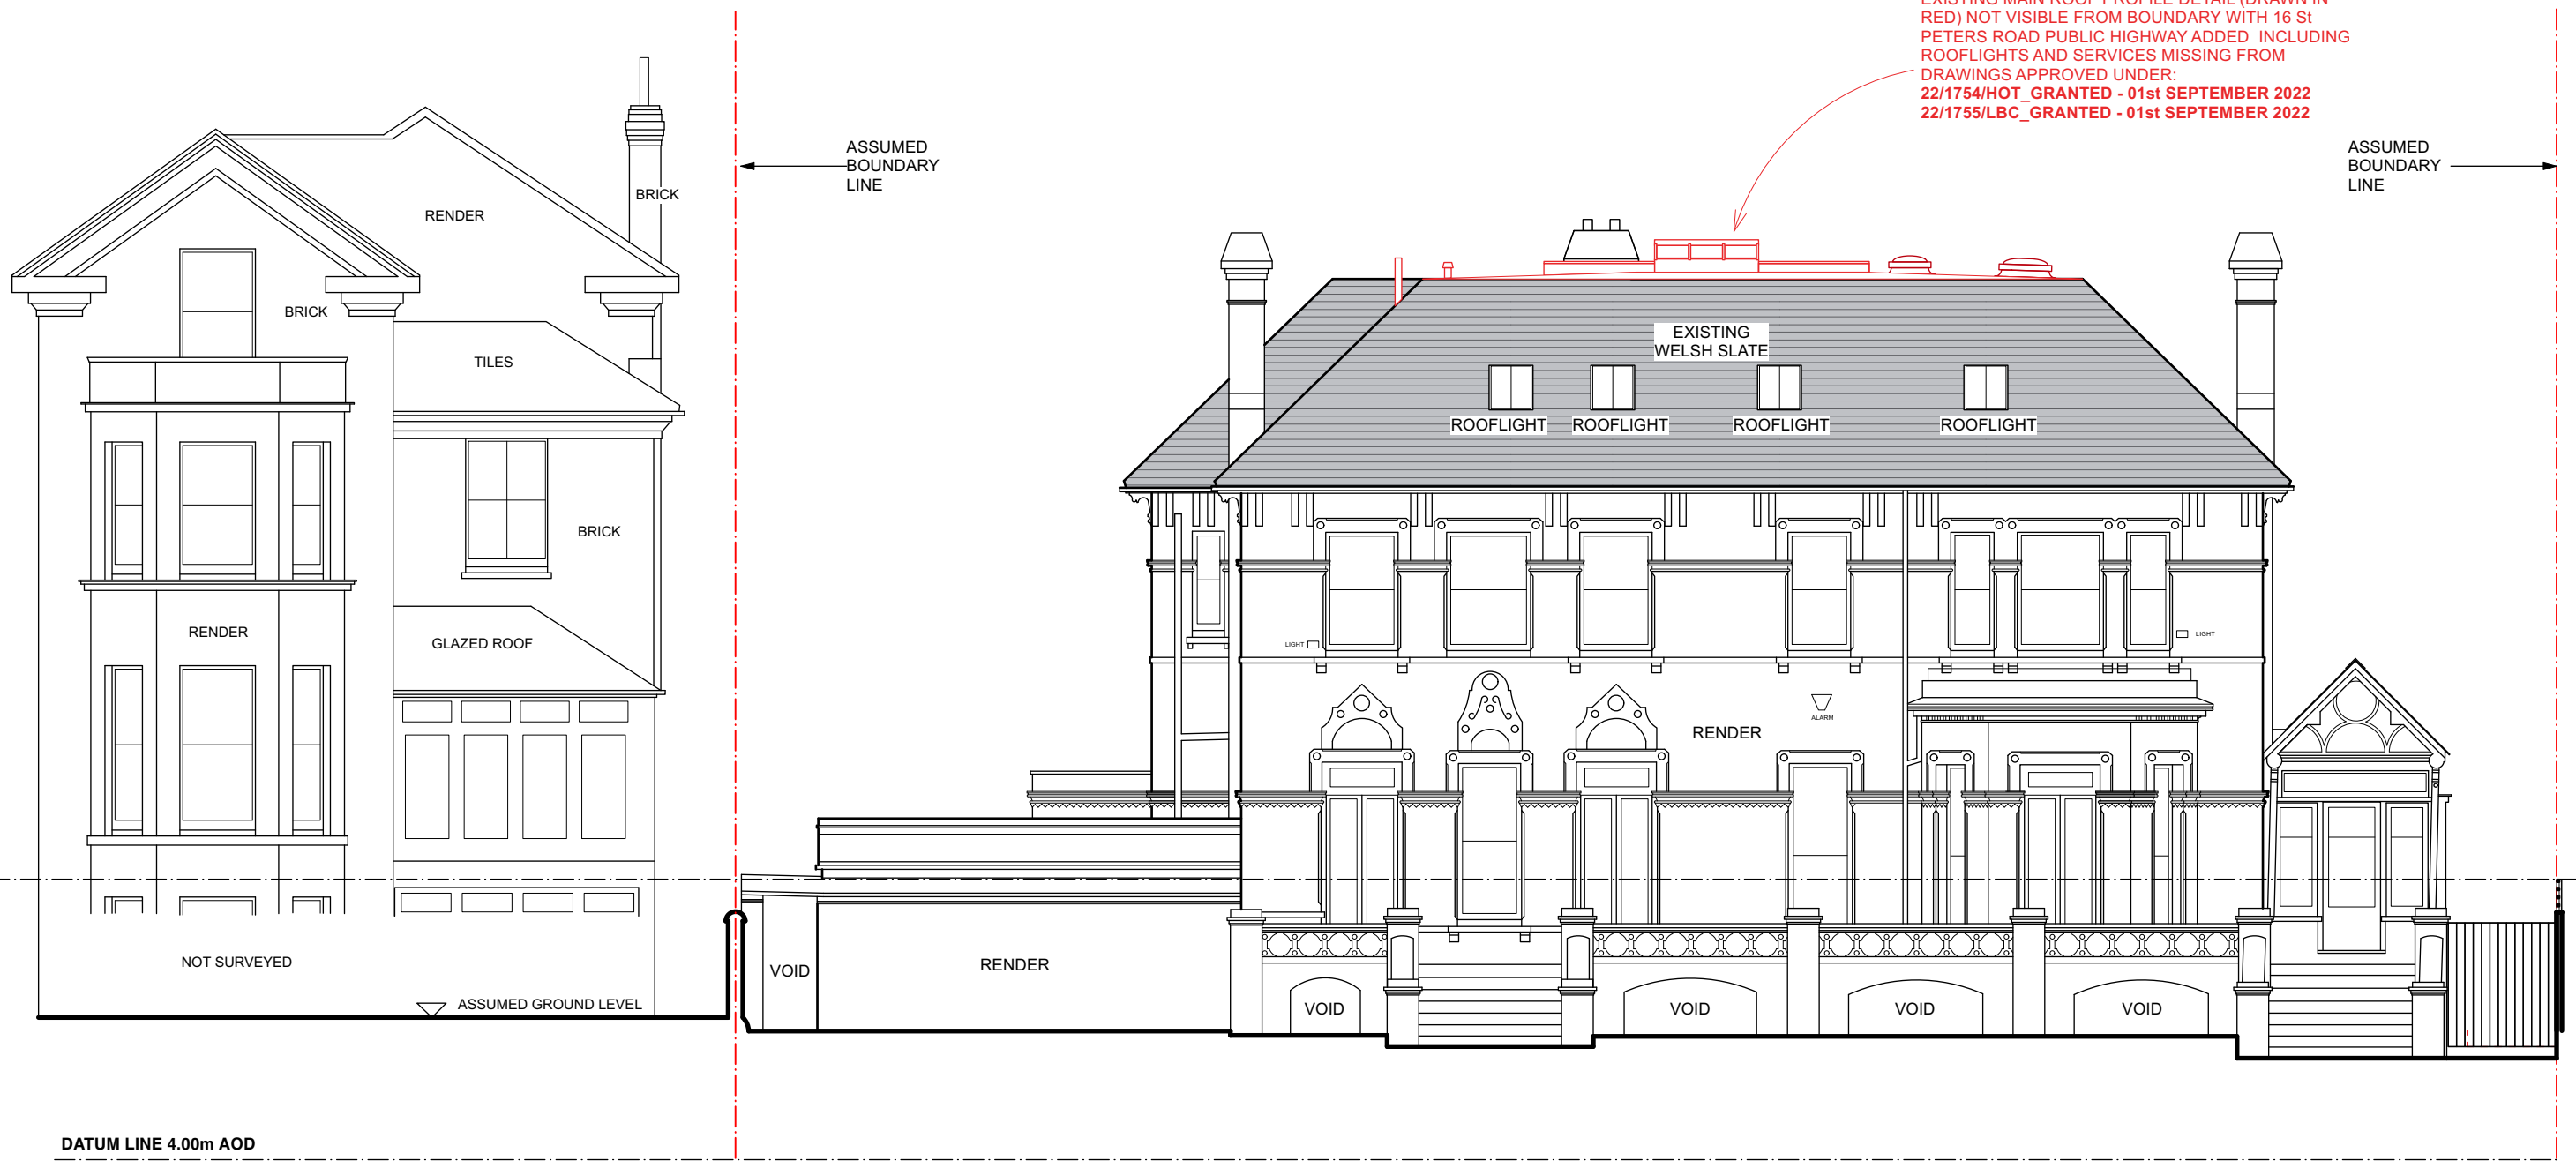

EXISTING MAIN ROOF PROFILE DETAIL (DRAWN IN RED) NOT VISIBLE FROM BOUNDARY WITH 16 St PETERS ROAD PUBLIC HIGHWAY ADDED INCLUDING ROOFLIGHTS AND SERVICES MISSING FROM DRAWINGS APPROVED UNDER: 22/1754/HOT_GRANTED - 01st SEPTEMBER 2022 22/1755/LBC_GRANTED - 01st SEPTEMBER 2022

Existing North East (Rear) Elevation

LISTED BUILDING CONSENT AND PLANNING APPROVAL ISSUE

- Rev B. Note on roof material changed to match existing slate. Oct 24
- Rev A. Issued for Listed Building Consent and Planning Approval with existing main roof profile detail (drawn in red) added. Feb 24

