


COPYRIGHT
 © This drawing is the copyright of AKS Ward, it may not be copied, altered or reproduced in any way without their written authority.
 This drawing must not be scaled. Use figured dimensions only. If in doubt ASK!
 This drawing is to be read in conjunction with all relevant AKSWard drawings and specifications prefixed L211044

NOTES

- All setting out to be in accordance with the Architect's drawings. Any discrepancies between the Engineer's and the Architect's drawings to be referred to the Architect before proceeding. Dimensions must not be scaled.
- Contractor to undertake their own measured survey to confirm existing structural steel arrangement and setting out as required to inform the steel fabricator drawings.
- Contractor to advise AKSWard structural engineer where existing arrangement is not as AKSWard drawings and to agree on a way forward.

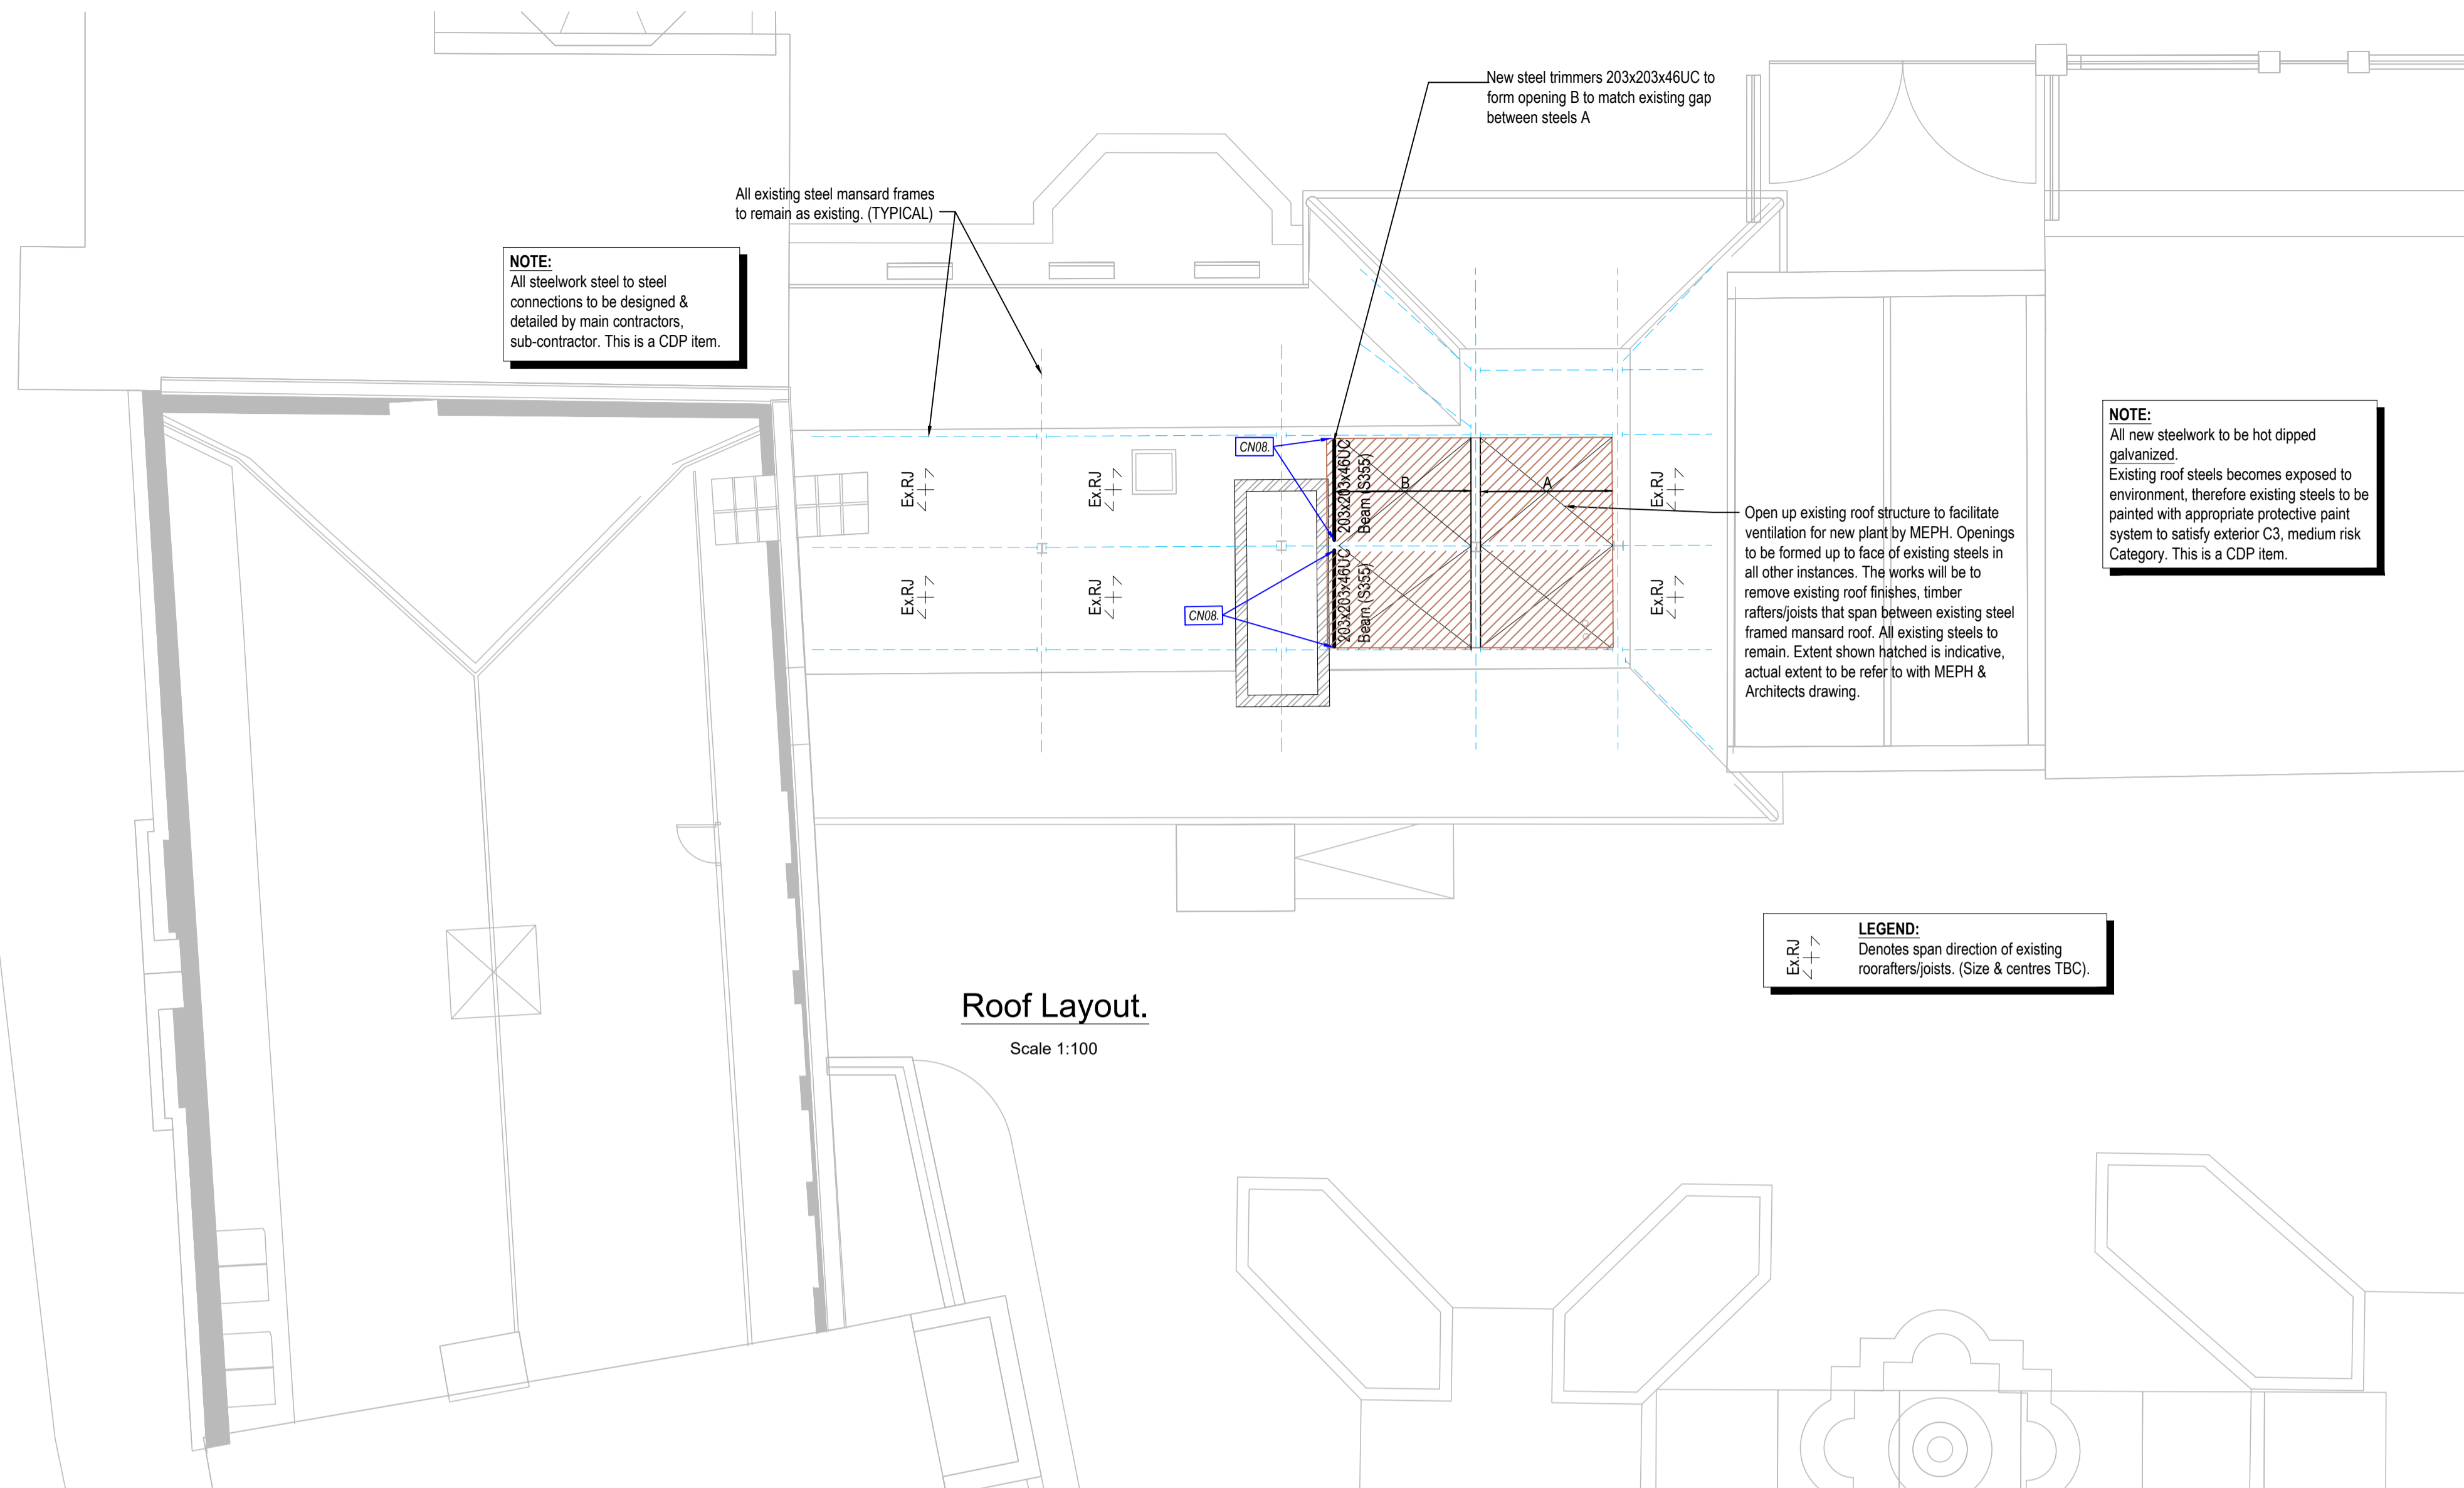

Roof Layout.
Scale 1:100

ULS Reactions for Steel Connection Design		
Reference	Shear Force (kN)	Bending Moment (kNm)
CN08	75	—

AB01 As Built Issue.	NSP	SJG	10.07.24
C02 Updated as per architect's markup	AA	SJG	08.03.24
C01 Issued for Construction Connection loads table added.	AA	SJG	16.10.23
T01 Issued for Tender	NSP	SJG	30.09.22
P02 Work In Progress	NSP	SJG	27.09.22
P01 Work In Progress	AA	SJG	01.09.22
Rev. Amendment	Dm	Chkd	Date

Drg Status **AS BUILT.** Suitability **AB**

AKSWard[®]
CONSTRUCTION CONSULTANTS
 10 Bonhill Street
 London EC2A 4PE
 Tel: 020 7236 0161
 e-mail: london@aksward.com
 web: www.aksward.com

London
 Hitchin
 Oxford
 Southampton

Client **Orchard Street Investment Management LLP.**

Project **Palm Court - Richmond**

Title **Proposed Roof Layout.**

Scales A1 1:100, 1:10 Project No. **L211044**

Reviewed Scheme SG Date 28.09.22

Reviewed Final Date

Project Ref Originator Zone Level Type Role DrgNo Rev.

L211044 - AKS -XX -RF-DR -S -3006 -AB01

AS BUILT
 This "As Built" drawing represents the final construction issue and incorporates any amendments that have been brought to our attention by the contractor. We have not carried out a site survey. Any variations not brought to our attention are not included and to the fullest extent permitted by law, we exclude any liability arising out of the failure to bring any variations to our attention.