

DO NOT SCALE FROM THIS DRAWING

ALL DIMENSIONS SHALL BE CHECKED ON SITE PRIOR TO COMMENCING THE WORKS AND ERRORS AND OMISSIONS TO BE REPORTED TO SIXTY TWO LTD

ALL WORKS SHALL CONFORM TO THE CURRENT EDITION OF THE BUILDING REGULATIONS AND OTHER STATUTORY REQUIREMENTS

ALL MATERIALS AND WORKMANSHIP SHALL CONFORM WITH THE RELEVANT BRITISH STANDARD SPECIFICATIONS AND CODES OF PRACTICE


ALL DIMENSIONS ARE IN mm UNLESS OTHERWISE STATED

THIS DRAWING IS COPYRIGHT


IF THIS DRAWING FORMS PART OF AN APPLICATION FOR PLANNING PERMISSION ON BEHALF OF THE APPLICANT NAMED BELOW, IT SHALL NOT BE USED FOR ANY OTHER PURPOSE WITHOUT THE EXPRESS PERMISSION OF SIXTY TWO LIMITED.

THIS DRAWING MAY INCORPORATE INFORMATION FROM OTHER PROFESSIONS. SIXTY TWO LIMITED CANNOT ACCEPT RESPONSIBILITY FOR THE INTEGRITY AND ACCURACY OF SUCH INFORMATION. ANY CLARIFICATION AND/OR ADDITIONS THAT ARE REQUIRED APPERTAINING TO SUCH INFORMATION SHOULD BE SOUGHT FROM THE RELEVANT PROFESSION OR THEIR APPOINTED REPRESENTATIVE AS LISTED BELOW

LIST OF INFORMANTS:-

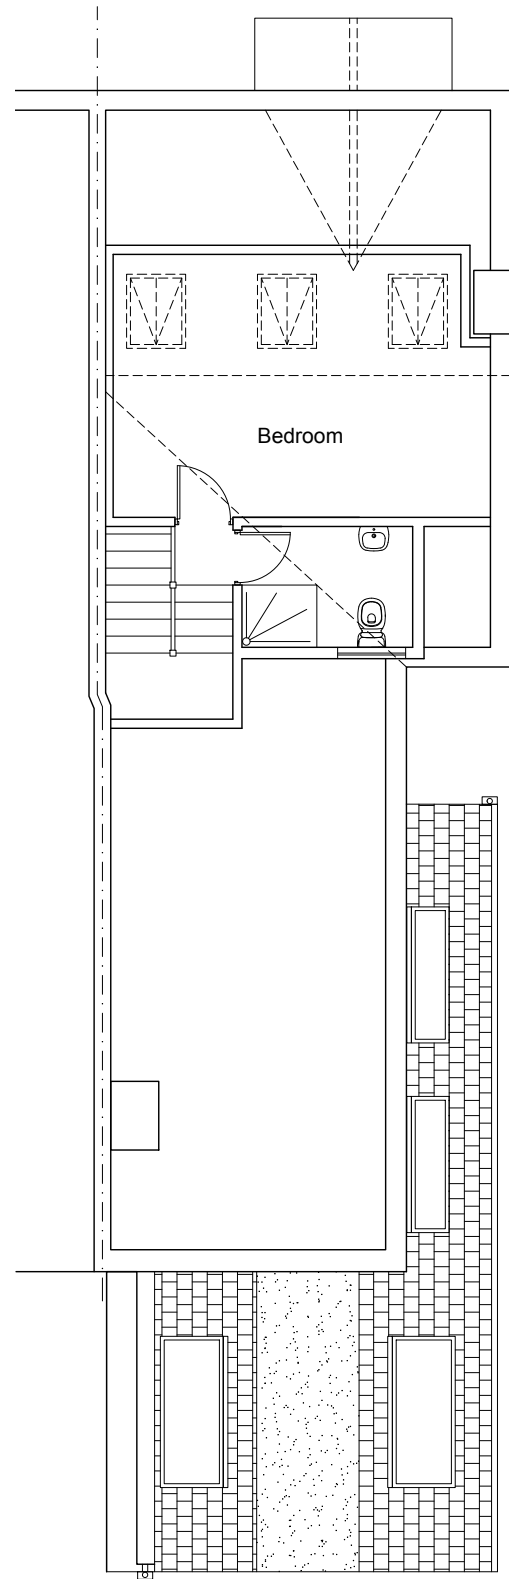

LOFT FLOOR PLAN AS BUILT

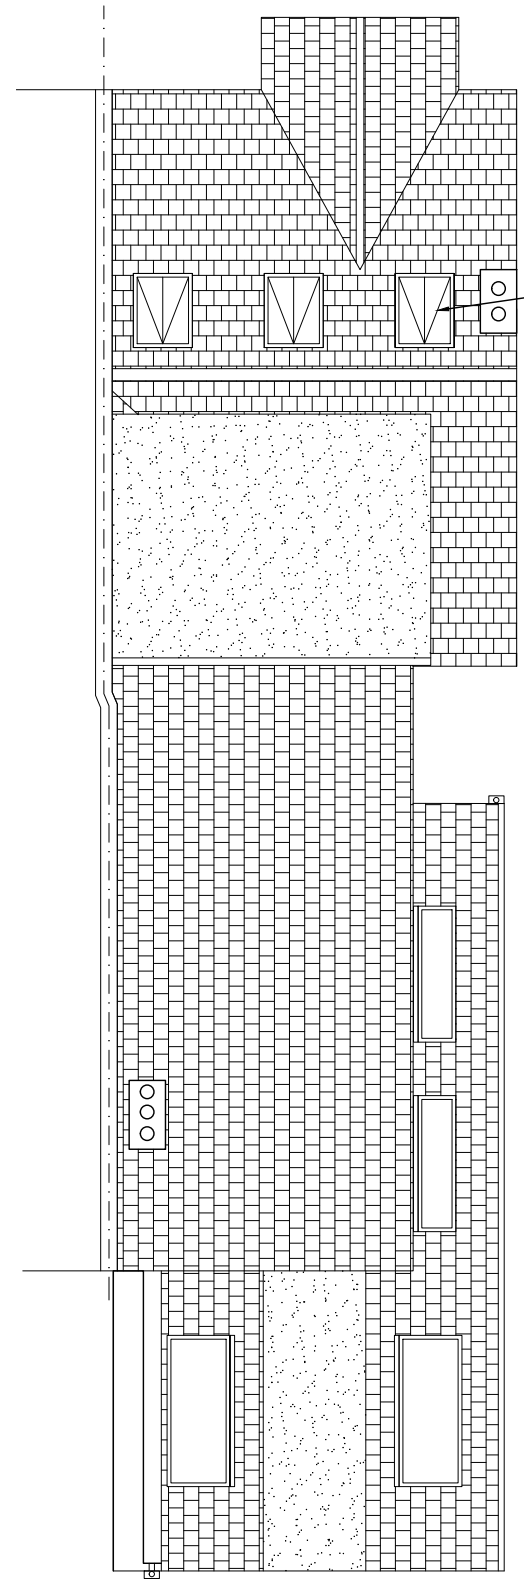

ROOF PLAN AS BUILT

Additional MK06 conservation grade velux window

Additional MK06 conservation grade velux window



FRONT ELEVATION AS BUILT



REVISIONS DATE DRN CKD REV

ISSUE STATUS **PLANNING**

CLIENT **MR & MRS DAY**

PROJECT **31 CLARENCE ROAD
 TEDDINGTON, TW11 0BN**

TITLE **PLANS & ELEVATIONS
 AS BUILT**

DRAWN CHECKED SCALE DATE
 DJC 1:100 @ A3 09.12.24

DRAWING No. **2205-02** REV **/**