



- 1 This drawing is copyright Peter Inskip + Peter Jenkins Architects Ltd and must not be used for purposes other than in relation to this project unless authorised by the Architect
- 2 This drawing must be read in conjunction with the specification
- 3 Any discrepancies or ambiguities in this drawing, or between this drawing and any other information, to be reported to the Architect for clarification and/or further instruction before work proceeds
- 4 This drawing must not be scaled - work to figured dimensions only
- 5 All dimensions to be verified on site before preparation of shop drawings and prior to work commencing on site
- 6 Shop drawings of manufactured items must be inspected by the Architect before manufacturing proceeds

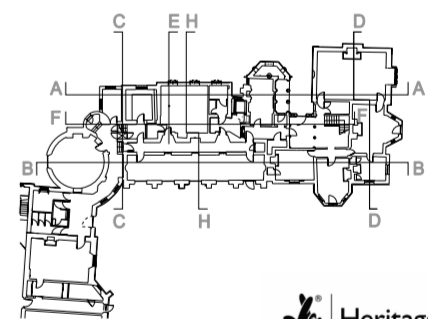

Heritage
LOTTERY FUNDED

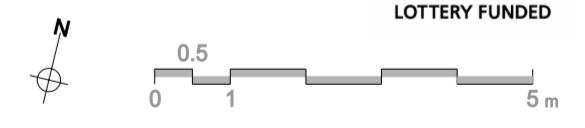

DATE	REVISION	COMMENT	AUTHOR	AUTHORIZED
23.01.12	/	CONSTRUCTION ISSUE	CM	SG

WALPOLE'S VILLA STRAWBERRY HILL HOUSE

TITLE
SOUTH ELEVATION AS BUILT

DWG NO SHT GA 412 SCALE 1:100@A2
DATE JAN 2011

PETER INSKIP + PETER JENKINS ARCHITECTS LTD
19 - 23 WHITE LION STREET LONDON N1 9PD
TELEPHONE 020 7833 4002 FAX 020 7278 5343