

IMPORTANT NOTE:

ALL MATERIALS AND COMPONENTS WITHIN EXTERNAL WALLS TO BE EITHER RATED EUROCLASS A1 OR A2,S1-d0 (WHEN ASSESSED TO EN 13501-1) UNLESS THEY ARE EXEMPT UNDER BUILDING REGULATION 7 AND FURTHER APPROVED BY BUILDING CONTROL

ALL MEMBRANES TO ACHIEVE CLASS B-S3,d0 OR BETTER

MOISTURE RESISTANT PLASTERBOARD TO BE USED IN WET AREAS AND AREAS OF HIGH HUMIDITY

ALL DETAILS TO ADHERE TO NHBC STANDARDS & ACCREDITED CONSTRUCTION DETAILS

MEMBRANE KEY

- High Performance Damp Proof Course
- Damp Proof Course
- Fixing Strip
- DPM to parapet plywood
- Detailing Cover Strip
- Air & Vapour Control Layer
- Breather Membrane
- Separating Membrane
- EPDM
- First Fix EPDM
- Airtightness Tape
- Cold Applied Liquid Waterproofing Membrane
- Air and Vapour Control Layer (AVCL)

Notes:
Do not scale. All dimensions are in millimetres unless otherwise stated. This drawing should be read in conjunction with all relevant project information and contract documentation. All dimensions to be checked prior to fabrication and or commencement of works. All works to comply with all relevant legal standards, building regulations and warranty provider requirements. Report any discrepancies, if in doubt ask.


Rev	Status	Date	Description	Drn	Chkd
P01	S3	17.07.24	FIRST ISSUE	RQ	
P02	S3	02.08.24	Metal Flashing increased to 2 brick coursing and fire barrier removed. Added Masonry Support.	FA	
P03	S3	11.10.24	Updates to show support brackets as per Curtains structural markup 30.08.24.	RQ	

Client Name:		London Square	
Project Name:		Richmond College	
Drawing Name:		Masonry Flat Blocks - External Canopy Type 2 & 3 Detail	
Drawing Number:		Rev:	Status:
RCL-BPTW-ZZ-DR-A-3811		P03	S3
Project No:	RIBA Stage:	Drawn By:	Scale:
23-057	4	RQ	1:10 @ A3

PRELIMINARY - FOR COMMENT

40 Norman Road,
Greenwich, London
SE10 9QX

t. 020 8293 5175
bptw.co.uk

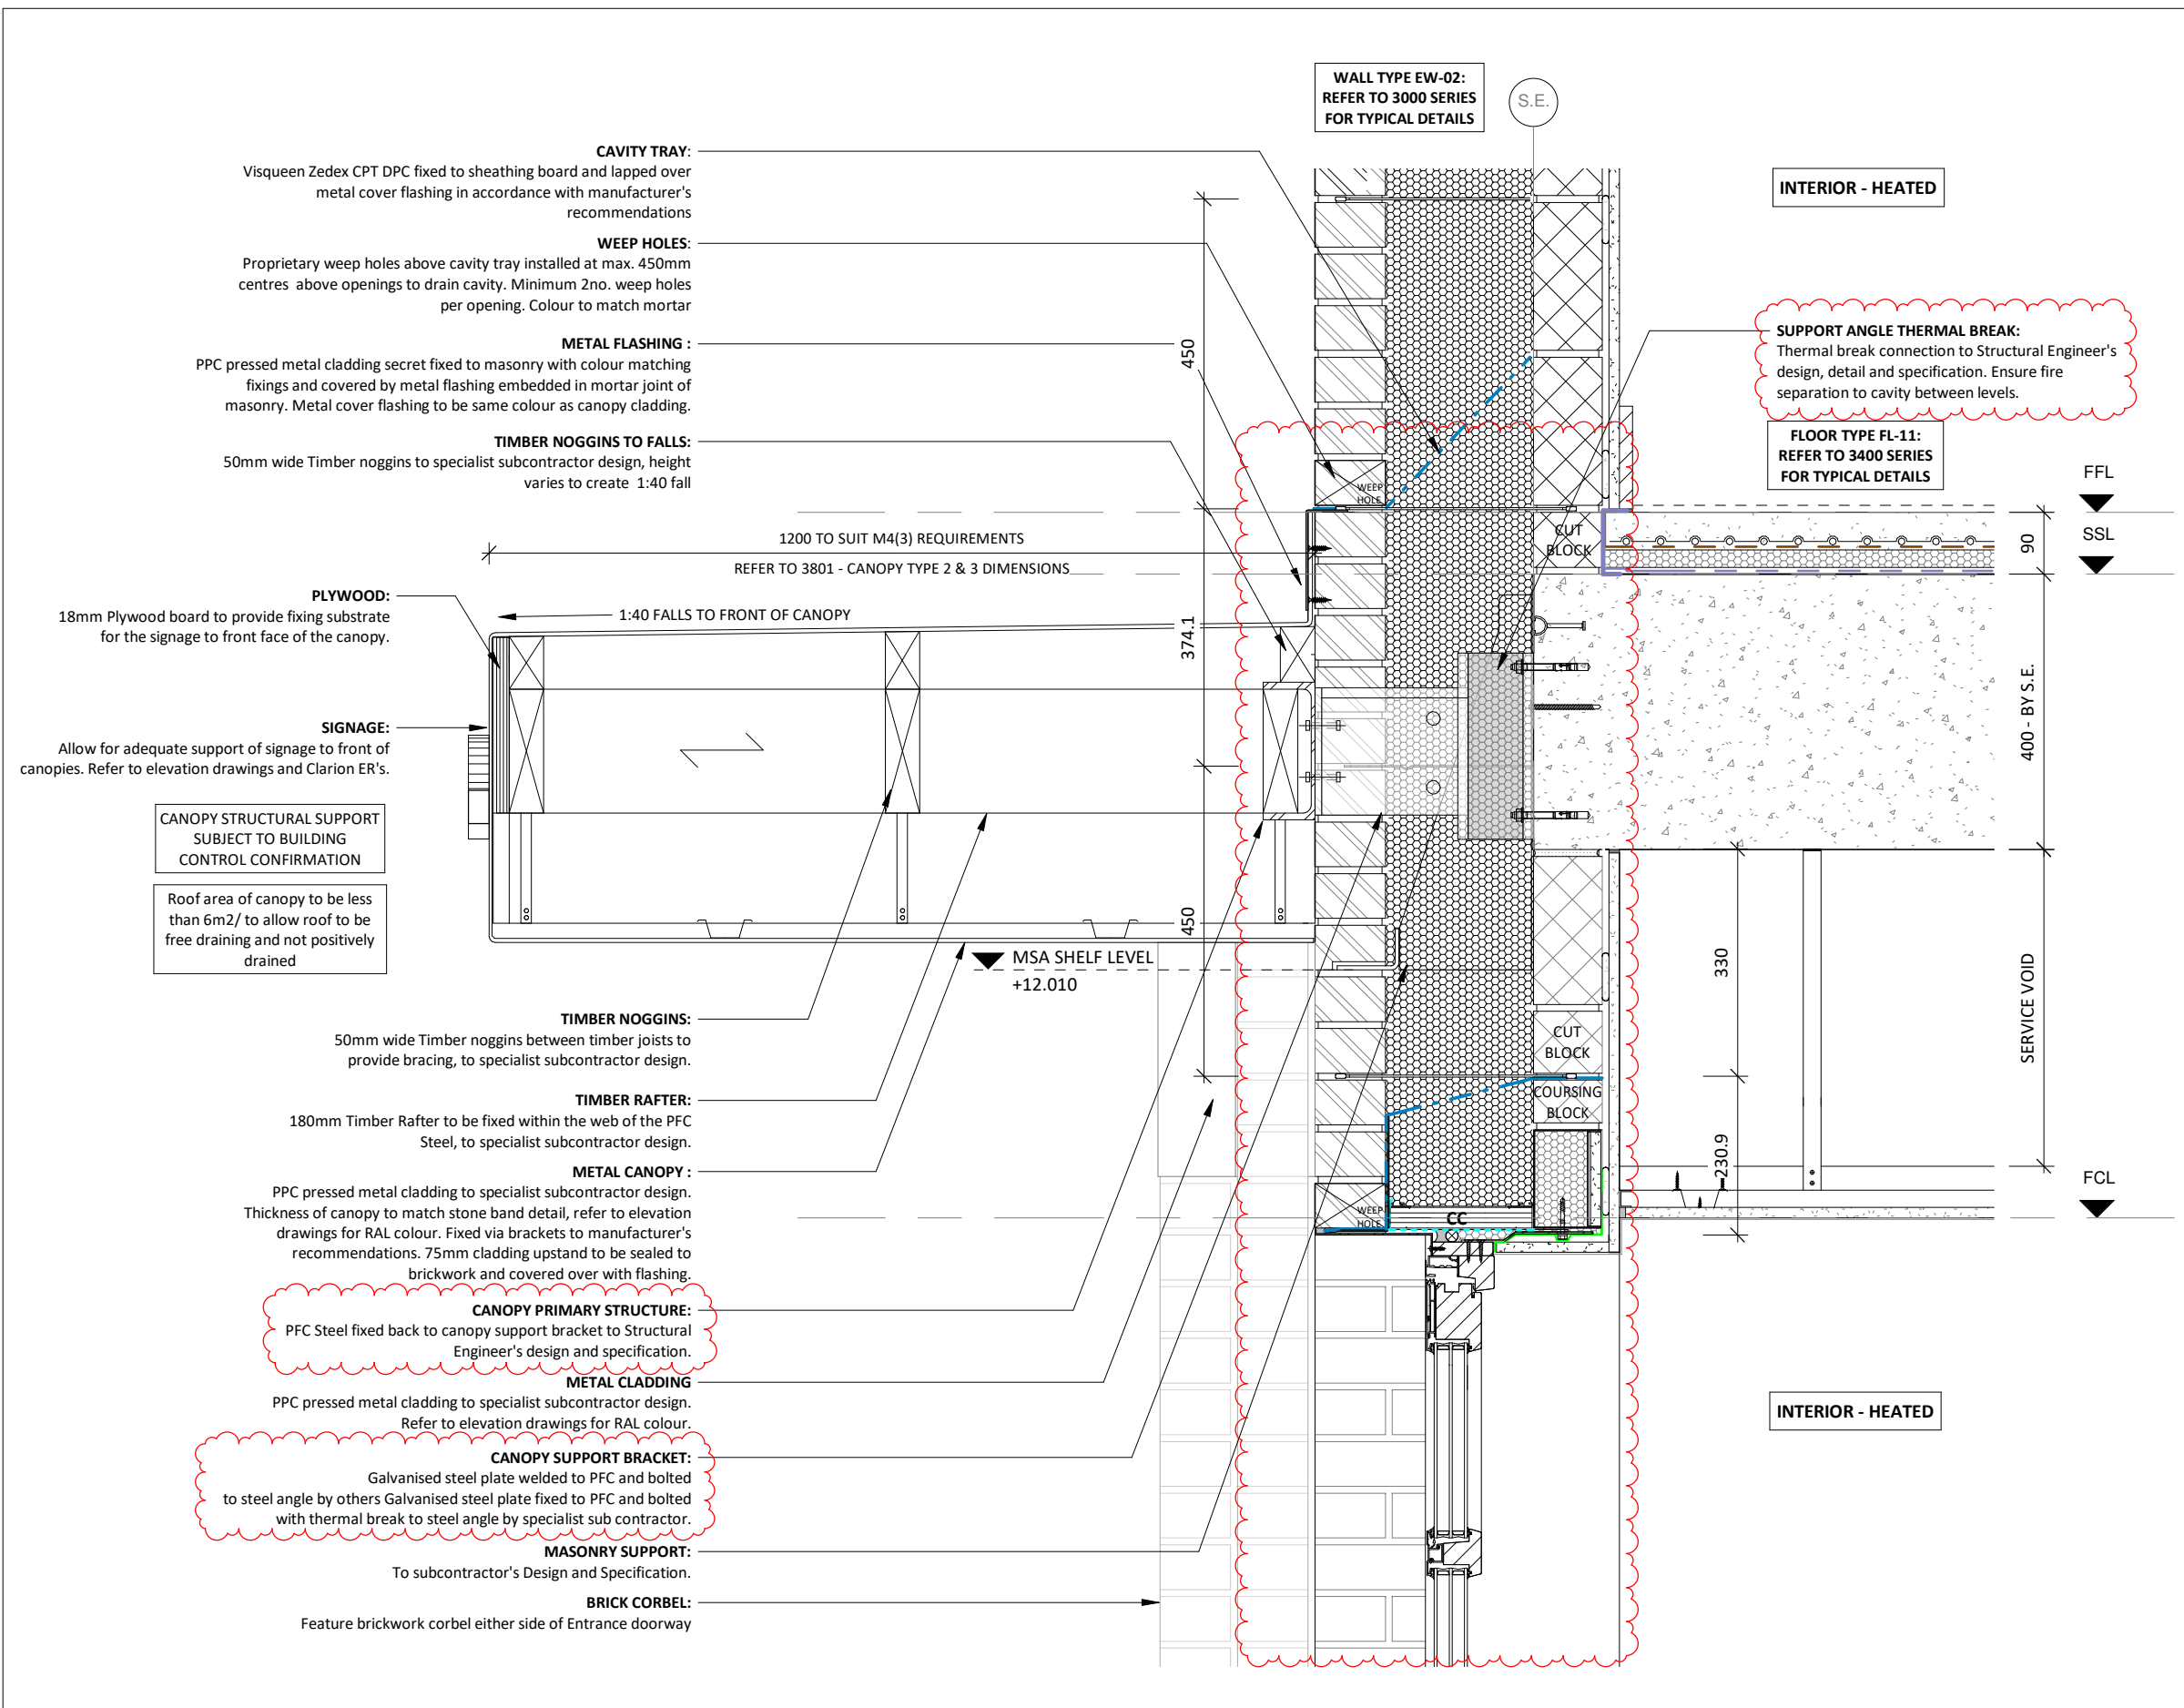

01 Masonry Flat Blocks - External Canopy Detail
1 : 10

