


Responsibility is not accepted for errors made by others in scaling from this drawing.
All construction information should be taken from figured dimensions only.

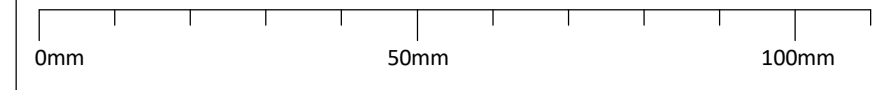

Roof area access

- ➔ Means of escape/access (man-safe fall restraint system to specialist sub-contractor design & specification)
- Note: Roof to be accessed by specialist training maintenance personnel only with use of man-safe system. Client to incorporate access strategy in accordance with 'Regulatory Reform Order 2005'
- Mansafe fall restraint system to roof as specialist drawing
- No loading allowed on GRP dormers

REV C5 - AS-BUILT ISSUE UPDATE

Rev	DESCRIPTION	DRW/CHK	Status	DATE
C5	As-Built Issue Update	MN/MN	AB	13/09/2021
C4	As-Built Issue	MN/MN	AB	23/08/2021
C3	Construction Issue Update	MN/MN	A	10/08/2021
C2	Construction Issue Update	MN/MAS	A	17/07/20
C1	Construction Issue	MN/MAS	A	29/06/20
T2	Updated tender issue set	MAS		22/05/20
T1	Tender Issue	MAS		28/04/20

CLIENT LOGO

CIRC Construction Management

ORIGINATOR

24 Church St. West,
Woking, Surrey,
GU21 6HT
01483 494 350
info@prc-group.com
www.prc-group.com

Architecture
Planning
Master Planning
Urban Design
Interiors
Landscape

Offices
Woking
London
Milton Keynes
Warsaw

PROJECT
Mulberry Court, C102 11177

DRAWING TITLE
Roof Plan - Overall

BIM FILE NAME

PROJECT STAGE
RIBA Stage 5 FIRST ISSUE DATE
13.09.2019

STATUS CODE
CR : CONSTRUCTION RECORD SCALE
1 : 100 @ A1

PROJECT	ORIGINATOR	ZONE	LEVEL	TYPE	ROLE	NUMBER	REV
C102	PRC		RF	DR	AR	13006	C5