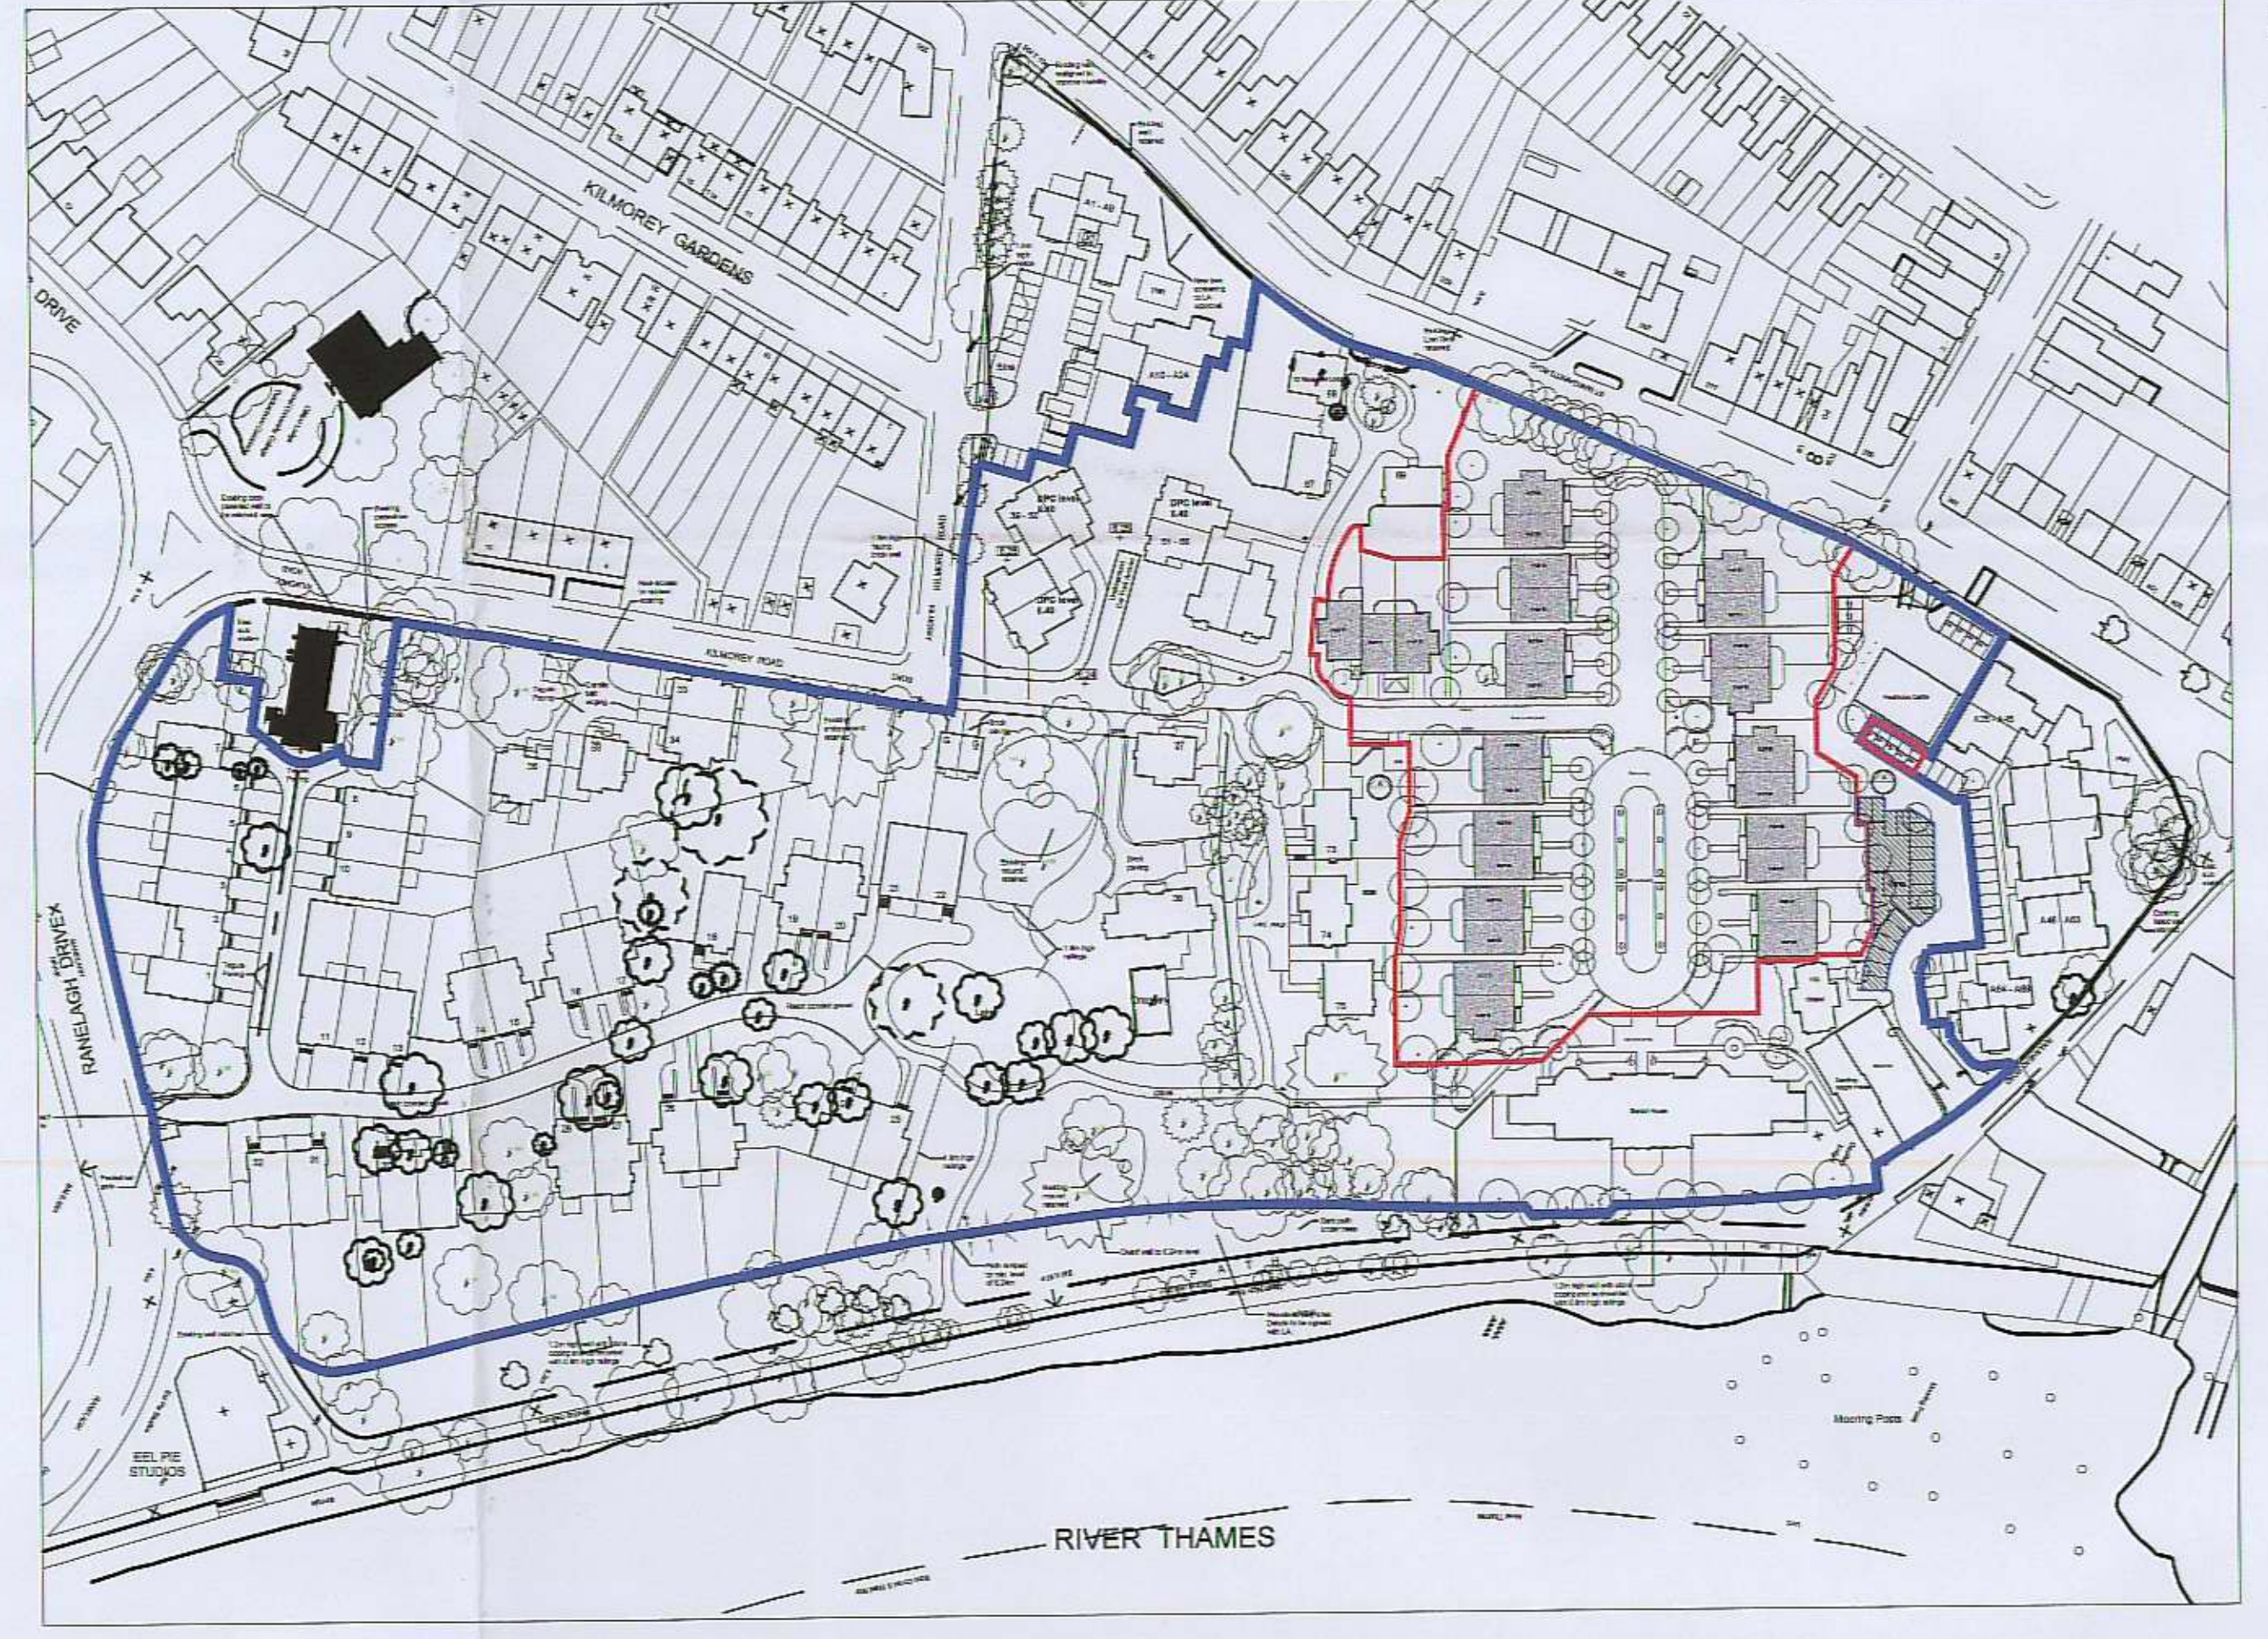
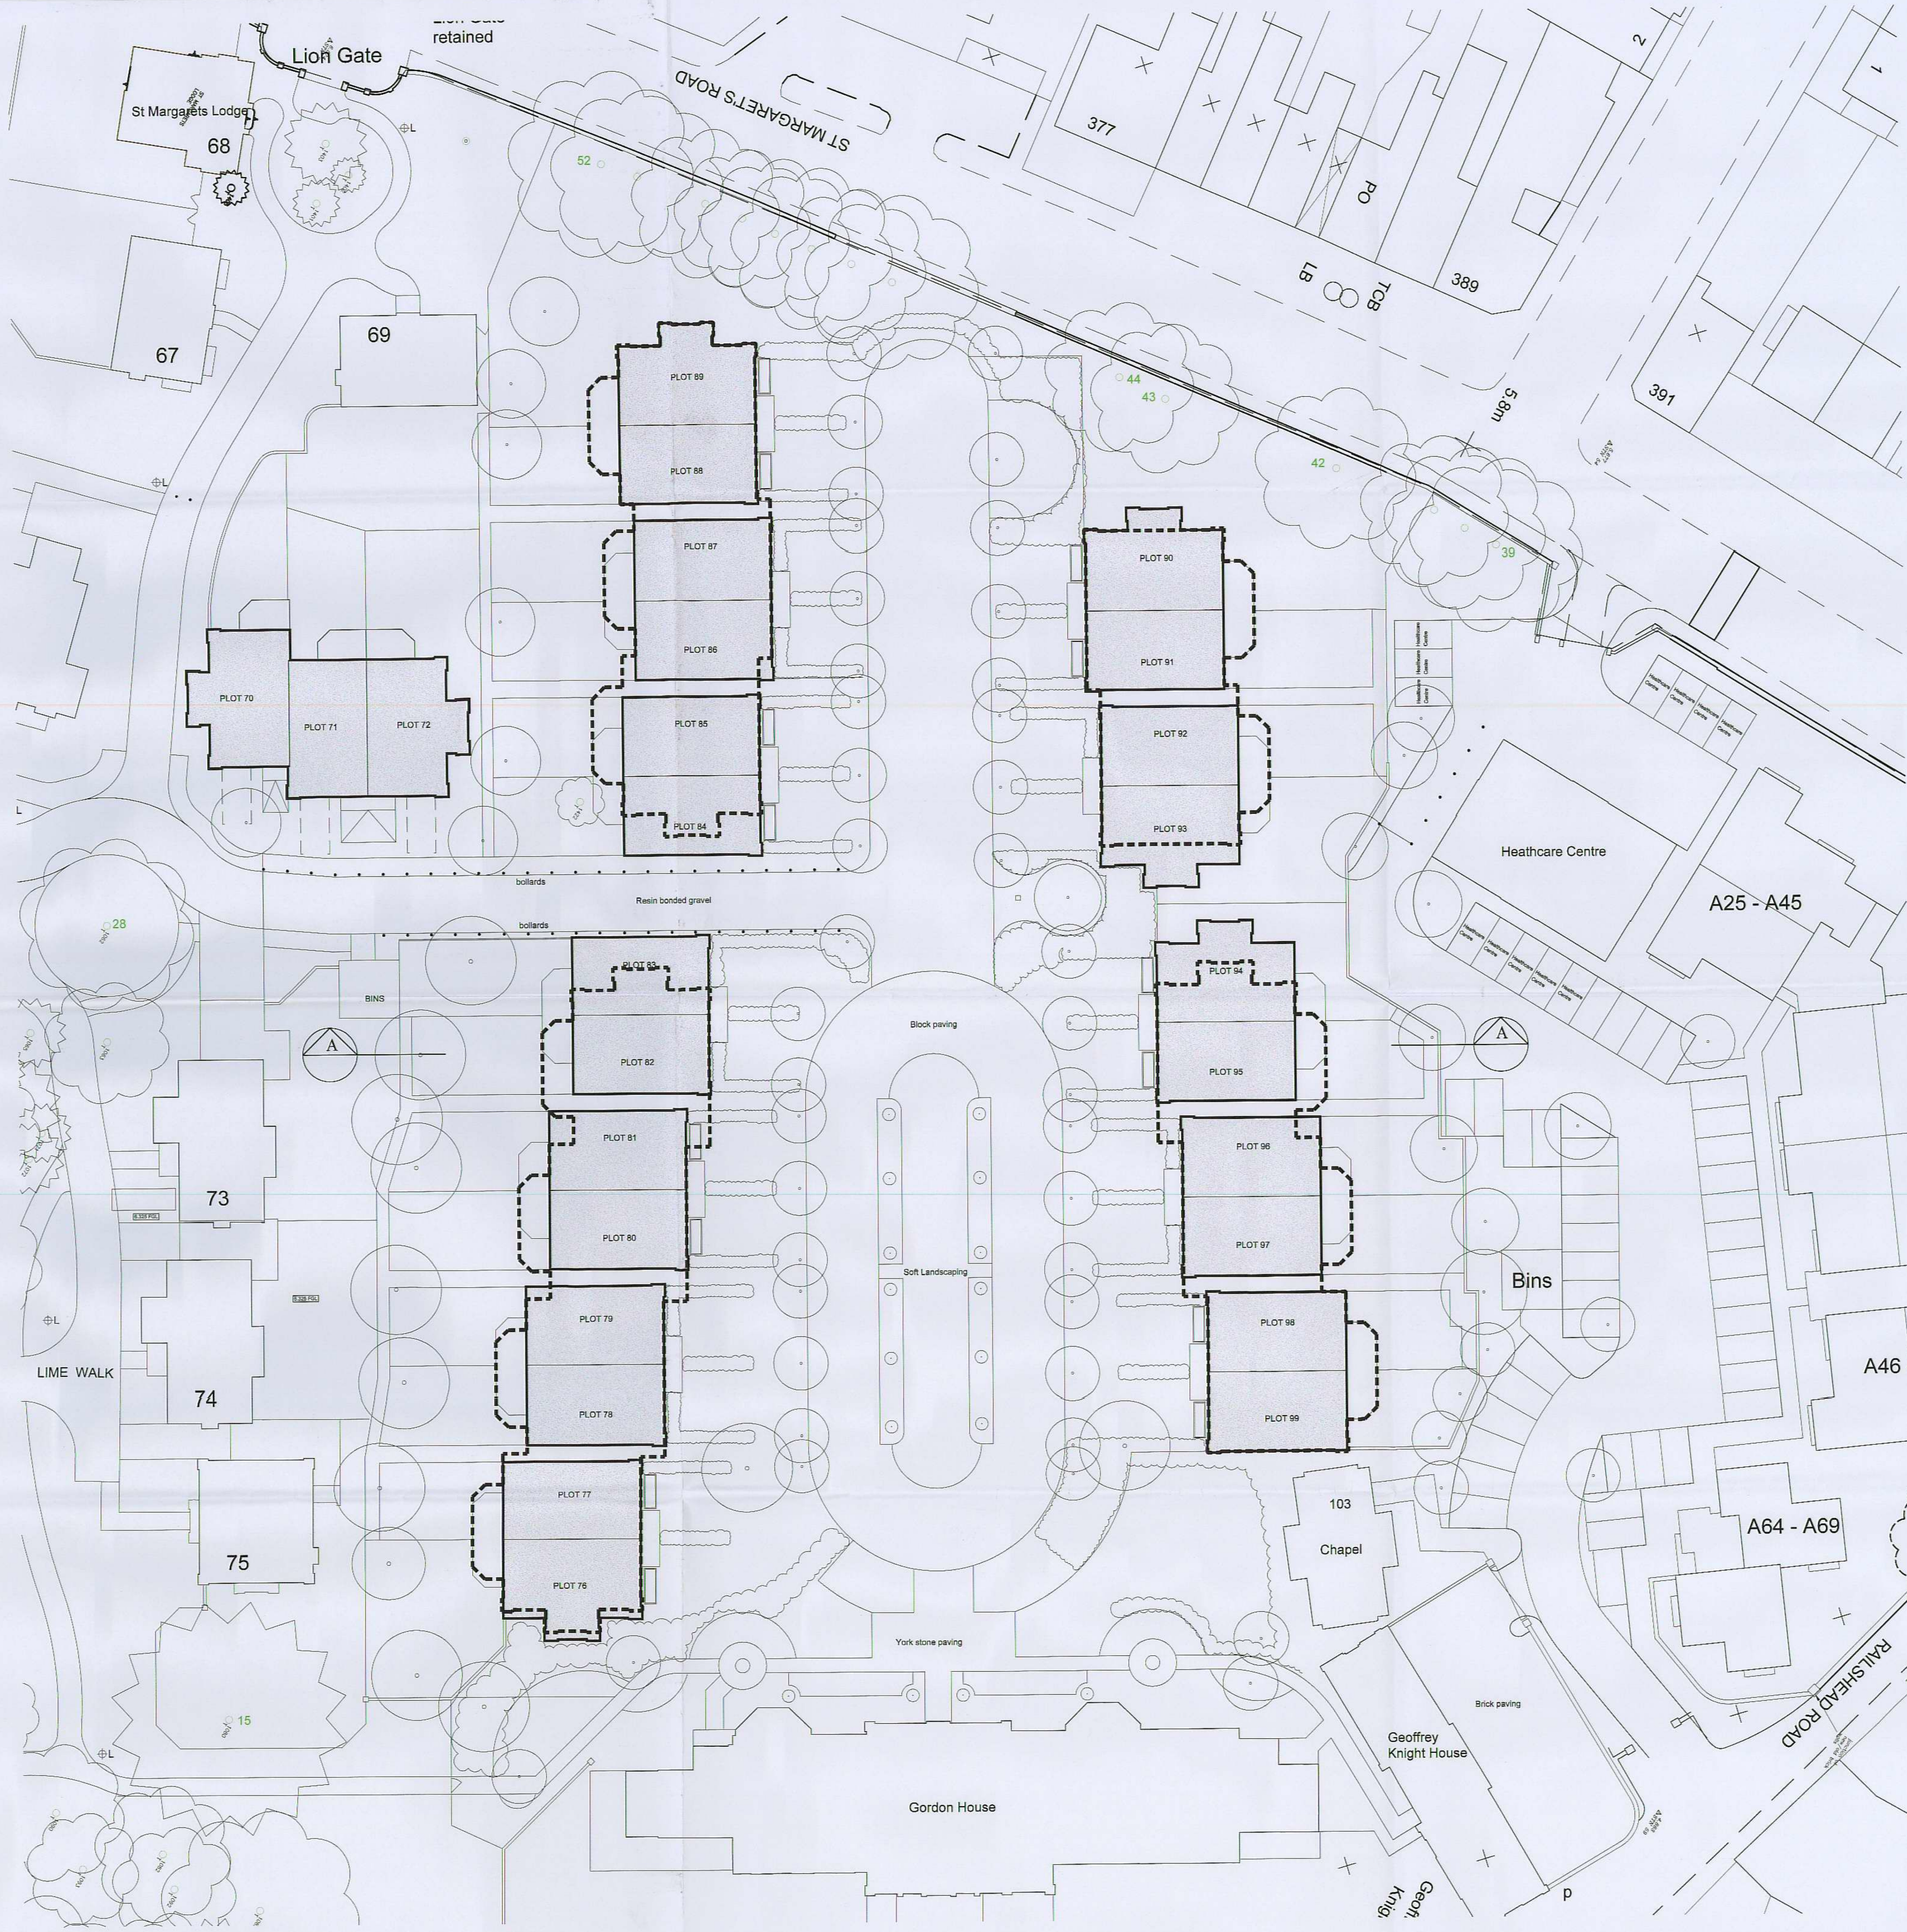

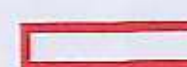




DO NOT SCALE THIS DRAWING. TYPICAL DIMENSIONS ARE TO BE USED FOR THE WORKS. ANY DIMENSIONS NOT STATED ARE TO BE TAKEN FROM THE ORIGINAL ARCHITECTURAL RECORD DRAWINGS. DIMENSIONS SHOWN ON THIS DRAWING ARE TO BE TAKEN FROM THIS DRAWING UNLESS OTHERWISE STATED.


Rev	Description	By	Date
001	ISSUE FOR PERMIT	JOW	20/06/06
002	ISSUE FOR PERMIT	JOW	20/06/06
SITE LOCATION PLAN 1:1250

-  EXTENT OF PREVIOUS PLANNING APPLICATION
-  EXTENT OF CURRENT APPLICATION
-  EXTENT OF LAND WITHIN THE APPLICANT'S OWNERSHIP/CONTROL
-  EXTENT OF LAND NOT WITHIN THE APPLICANT'S OWNERSHIP/CONTROL

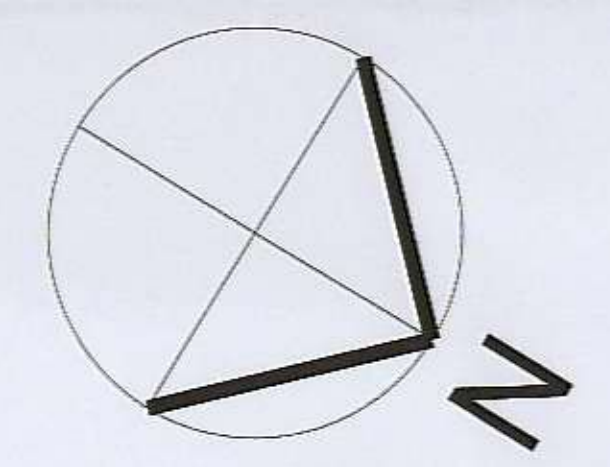ALL LEVELS SUBJECT TO FINAL SITE CHECK PRIOR TO CONSTRUCTION



SITE LAYOUT PLAN 1:200

Design Group 3 | Architects

Client: **OCTAGON**

1 Queen Square, Brighton, East Sussex BN1 3FD.  
Tel: 01273 720807 Fax: 01273 720808  
E-mail: Brighton@dg3a.co.uk Website: www.designgroup3.co.uk

Project Name: **The Townhouses, Richmond Lock, Replanning**

Drawing Title: **Site Layout/Location Plans**

Project No:	0379	Drawing No:	100	Scale:	As Shown	Revision:	P06
Drawing Stage:	PLANNING	Date:	Sep 2005	Scale:	1:200	Drawn:	JOW