Amended Second Floor Planning Drawing

Curtain Walls, Windows and Door Openings

1 Proposed Change: Window / louvre design rationalised and aligned.
Reasons: Opening rationalized to suit revised elevation and CDM requirement.

Facade Material Change

1 Proposed Change: Cladding changed to render.
Reasons: Brick cladding replaced to reduce massing in combination with hall area.

2 Proposed Change: Cladding changed to brick.
Reasons: Render replaced to create differentiation with plant room.

3 Proposed Change: Green roof position moved to main roof level.
Reasons: Green roofs combined on top floor for improved maintenance access.

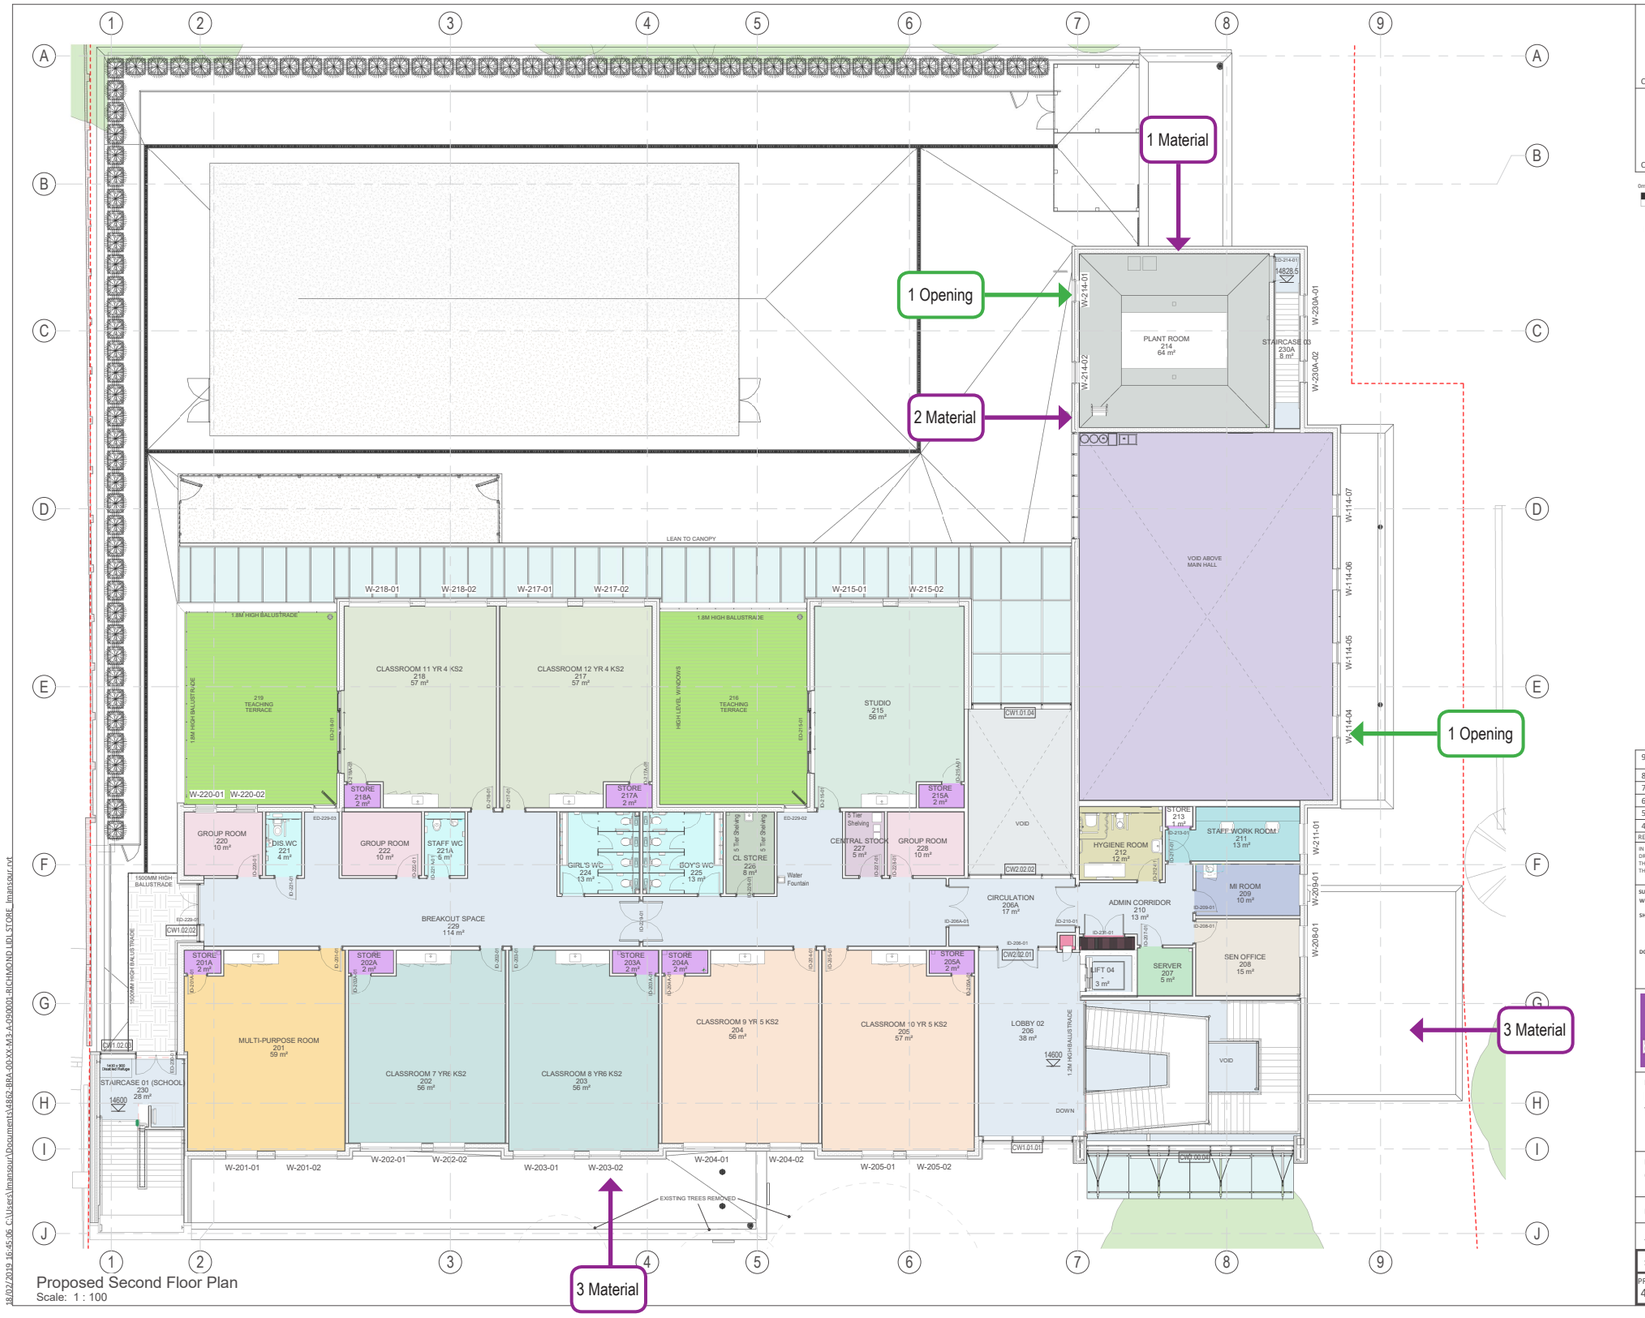

Proposed Second Floor Plan
Scale: 1 : 100

Client's Logo :

Contractor's Logo:

REV	DATE	DESCRIPTION	BY
9	21.12.18	Updated for construction with latest package information	JC
8	03.10.18	GA plan general update	TN
7	24.08.18	Planning Issue	JC
6	19.06.18	GA Plans, Elevations and Sections issued with DWG	JC
5	04.06.18	Design Development	GCP
4	06.02.18	Design development	WW

IN CASE OF DOUBT OR DISCREPANCIES PLEASE REFER TO ARCHITECT FOR INSTRUCTIONS.
DRAWING AND SUITABILITY NUMBERS IN ACCORDANCE WITH BS1192:2007.
THIS DRAWING SHOULD NOT BE SCALED.
THIS DRAWING IS COPYRIGHT.

SUITABILITY NUMBER KEY:
WIP
S0 - Work in Progress*
SHARED
S1 - Fit for co-ordination**
S2 - Fit for information
S3 - Fit for internal review and comment
S4 - Fit for construction approval
DOCUMENTATION
D1 - Fit for costing
D2 - Fit for tender
D3 - Fit for contractor design
D4 - Fit for manufacture/ procurement

DOCUMENTATION - SIGN-OFF
A - Fit for construction
B - Fit for construction, with comments
C - Comprehensive revisions needed
ARCHIVE
A8 - As Built
FC - Final Construction

* For internal pre-issue usage only.
** For model file usage only.

boyesrees architects
4th Floor, Greyfriars House
Greyfriars Road, Cardiff CF10 3AL
Tel: 029 2055 8900 Fax: 029 2039 9592
www.boyesrees.co.uk
Registered office. As above Reg No. 295 1683 (England & Wales)

PROJECT TITLE :
Proposed LIDL store on Richmond Road Twickenham

DRAWING TITLE :
GA Second Floor Plan

DRAWN BY : ADT		SCALE :	As indicated @ A1
JOB NO : 4862		DATE :	05/20/16
SUITABILITY : S3		REVISION:	9

PROJECT	ORIGIN.	VOLUME	LEVEL	TYPE	DISCIP	NUMBER
4862	BRA	00	02	DR	A	0102

18/02/2019 16:45:06 C:\Users\mansour\Documents\4862-BRA-00-XX-M3-A-02000-LIDL-RICHMOND-LIDL-STORE_mansour.rvt