


CIVIS
153-9021
Certificate No. GB2005290

General Notes:
Do not scale from this drawing. Use marked dimensions only. Should any discrepancies be noted, please inform this office immediately. This drawing is copyright of Matthew Alchurch Architects Limited.




■ Shared Ownership

P06	Affordable Units Markup	14.11.2022	AQ	SSB
P05	Planning Issue	08.10.2021	AQ	SSB
P04	Issue For Information	06.07.2021	AQ	SSB
P03	Progress Issue	18.06.2021	AQ	SSB
P02	Draft Issue For Information	09.04.2021	AQ	SSB
P01	Draft Issue For Information	01.04.2021	AQ	SSB
Rev:	Description:	Date:	Drw:	Chk:



the boathouse design studio
27 ferry road teddington tw11 9nn
t: 020 8973 0050
e: info@maa-architects.com
w: www.maa-architects.com

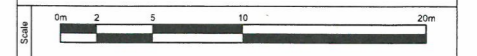

Client: **Waldegrave Mews Ltd**

Project Name: **Waldegrave Mews**

Drawing Title: **Proposed Block Plan: First Floor**

Drawing Status:	Status Code: S1	Project No: MA014	Scale at A1: 1:200
Drawing No:	Revision: P06	Date: 08.10.21	Scale at A3: 1:400
MA014-MAA-XX-DR-A-01102			