01 03 05
02 04
SCALE (m)

N

notes	CDM Regulations 2015
- The contractor is responsible for checking dimensions, tolerances and references. Any discrepancy to be verified with the Architect before proceeding with the works. - Where an item is covered by drawings to different scales the larger scale is to be worked to. - Do not scale drawing. Figured dimensions to be worked to in all cases. - The drawing information must be read in conjunction with all relevant scheme drawings, TECHNICAL NOTES drawings, specification and/or schedules referred to or not. - True line of boundary and ownership to be established on site. Red line boundary extent to be confirmed by client.	ALL current drawings and specifications for the project must be read in conjunction with the Designer's Hazard and Environmental Assessment Record & Construction Phase Plan. Client to comply with CDM 2015 duties.

CDM 2015

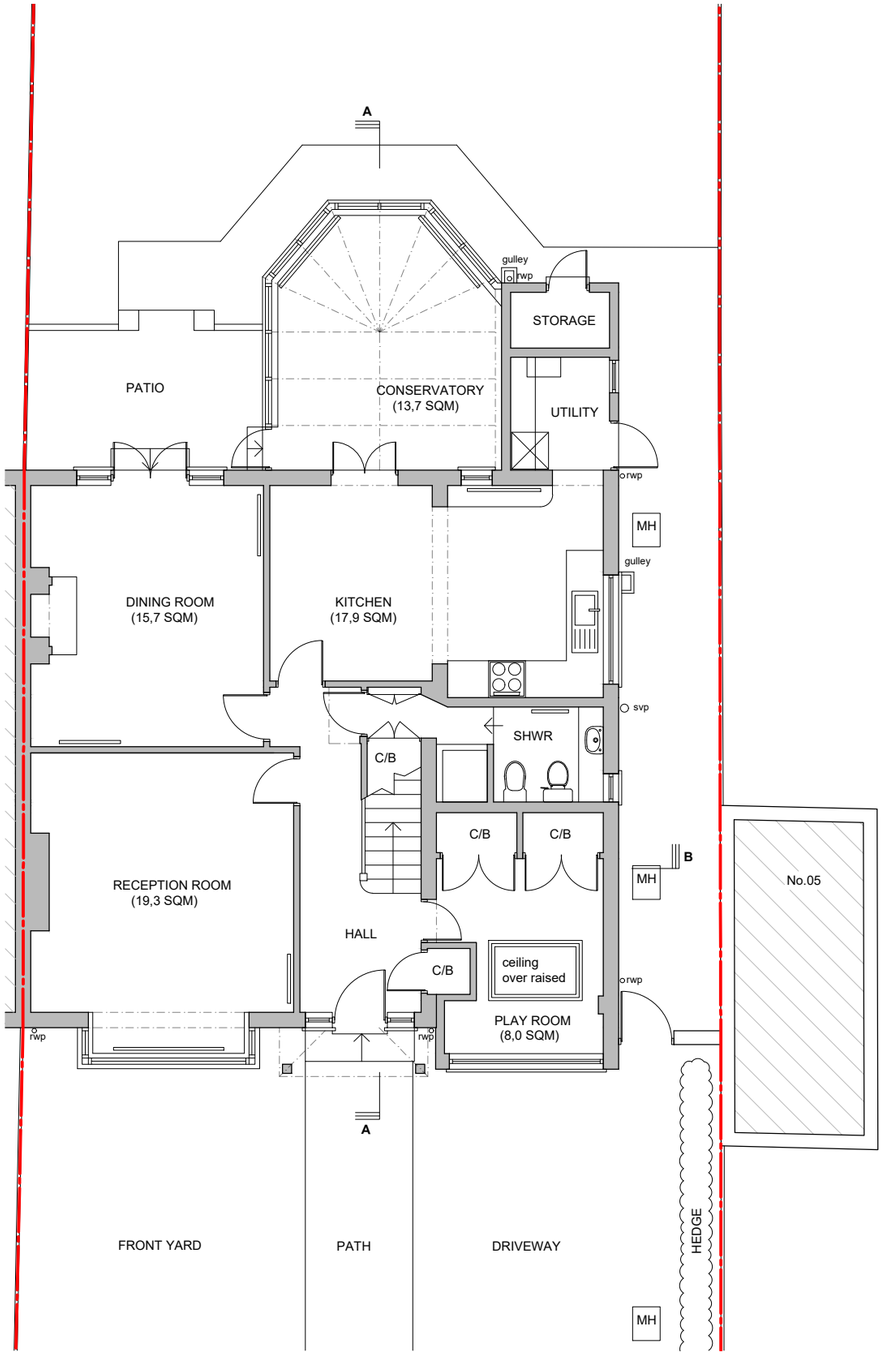

PROPOSED GROUND FLOOR PLAN

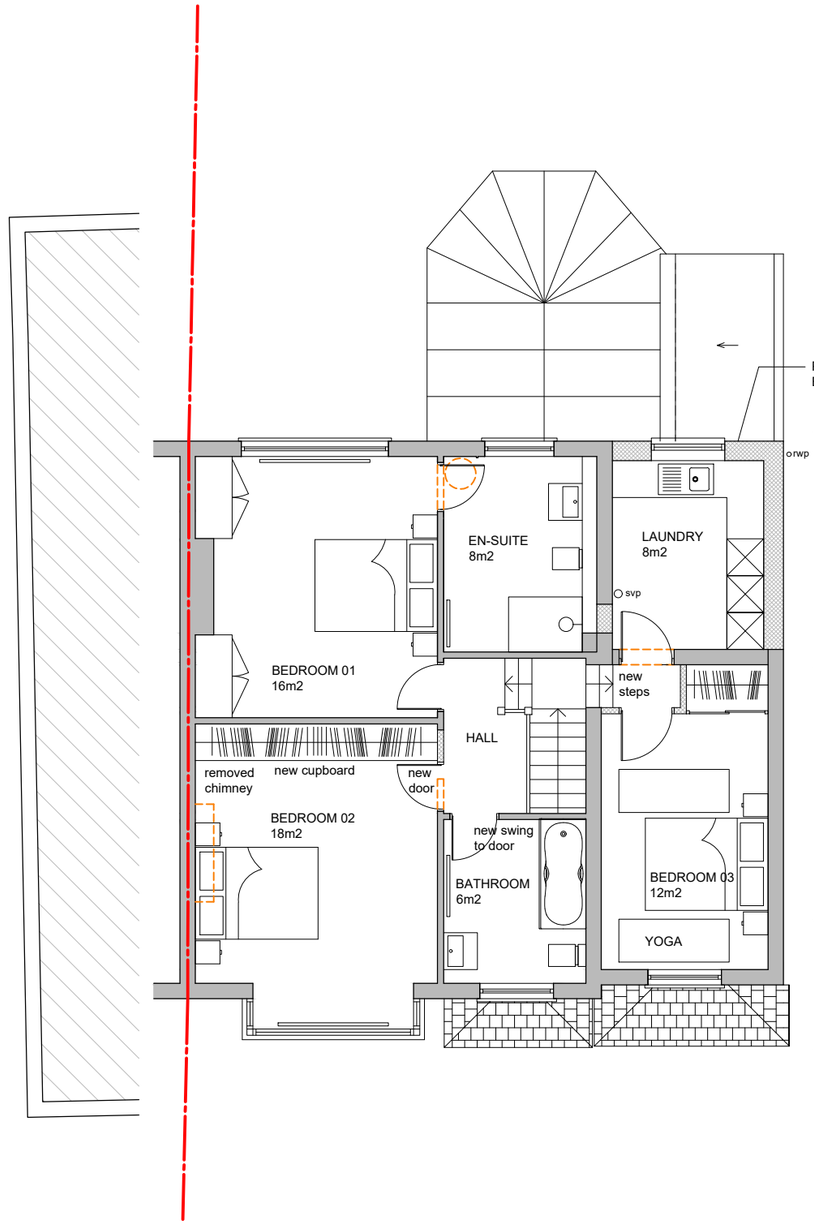

PROPOSED FIRST FLOOR PLAN

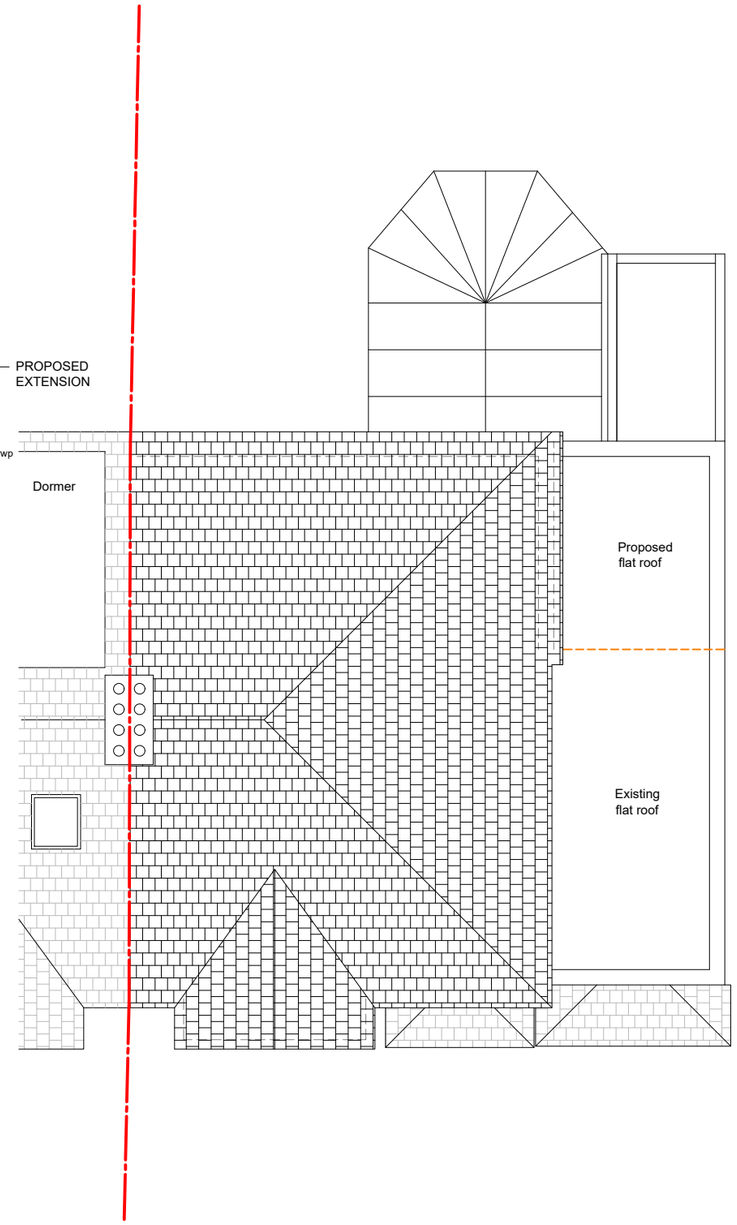

PROPOSED ROOF PLAN

date	rev	revision/author/checker		project	purpose of issue		TW10 architects
			drawn SO	3 Ullswater Road SW13 9PL	PLANNING		Richmond son@tw10architects.com 07568184305
			scale @ A3 1:100	drawing PROPOSED PLANS	drawing no U3_22	rev /	
			date 06.08.2024				