

**Gordon House Garden**  
Planting Schedule  
19/02/2024

Area	Plant	size	quantity	proposed planting season
1	Laurus nobilis	4m high x 1m wide	16	Spring or Autumn 2024
2	Magnolia grandiflora	4.5m high x 2.5m wide	1	Spring or Autumn 2024
	Laurus nobilis	3.5m high x 2m wide	5	Spring or Autumn 2024
	Malus transitoria	2.5m high x 2m wide	1	Spring or Autumn 2024
	Liriodendron tulipifera	3.5m high x 2m wide feathered	1	Spring or Autumn 2024
	Crataegus prunifolia	3m high x 2.5m wide multi-stem	2	Spring or Autumn 2024
3	Laurus nobilis	4m high x 2.5m wide	3	Spring or Autumn 2024
	Elaeagnus umbellata	2m high x 1m wide	2	Spring or Autumn 2024
	Laurus nobilis	3.5m high x 2m wide	4	Spring or Autumn 2024
	Prunus lusitanica Angustifolia	4m high x 2.5m wide	1	Spring or Autumn 2025
4	Prunus lusitanica Angustifolia	4.5m high x 3m wide	3	Spring or Autumn 2024
	Laurus nobilis	4.5m high x 2m wide	5	Spring or Autumn 2024
5	Laurus nobilis	4m high x 2.5m wide	3	Spring or Autumn 2024
6	Prunus lusitanica Angustifolia	4.5m high x 3m wide	3	Spring or Autumn 2024
	Laurus nobilis	4.5m high x 3m wide	1	Spring or Autumn 2024
7	Prunus lusitanica Angustifolia	4.5m high x 3m wide	1	Spring or Autumn 2024
	Laurus nobilis	4.5m high x 3m wide	3	Spring or Autumn 2024
	Magnolia grandiflora	4.5m high x 2.5m wide	1	Spring or Autumn 2024
	Camellia japonica	3m high x 2m wide	3	Spring or Autumn 2024
	Osmanthus heterophyllus	2.5m high x 1.25m wide	2	Spring or Autumn 2024
	Taxus baccata	4m high x 3.5m wide	3	Spring or Autumn 2024
8	Magnolia grandiflora	4.5m high x 2.5m wide	1	Spring or Autumn 2024
	Prunus lusitanica Angustifolia	4.5m high x 3m wide	3	Spring or Autumn 2024
	Taxus baccata	4m high x 3.5m wide	2	Spring or Autumn 2024
	Osmanthus heterophyllus	2.5m high x 1.25m wide	5	Spring or Autumn 2024
	Laurus nobilis	4.5m high x 2m wide	1	Spring or Autumn 2024
	Crataegus monogyna	3m high x 2.5m wide	1	Spring or Autumn 2024


South Garden Planting				
S3-10	trees	Elaeagnus umbellata	2.5m high multi-stem	3 Autumn 2025
		Crataegus laevigata 'Carrerei'	2.5m high multi-stem	3 Autumn 2025
		Crataegus coggygria	2.5m high multi-stem	5 Autumn 2025

North Garden Planting				
N1-10	trees	Malus transitoria	2.5m high multi-stem	1 Autumn 2025
		Cladostriis lutea	2.5m high multi-stem	1 Autumn 2025
		Crataegus monogyna	2m high multi-stem	1 Autumn 2025

**Additional Trees**

- 1 no. Malus transitoria multi-stem 2m high
- 1 no. Quercus robur 18-20cm girth

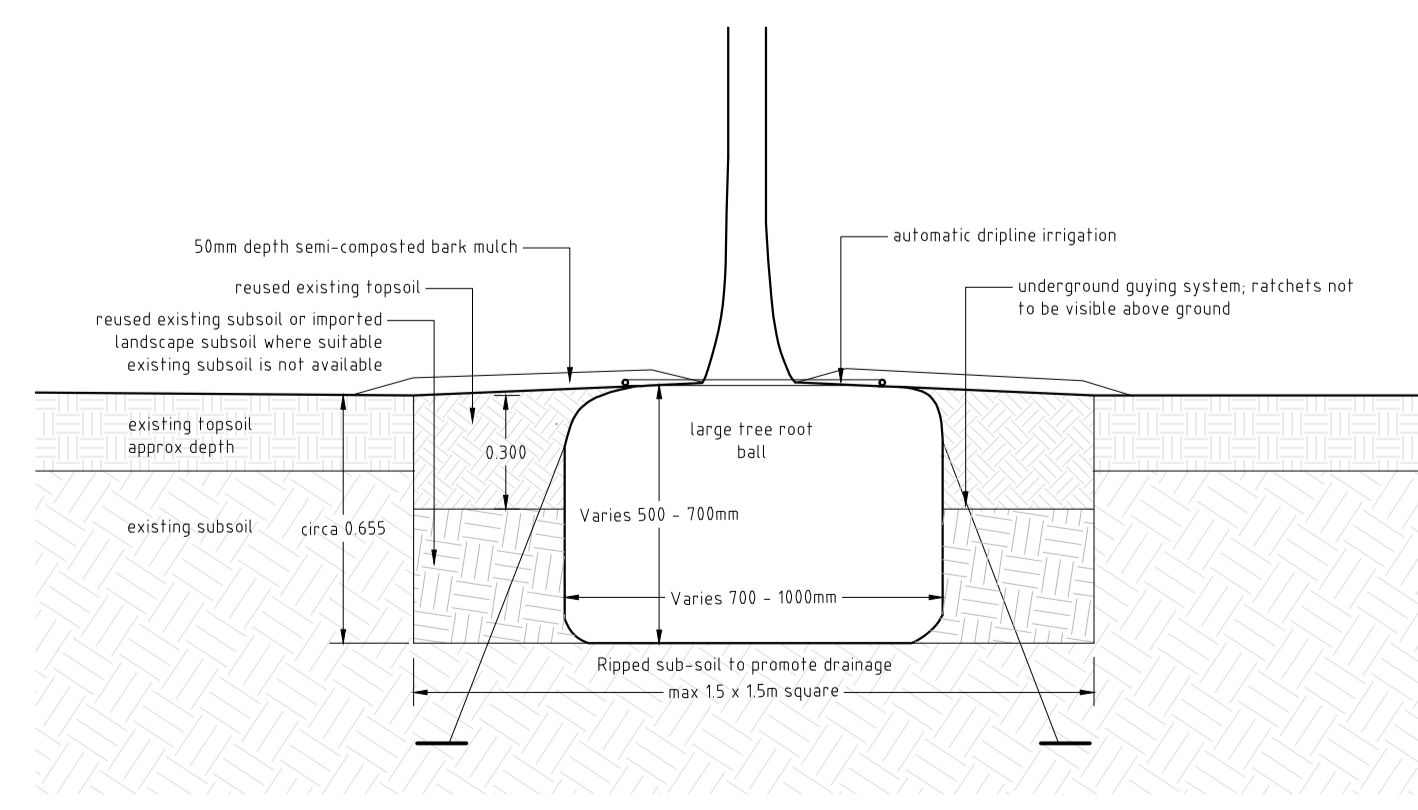

Detail 01 - Tree planting section  
Scale 1:20

**Key 1:200**

Proposed Level 30.550  
Existing Level 12.350

Tree Proposed (circle with cross)  
Tree Existing (circle with dot)

Proposed plant bed (green square)  
Proposed wildflowers and long grass (light green square)

0 5m

Rev. Comment Date  
R02 Tree planting section detail added 05/03/2024  
R03 2 additional trees added. Changes shown with red lines 09/09/2024

**Tom Stuart-Smith Ltd**  
The Dairy Studio, Sengell Lane, Bedmond, Abbots Langley, W5 0RZ  
Tel: +44 (0)207 253 2100

Status: Planning

Project:  
Gordon House - Pool Garden

Drawing:  
Tree Planting Scheme

Scale: 1:100 @ A0  
Dwg: 443-L-P-812 Rev: P03

Drawn: ZM  
Date: 08/11/2023

H:\143 Gordon House - Pool Garden\Drawings\443 - Gordon House - Pool Garden - Planting Plan FOR PLANNING.dwg

**Program and Maintenance**

Boundary planting April 2024  
Maintenance by contractor according to specification until May 2025. Thereafter by Gardener.

South and North Gardens planting May - October 2025  
Maintenance by Gardener.