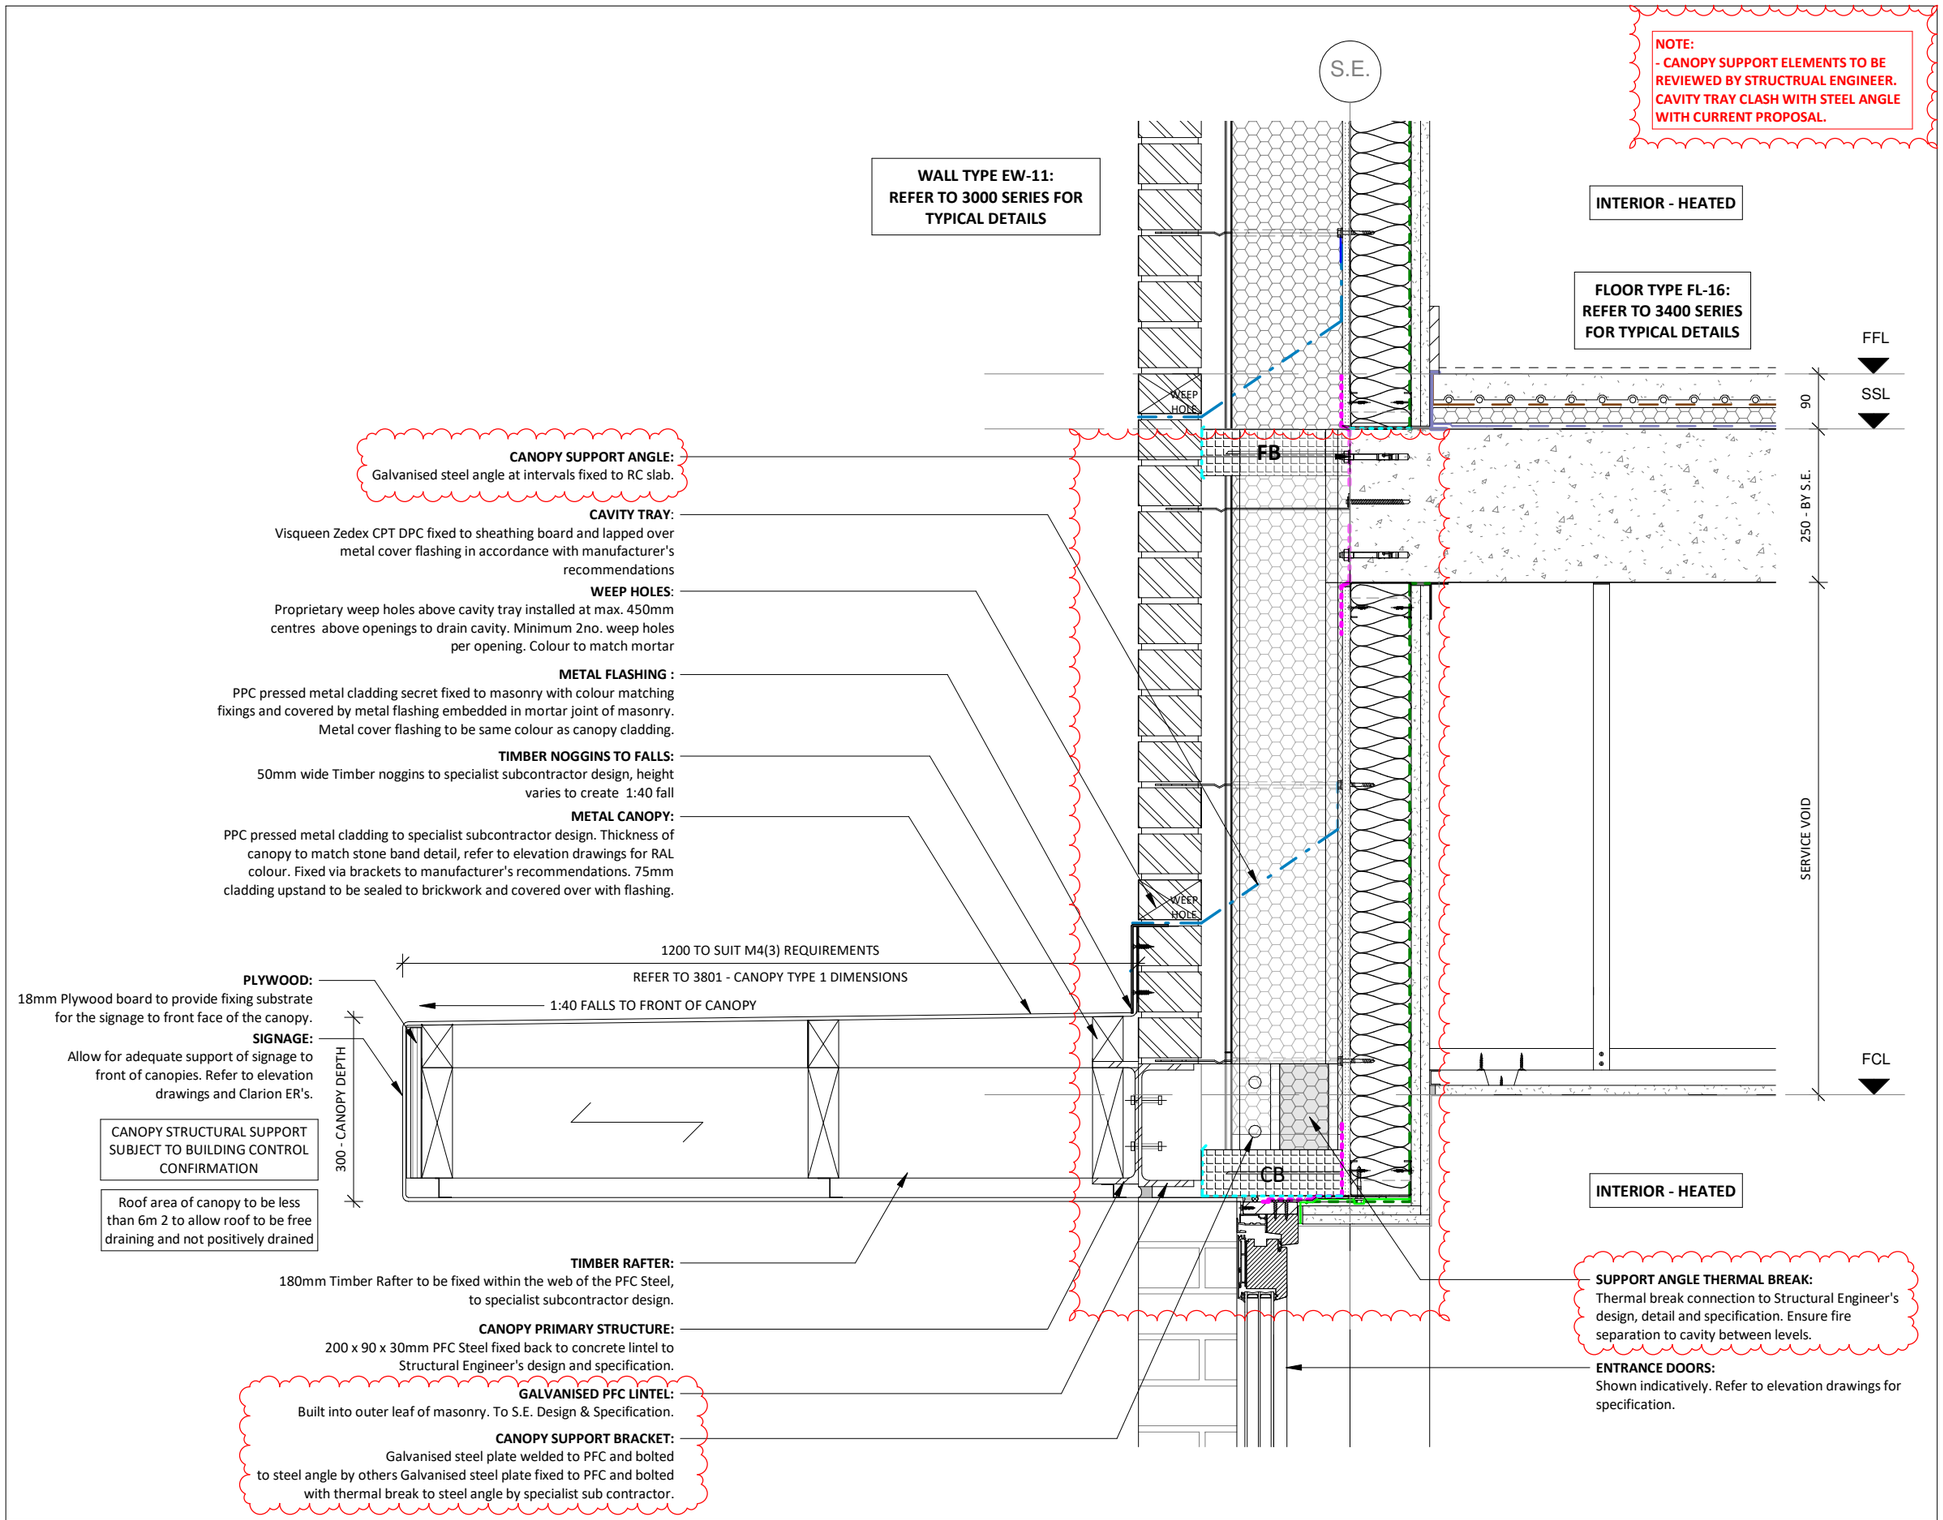

01 RC Frame Flat Block - External Canopy Detail

1 : 10

IMPORTANT NOTE:

ALL MATERIALS AND COMPONENTS WITHIN EXTERNAL WALLS TO BE EITHER RATED EUROCLASS A1 OR A2,S1-d0 (WHEN ASSESSED TO EN 13501-1) UNLESS THEY ARE EXEMPT UNDER BUILDING REGULATION 7 AND FURTHER APPROVED BY BUILDING CONTROL

ALL MEMBRANES TO ACHIEVE CLASS B-S3,d0 OR BETTER

MOISTURE RESISTANT PLASTERBOARD TO BE USED IN WET AREAS AND AREAS OF HIGH HUMIDITY

ALL DETAILS TO ADHERE TO NHBC STANDARDS & ACCREDITED CONSTRUCTION DETAILS

MEMBRANE KEY

- Damp Proof Course
- Damp Proof Membrane
- Fixing Strip
- Tanking Primer
- Detailing Cover Strip
- Air & Vapour Control Layer
- Breather Membrane
- Seperating Membrane
- EPDM
- First Fix EPDM
- Airtightness Tape
- Cold Applied Liquid Waterproofing Membrane

Notes:
Do not scale. All dimensions are in millimetres unless otherwise stated. This drawing should be read in conjunction with all relevant project information and contract documentation. All dimensions to be checked prior to fabrication and or commencement of works. All works to comply with all relevant legal standards, building regulations and warranty provider requirements. Report any discrepancies, if in doubt ask.

Revisions:

Rev	Status	Date	Description	Drn	Chkd
P01	S3	05.04.24	FIRST ISSUE	DL	
P02	S3	17.07.24	Canopy structure updated following discussions with Curtains 11.07.24.	RQ	
P03	S3	02.08.24	Metal flashing increased to 2 brick courses	FA	
P04	S3	11.10.24	Updates to show support brackets as per Curtains structural markup 30.08.24.	RQ	

Client Name: London Square

Project Name: Richmond College

Drawing Name: RC Frame Flat Blocks - External Canopy Type 1 Detail

Drawing Number:	Rev:	Status:
RCL-BPTW-ZZ-ZZ-DR-A-3851	**P04**	S3

Project No:	RIBA Stage:	Drawn By:	Scale:
23-057	4	DL	1:10 @ A3

PRELIMINARY - FOR COMMENT

40 Norman Road,
Greenwich, London
SE10 9QX
t. 020 8293 5175
bptw.co.uk